

R15269


CERTIFICATE NO. 69453

REC- 100


W. J. L. S. 11

T.7S. R.3W.W.M.

R. W. Hamilton

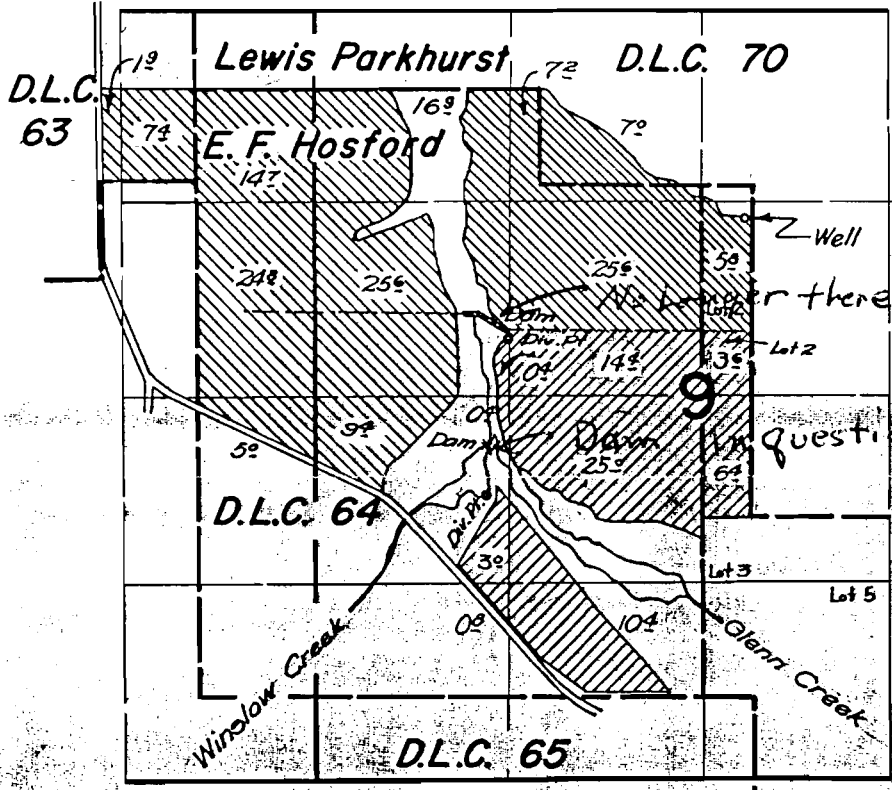

28897
G-667



FINAL PROOF SURVEY UNDER

Application No. **28897** / **G-667** Permit No. **22752** / **G-573**
IN NAME OF

J.G. WATTS dba OAK CREST FARM

Surveyed April 3, 1958, by R.H. Whitby
July 24, 1962, by Carl Baker