


R75270

"CERTIFICATE NO. 69454"

**RECEIVED**

DEC 07 1994

WATER RESOURCES DEPT  
SALEM, OREGON

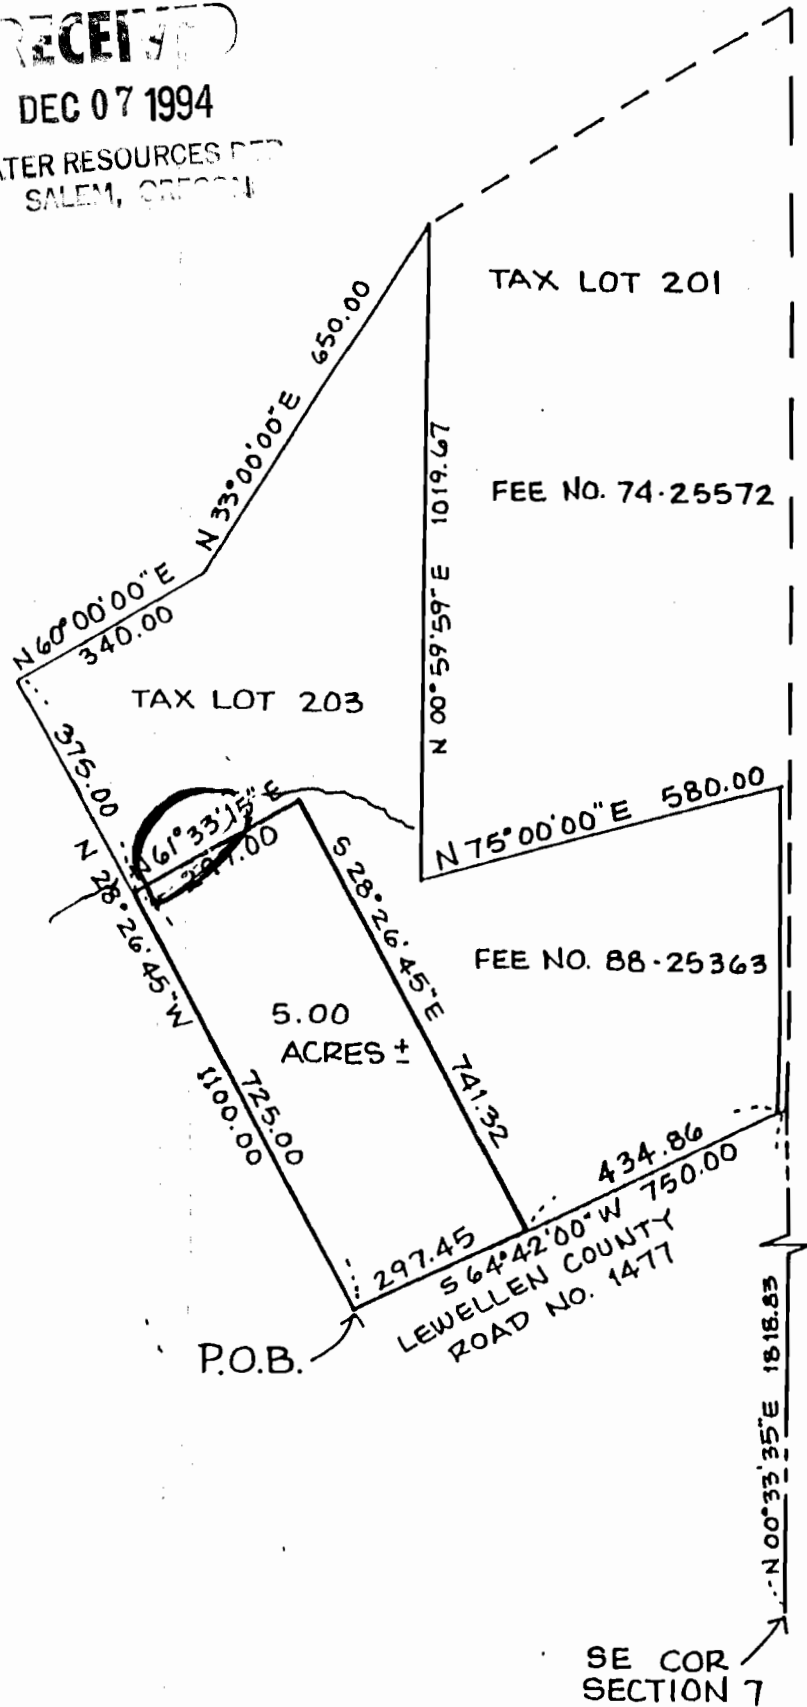

SITUATED IN THE EAST HALF OF SECTION 7,  
TOWNSHIP 4 SOUTH, RANGE 4 EAST, W.M., AND  
BEING A PORTION OF THE ELLISON LEWELLEN  
DLC NO. 40, CLACKAMAS COUNTY, OREGON

VICINITY MAP FOR: JERRY MILSTEAD



**WAKER Associates Inc.**  
CIVIL ENGINEERING  
PLANNING • SURVEYING

11000 S.W. ALLEN BLVD., SUITE 100 / BEAVERTON, OREGON 97005 / 503-843-9410

DRN: BJA

CK'D:

APP'D: DGH

DATE: 12-12-90

SCALE: 1" = 300'

JOB No.: 09029