

SECTION 34 T.27S. R.7W. W.M.
DOUGLAS COUNTY


27 7 34

P WAS PREPARED FOR
MENT PURPOSE ONLY.

1"=400'

RECORD NO. 69463

SEE MAP 27 7 27

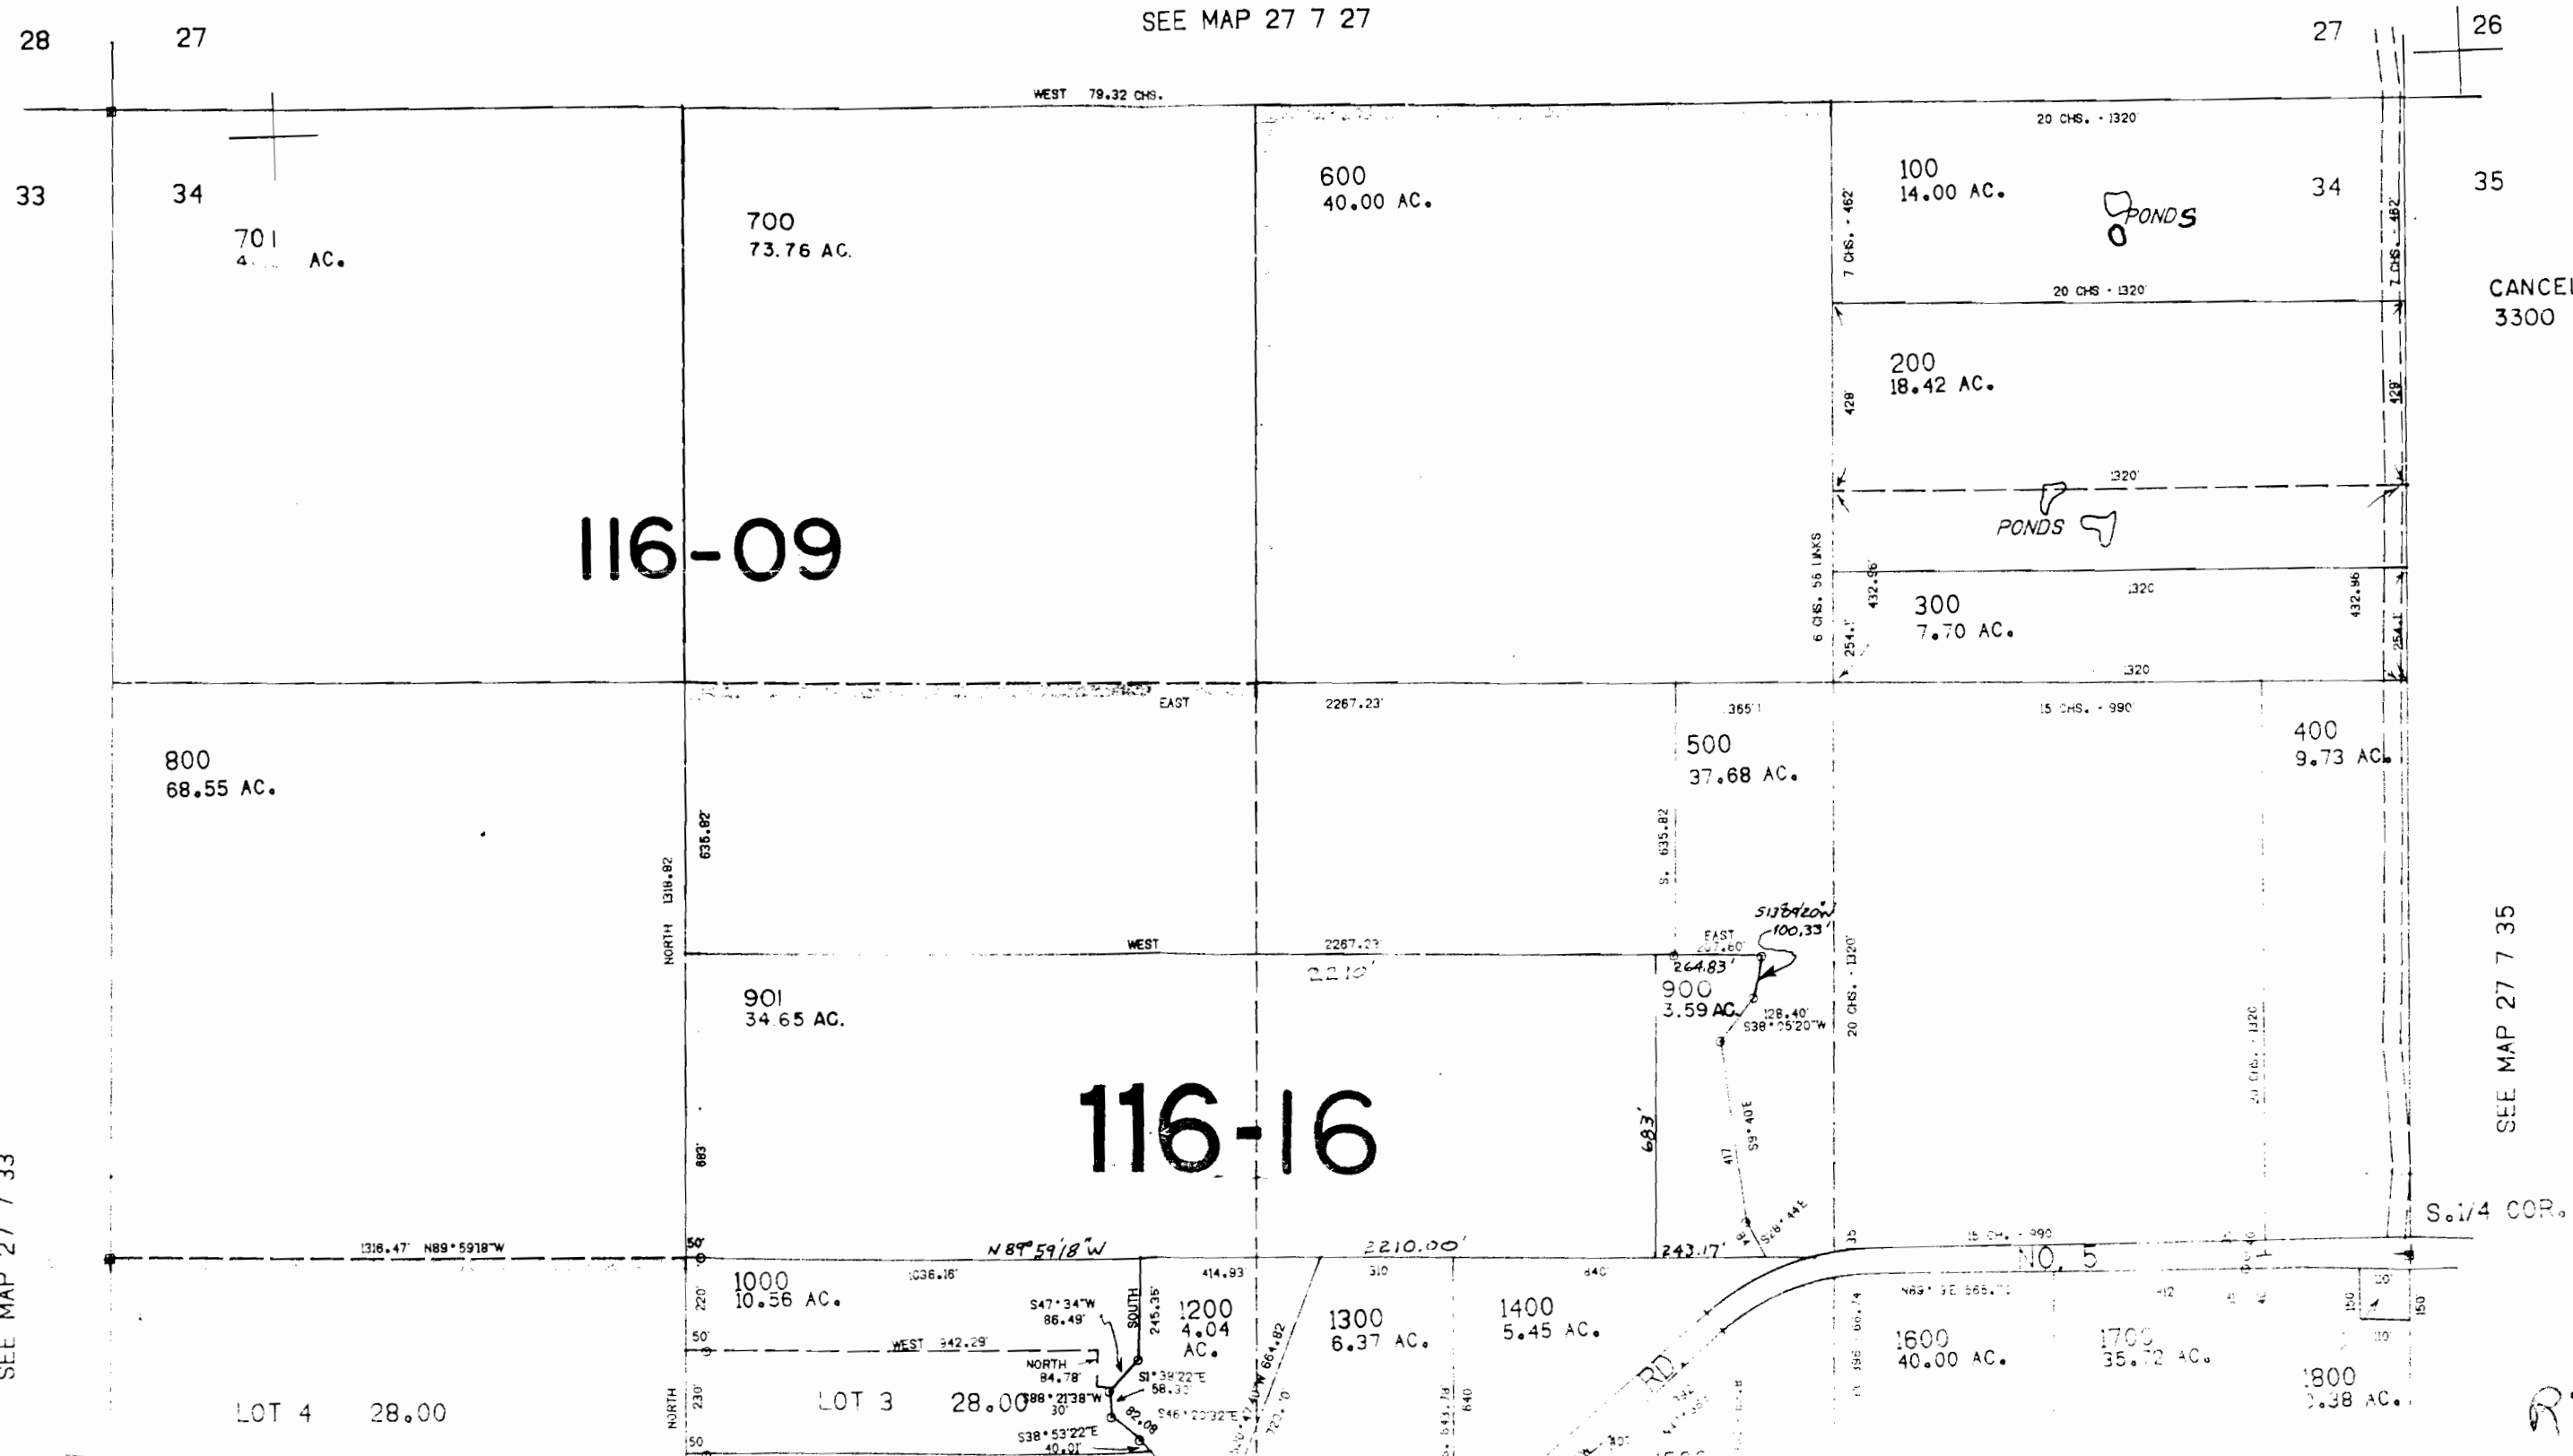

CANCELLED PARCEL NO'S
3300

SEE MAP 27 7 35

SEE MAP 27 7 33

LOT 4 28.00

LOT 3 28.00

R75291