

R6W W.M.

T 2X LOT 10 6

R75302

3.21 ACRES

NTY

69473


CERTIFICATE NO.

DEC - 8 1994

WATER RESOURCES DEPT.  
SALEM, OREGON

6-16

2

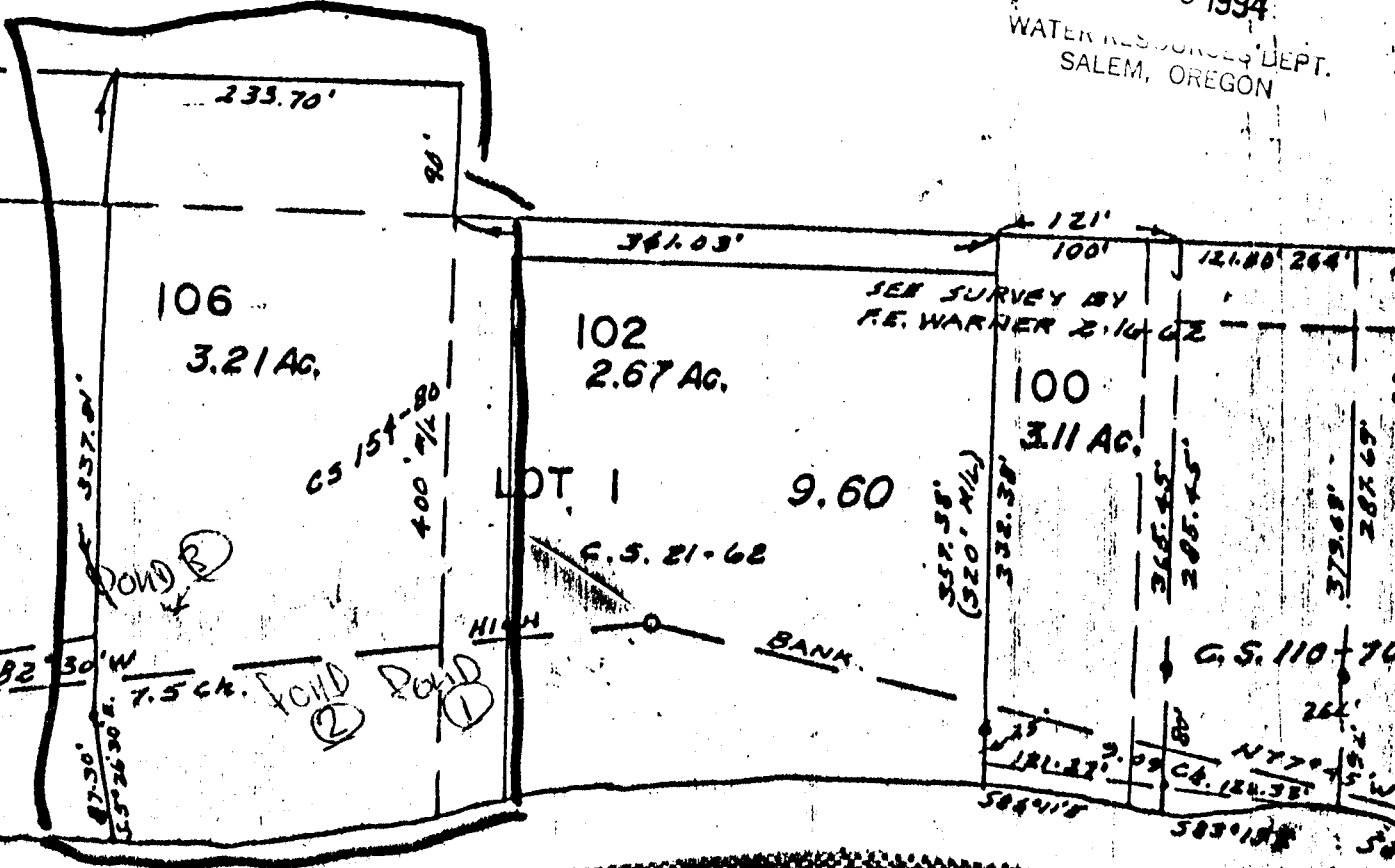

ER

