


IN FIRM WITH PROVISIONS OF
RELEVANT STATUTES ONLY.

CERTIFICATE NO. 69474

21-5

T.11
WALLO
1" = 200'

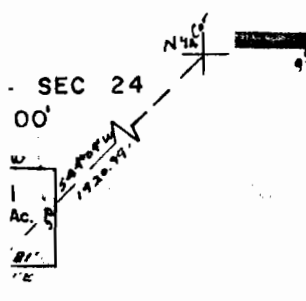


SERT - Sec. 11
1" = 200'




SERT
Sec. 35
1" = 400'


Sec. SW 1/4 NE 1/4 Sec. 35

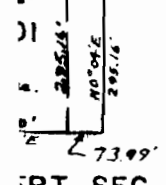


SERT SEC. 14
1" = 400'

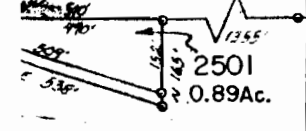

SERT - Sec. 36
1" = 400'

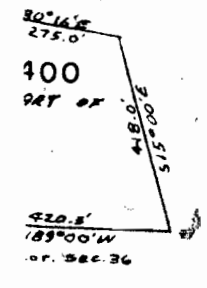

SEE MAP IS 43

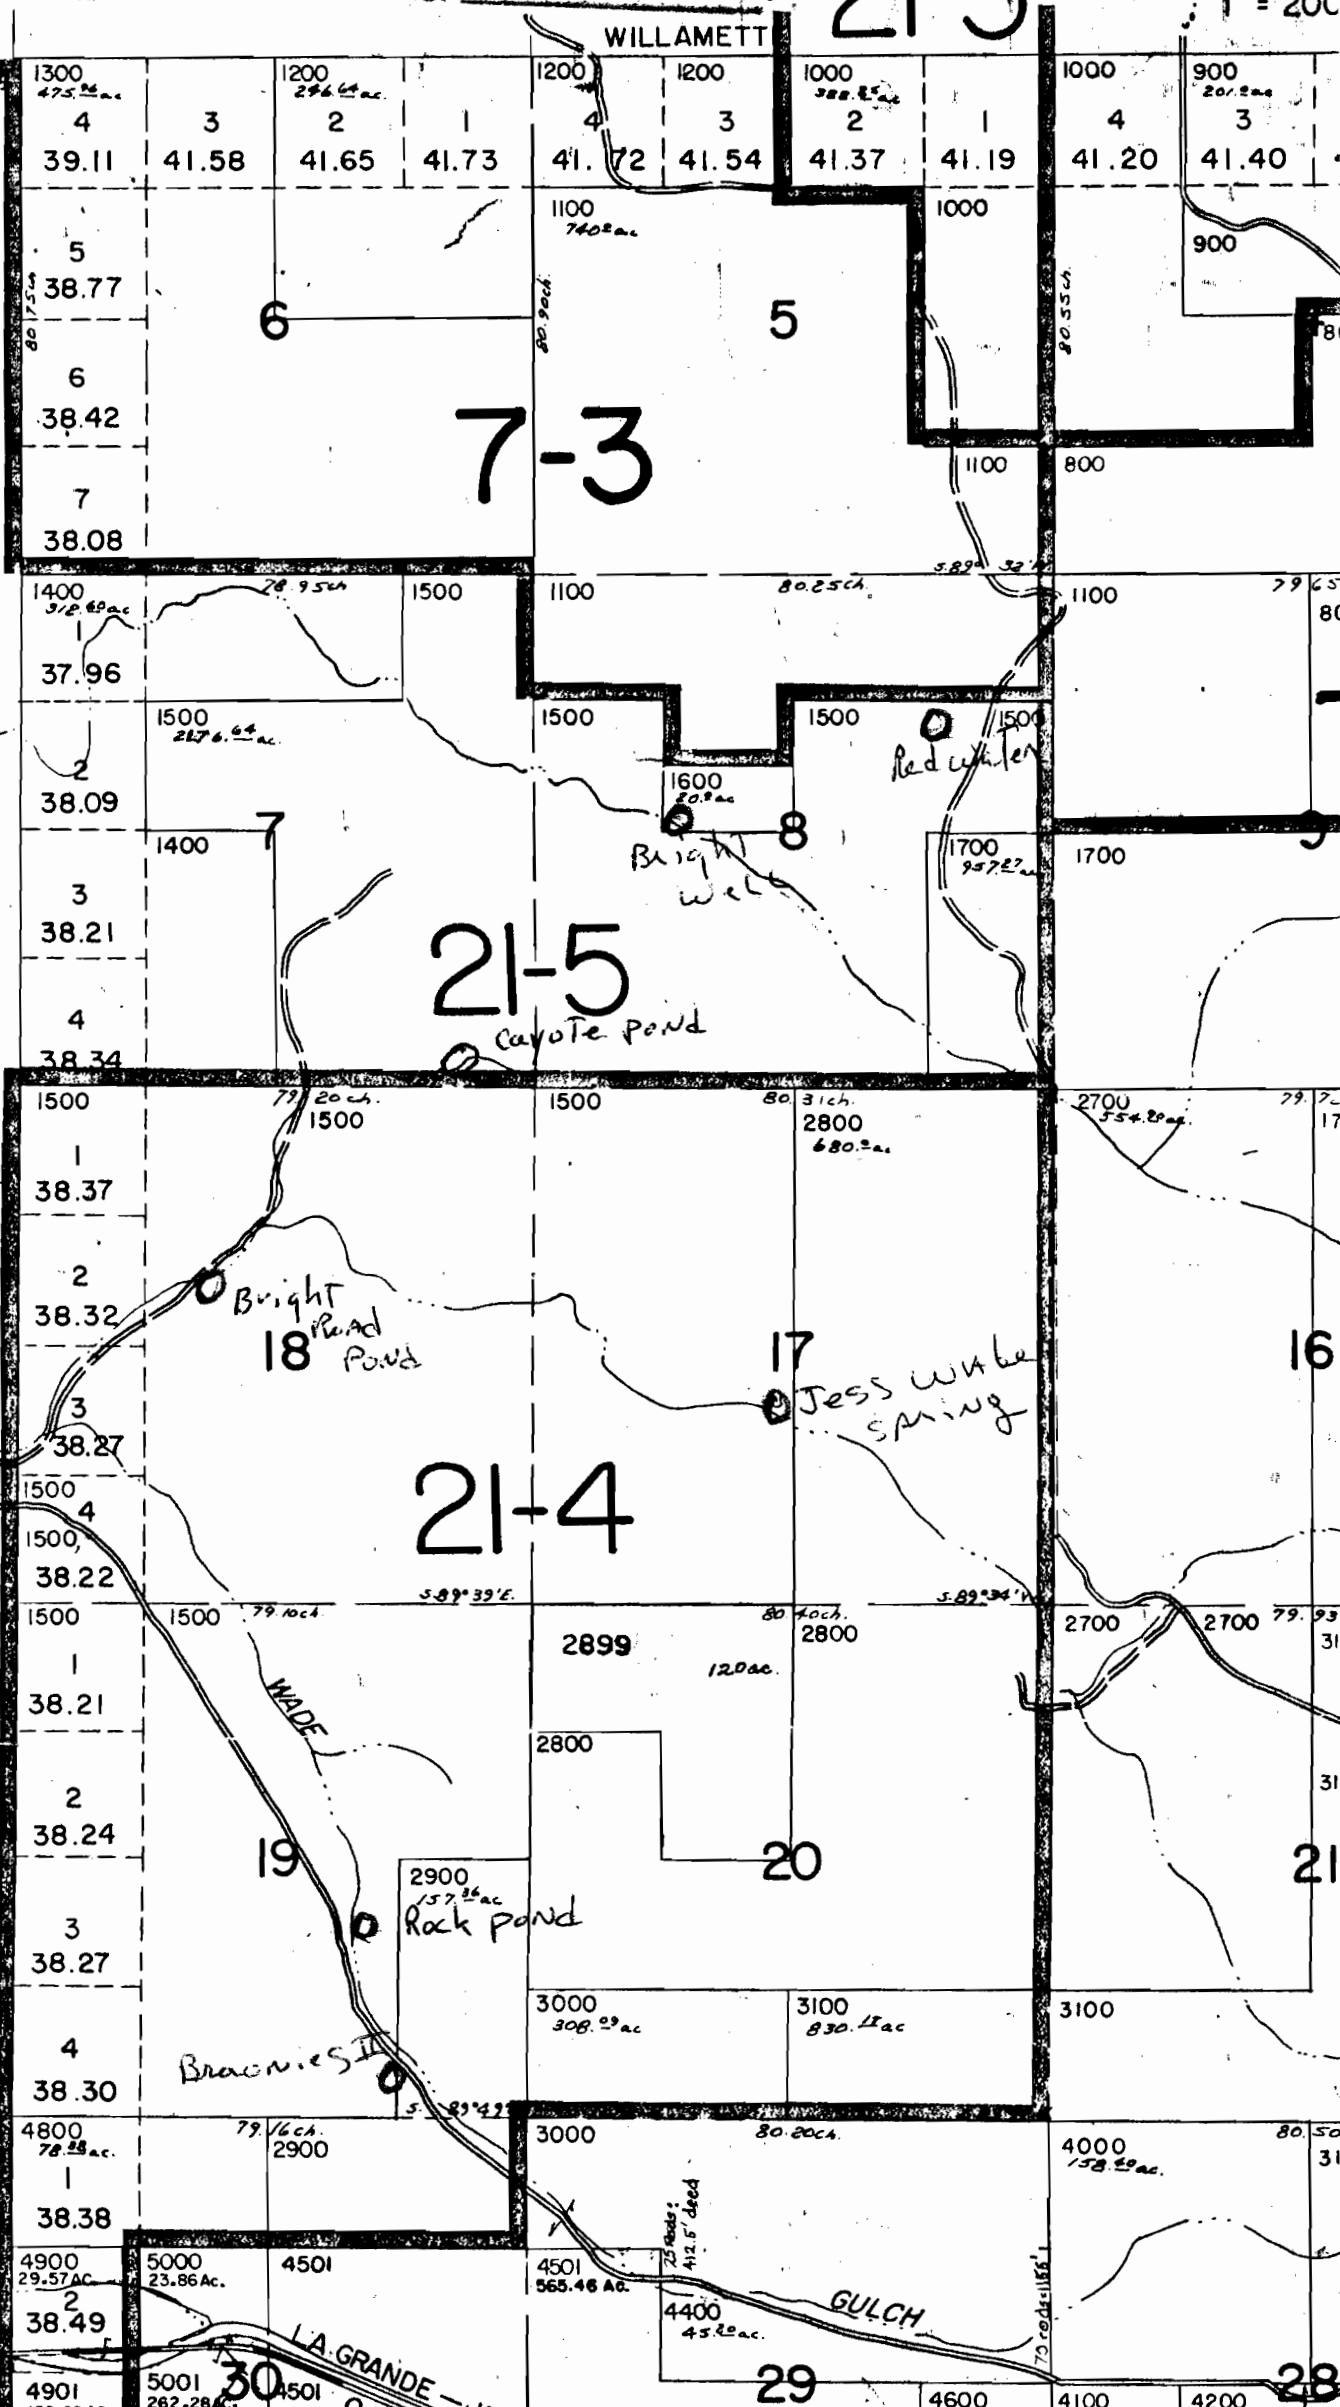

7-3

21-5
Coyote pond

21-4

Bright Road Pond



Rock pond

GULCH

L.A. GRANDE - I.W.A.

CERTIFICATE NO. 69474

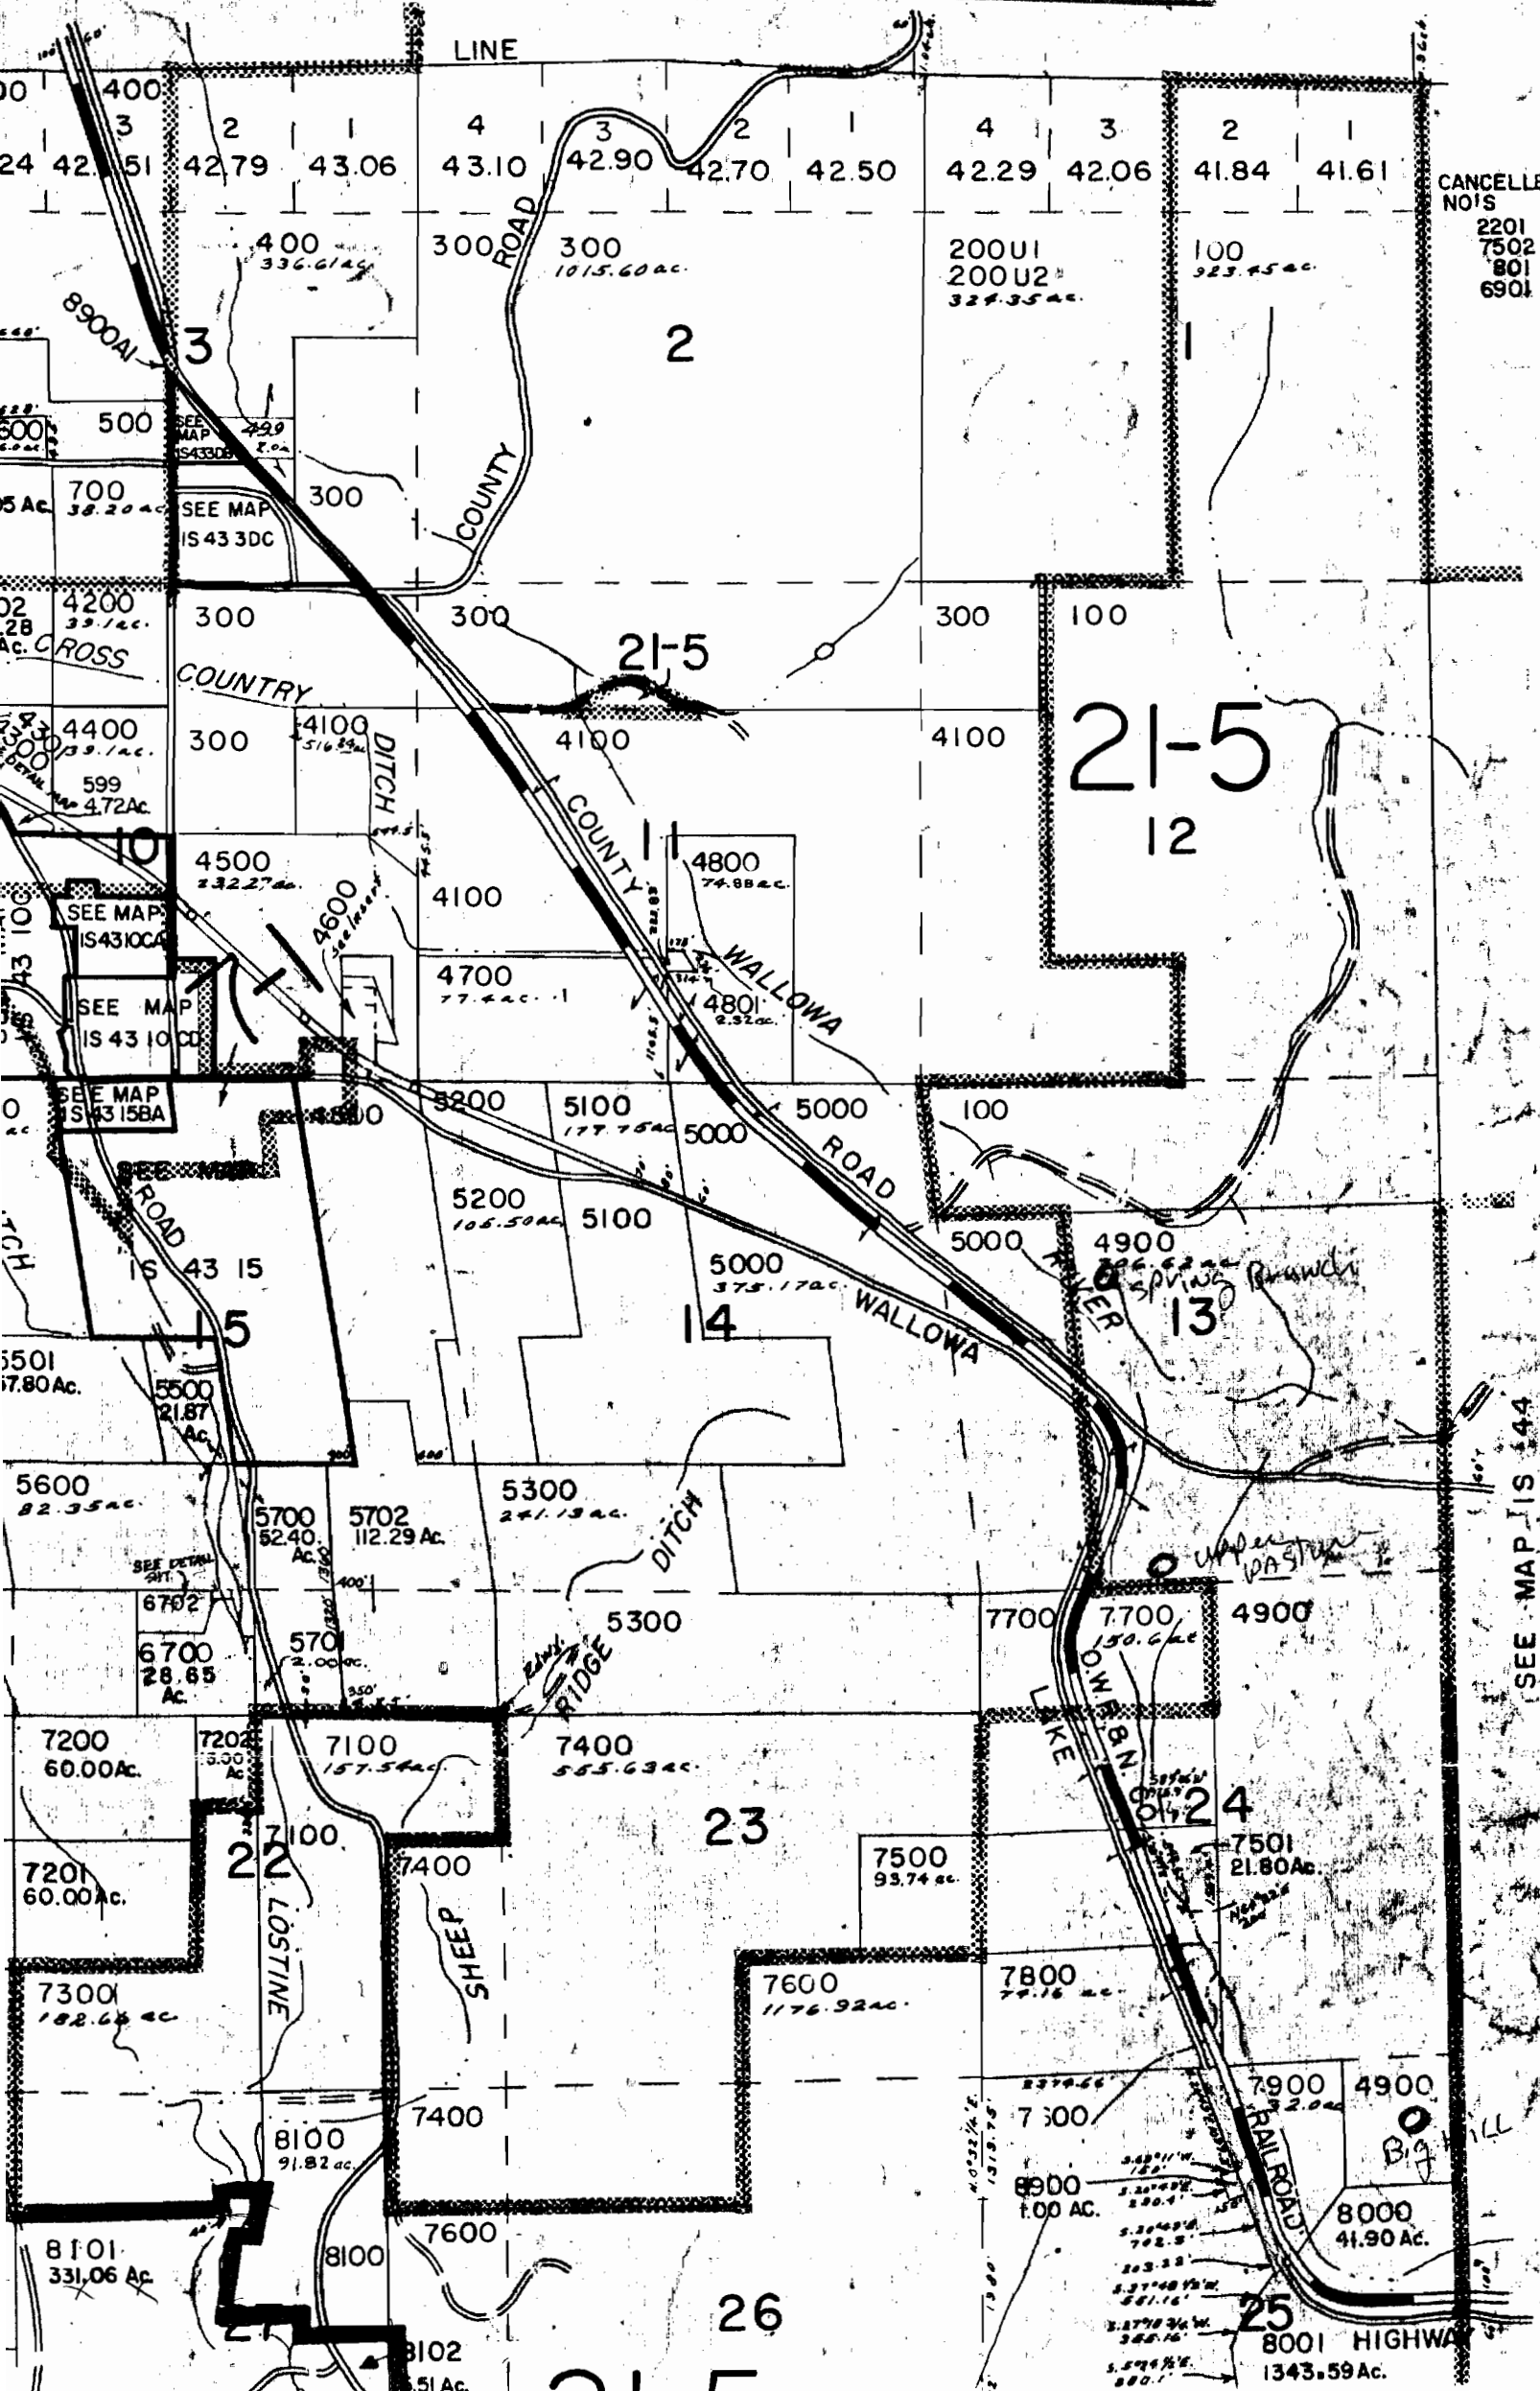

CANCELL NO'S
2201
7502
801
6901

SEE MAP IS 44