

R75304

MASON STEWARD  
DLC 79

23 | 24  
26 | 25

Northwest Corner  
Jonathan Dyer  
DLC No. 77

200  
121.66 AC

CERTIFICATE NO. 69475

100  
168.50 AC

RECEIVED

DEC - 9 1994


WATER RESOURCES DIV  
SALEM, OREGON

CS 4856

21-5

300  
218.23 AC

Southwest Corner  
Jonathan Dyer  
DLC No. 77

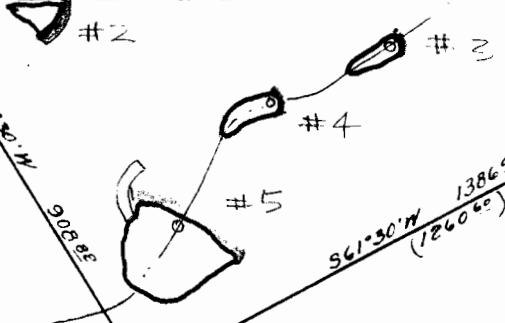

TAX LOT MAP FOR  
LOCATION OF SHAW  
RESERVOIRS # 2, 3, 4, & 5

PREPARED BY  
PAT SCHULTE  
SOIL CONSERVATION SERVICE  
POPK COUNTY

26 | 25  
25 | 26

INT. CL  
DLC 82

Most Green  
DLC A

