RECEIVED
DEC - 9 1994
WATER RESOURCES DEPT
SALEM, OREGON

Application No.

Permit No.

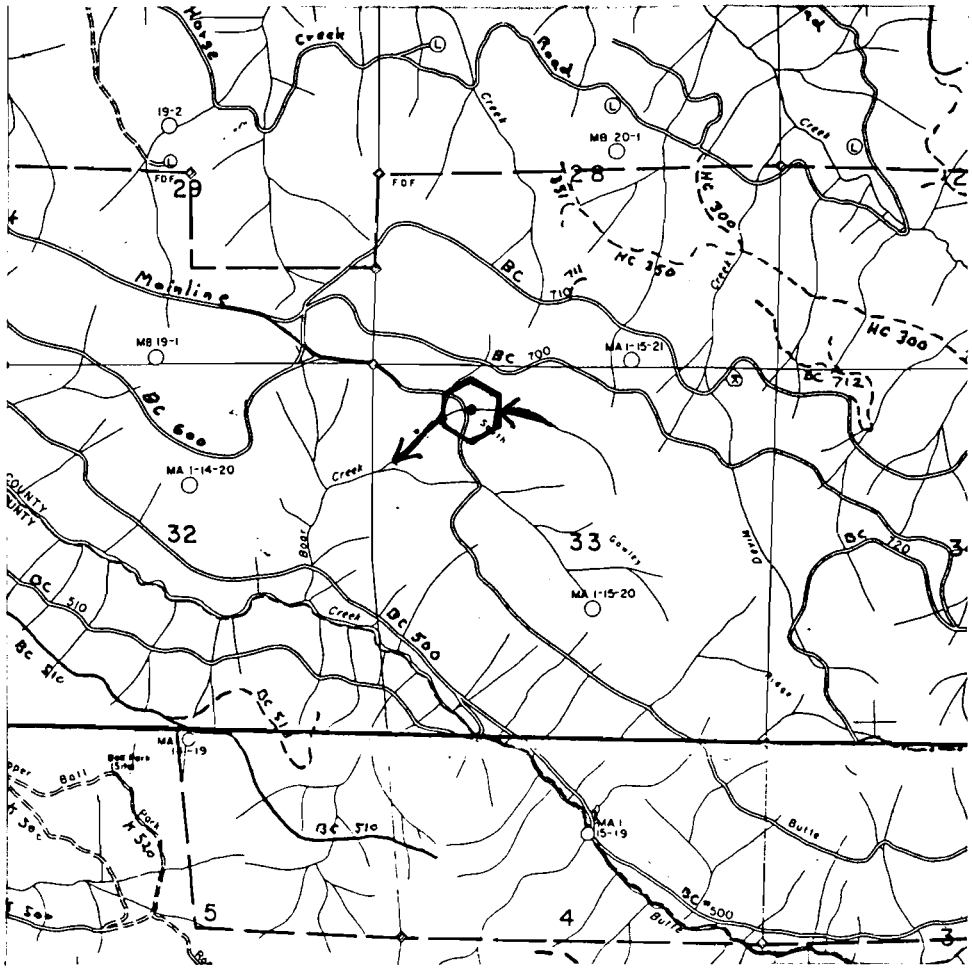

N

Scale 1" = 2 mi.

Butte Creek Mainline Pump Chance NW¼, NW¼, Sec 33, T7S, R3E, W.M.

The point of diversion is approximately 610 ft south and 1240 east of the northwest corner of section 33.

This map is shown for the purpose of water application and not property boundary.

Application No. 75305
Permit No.

"CERTIFICATE NO. 69476"