


HART MOUNTAIN

NATIONAL ANTELOPE REFUGE HB 2153 POND LOCATIONS

UNITED STATES
DEPARTMENT OF THE INTERIOR
GEOLOGICAL SURVEY

JACOBS RESERVOIR QUADRANGLE
OREGON—LAKE CO.
7.5 MINUTE SERIES (TOPOGRAPHIC)

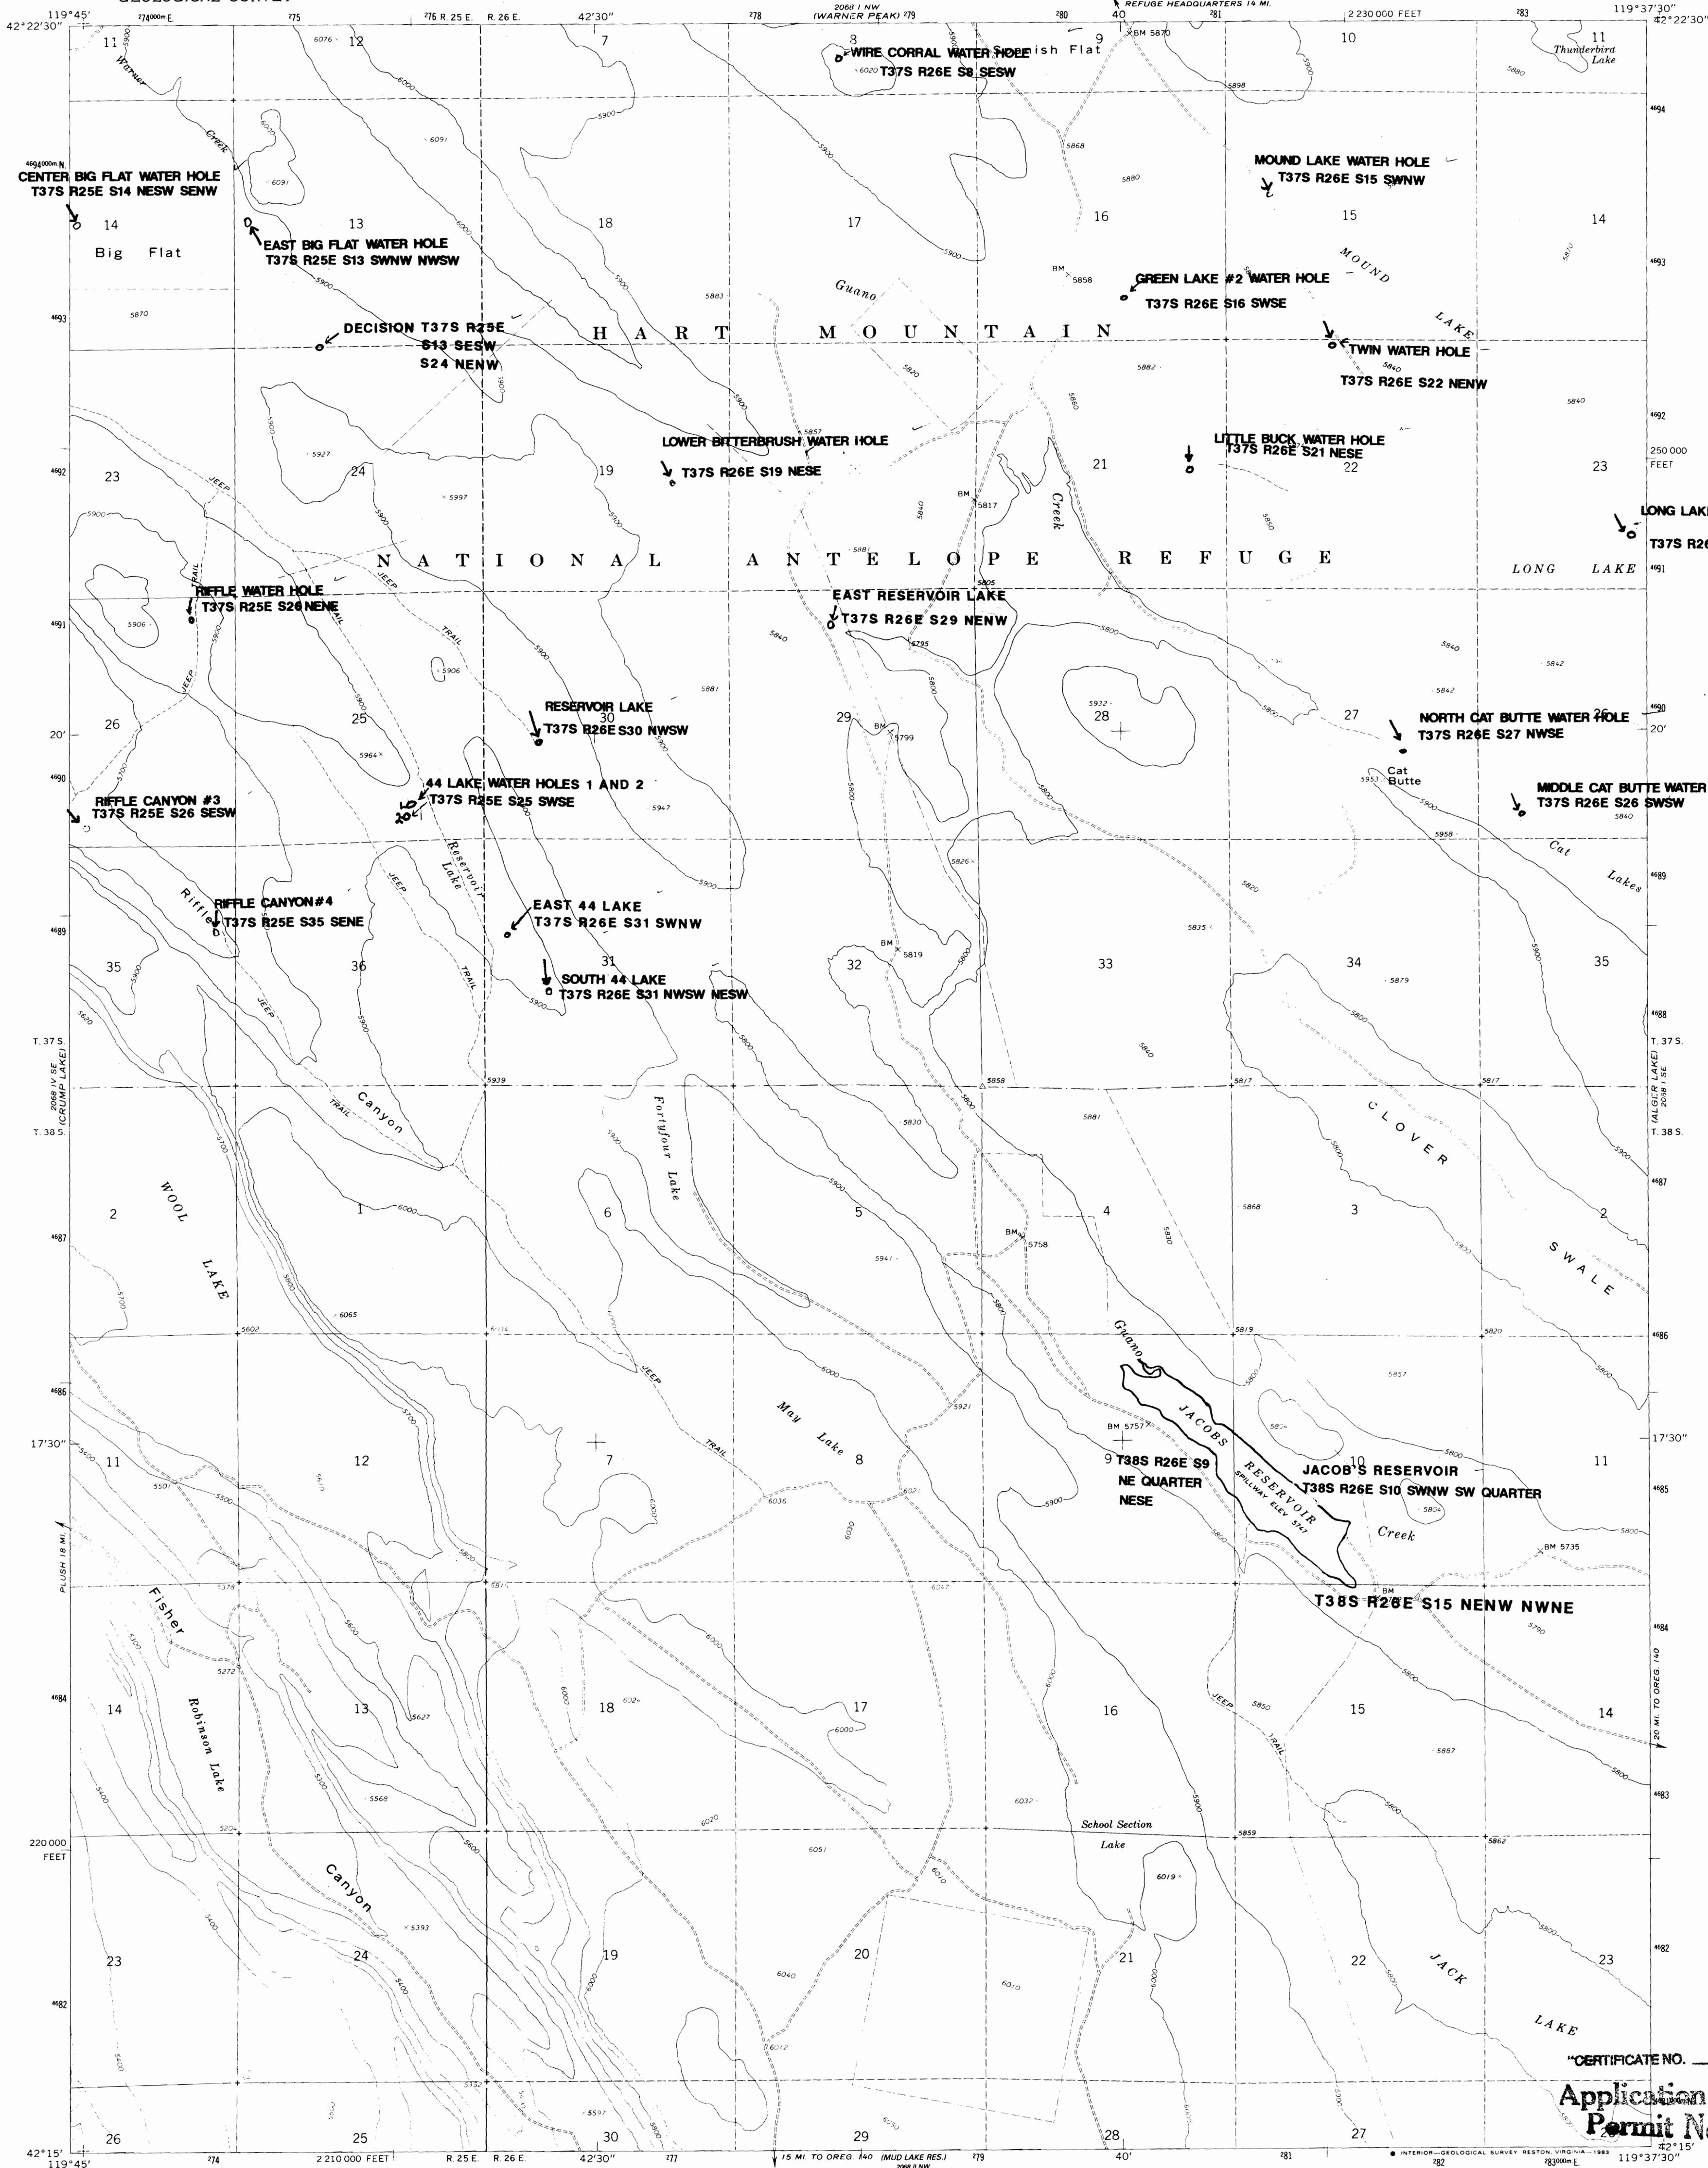

Mapped, edited, and published by the Geological Survey



Control by USGS and USC&GS

Topography by photogrammetric methods from aerial photographs taken 1964. Field checked 1967

Polyconic projection. 1927 North American datum 10,000-foot grid based on Oregon coordinate system, south zone

1000-meter Universal Transverse Mercator grid ticks, zone 11, shown in blue

To place on the predicted North American Datum 1983

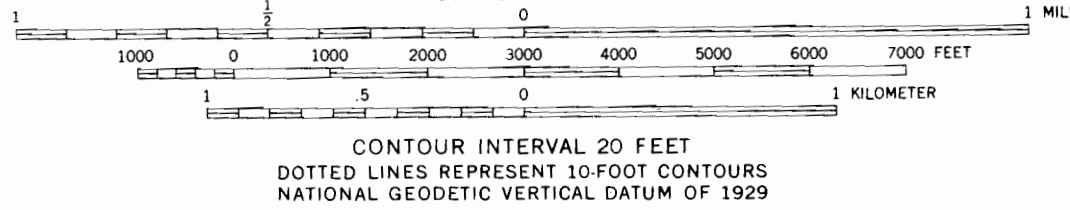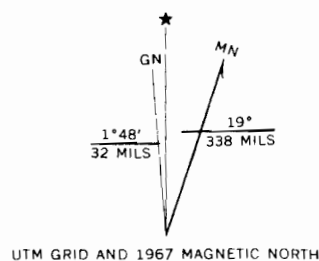

ROAD CLASSIFICATION
Unimproved dirt =-----

CERTIFICATE NO. 69484
Application No. 2-75320
Permit No.

JACOBS RESERVOIR, OREG.