



T9S R3W sec 34

3W 27

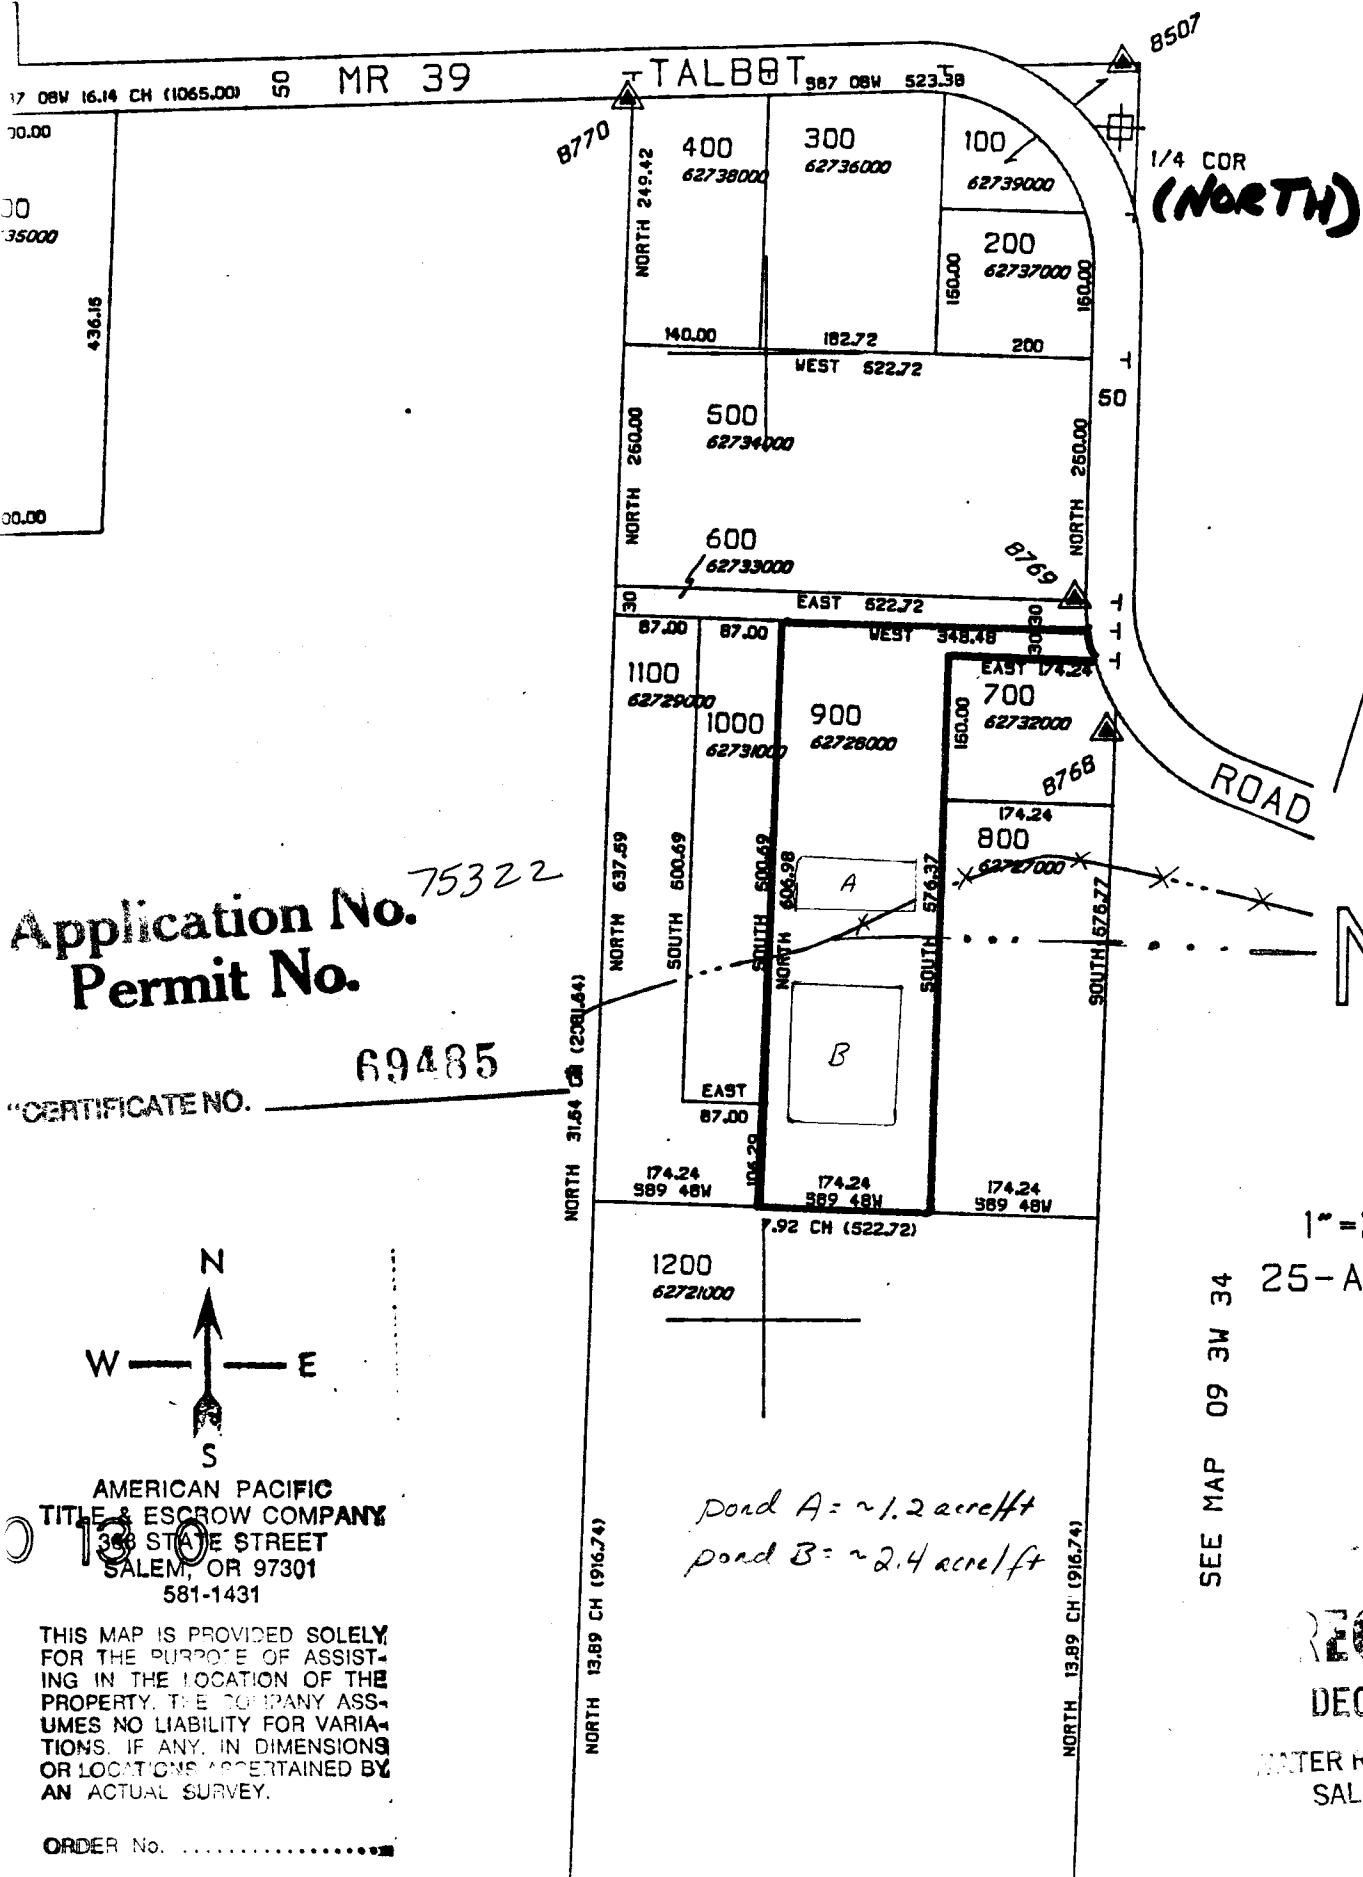

Application No. 75322
 Permit No. _____

"CERTIFICATE NO. 69485"

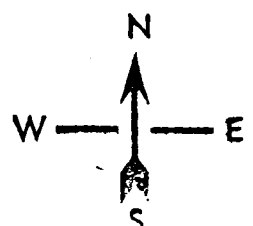

AMERICAN PACIFIC
 TITLE & ESCROW COMPANY
 388 STATE STREET
 SALEM, OR 97301
 581-1431

THIS MAP IS PROVIDED SOLELY
 FOR THE PURPOSE OF ASSISTING
 IN THE LOCATION OF THE
 PROPERTY. THE COMPANY ASSUMES
 NO LIABILITY FOR VARIATIONS,
 IF ANY, IN DIMENSIONS OR
 LOCATIONS ASCERTAINED BY
 AN ACTUAL SURVEY.

ORDER No.

*Pond A: ~1.2 acre/ft
 Pond B: ~2.4 acre/ft*

SEE MAP 09 3W 34

1" = 200'
 25-APR-90

RECEIVED

DEC - 9 1994

WATER RESOURCES DEPT
 SALEM, OREGON