





UNITED STATES
DEPARTMENT OF THE INTERIOR
GEOLOGICAL SURVEY

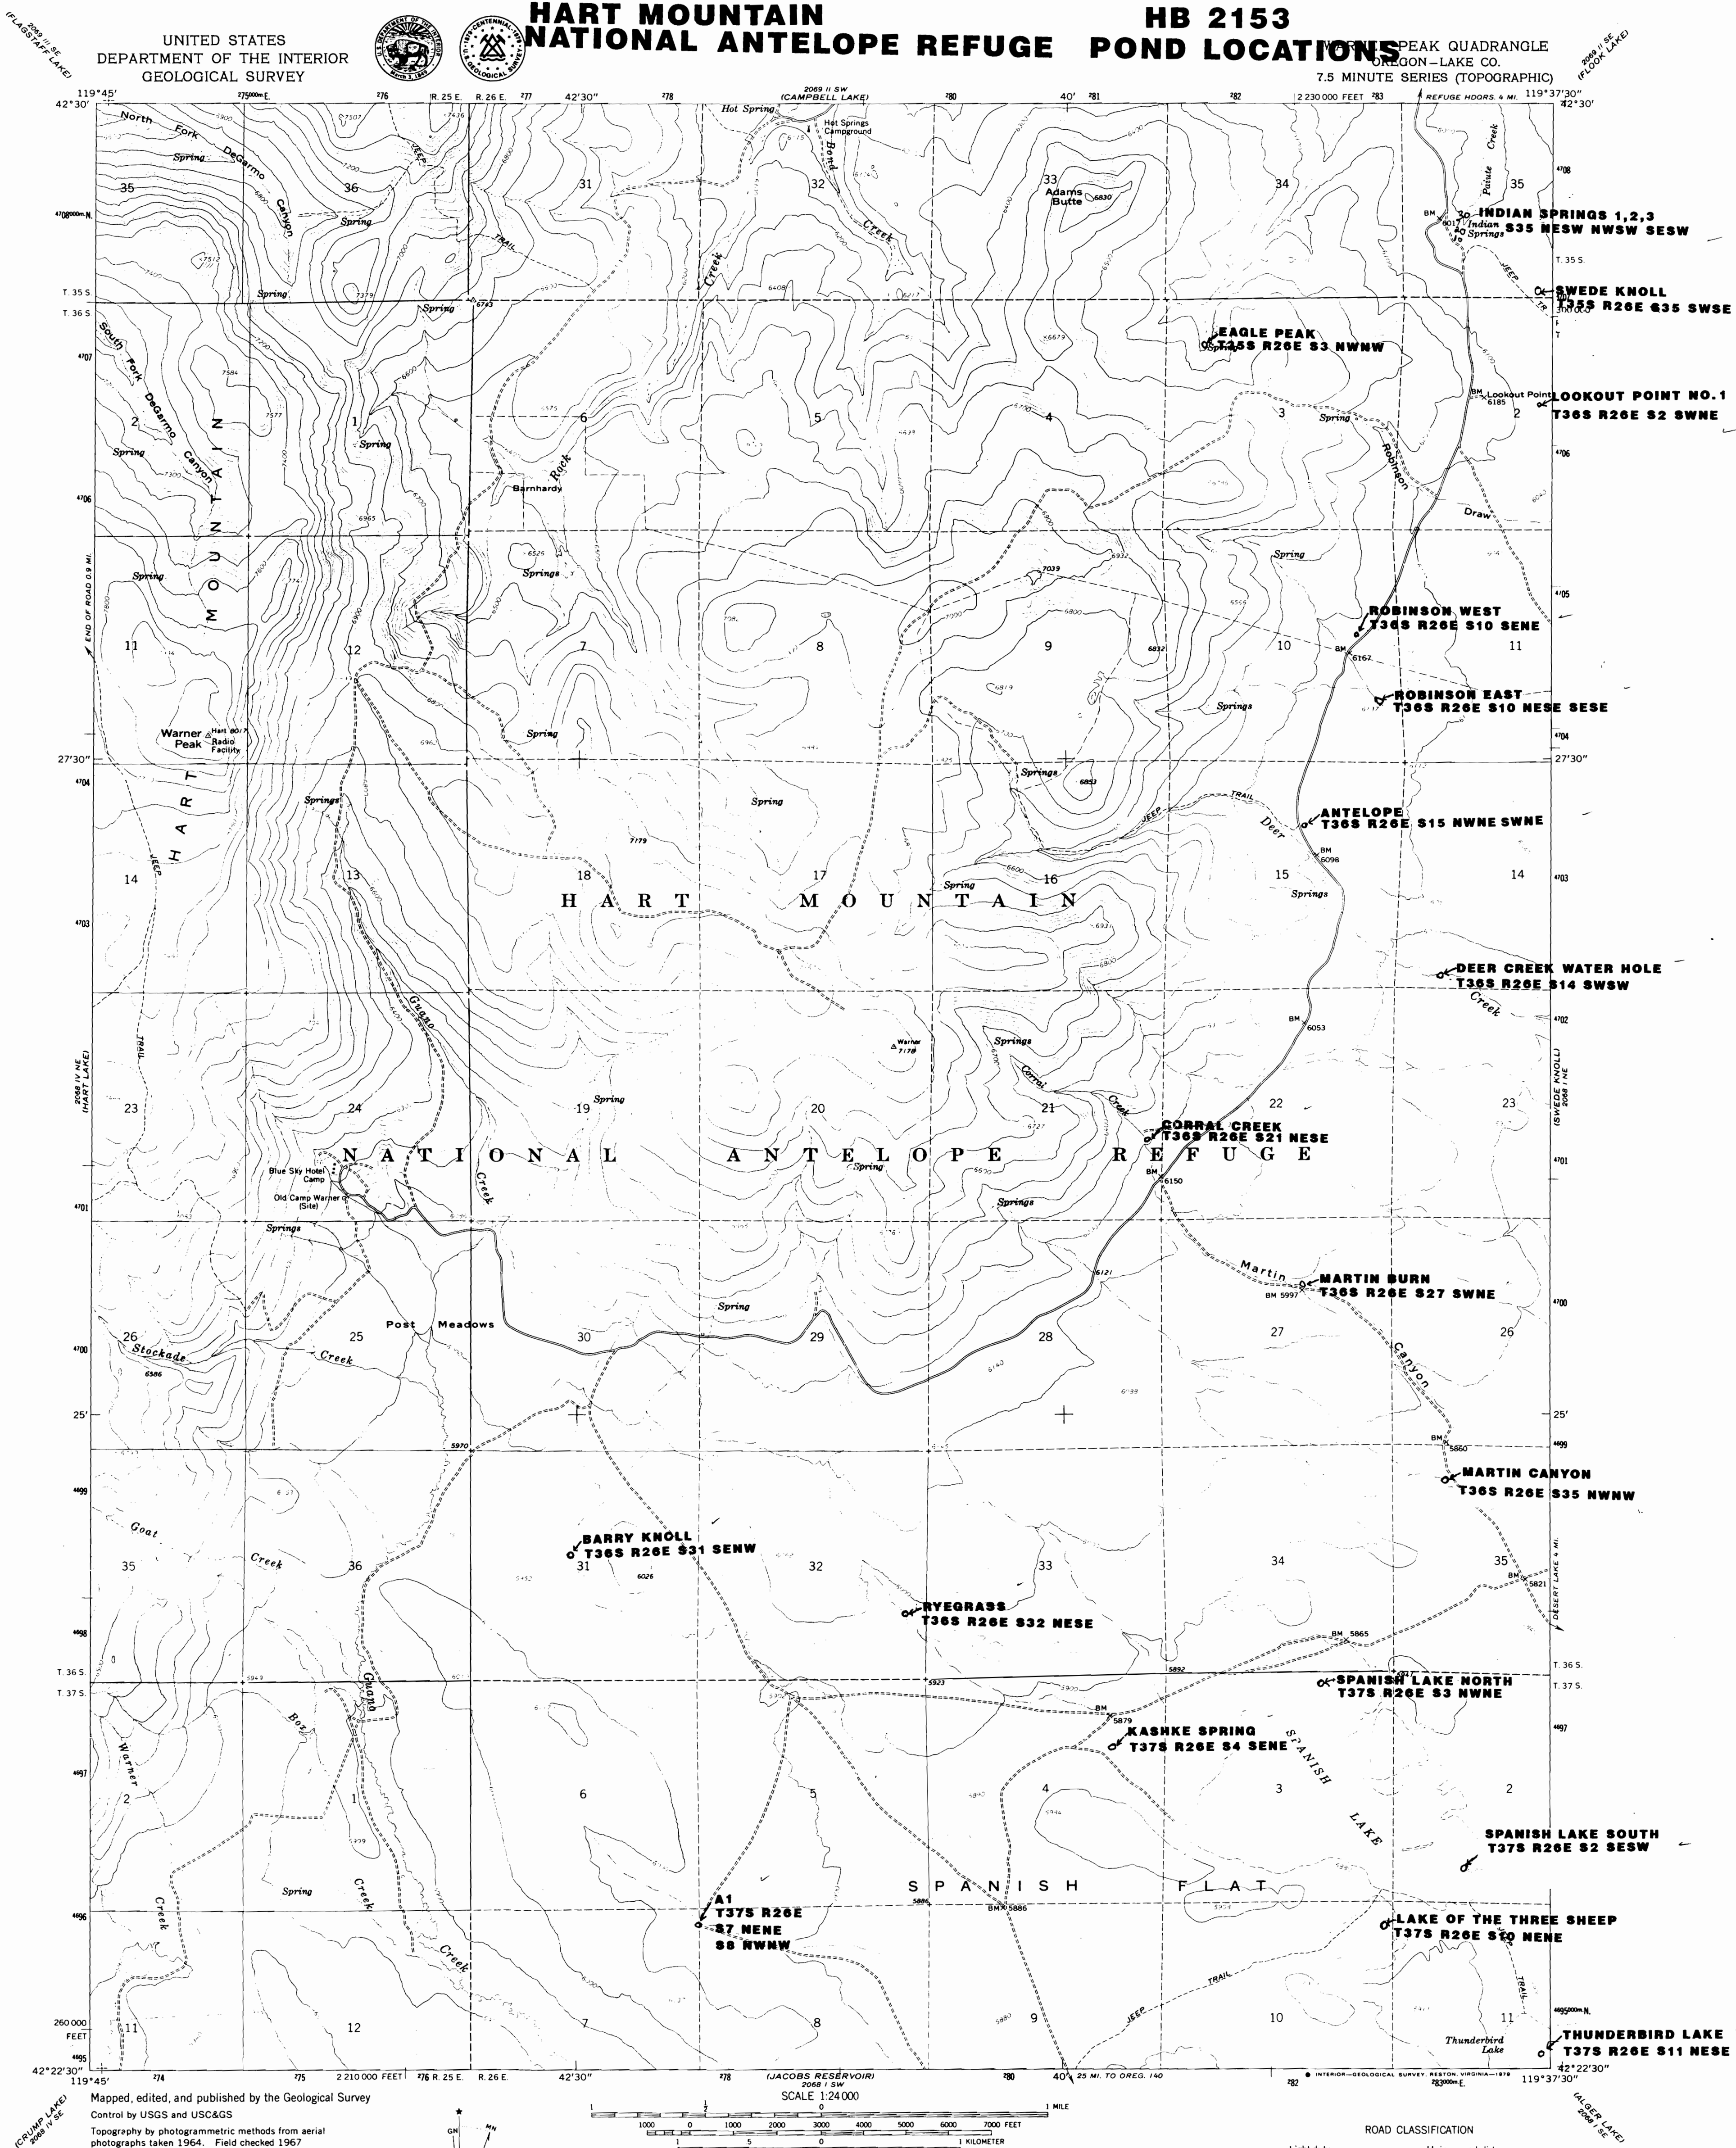

HART MOUNTAIN NATIONAL ANTELOPE REFUGE

HB 2153 POND LOCATIONS

OREGON-LAKE CO.
7.5 MINUTE SERIES (TOPOGRAPHIC)


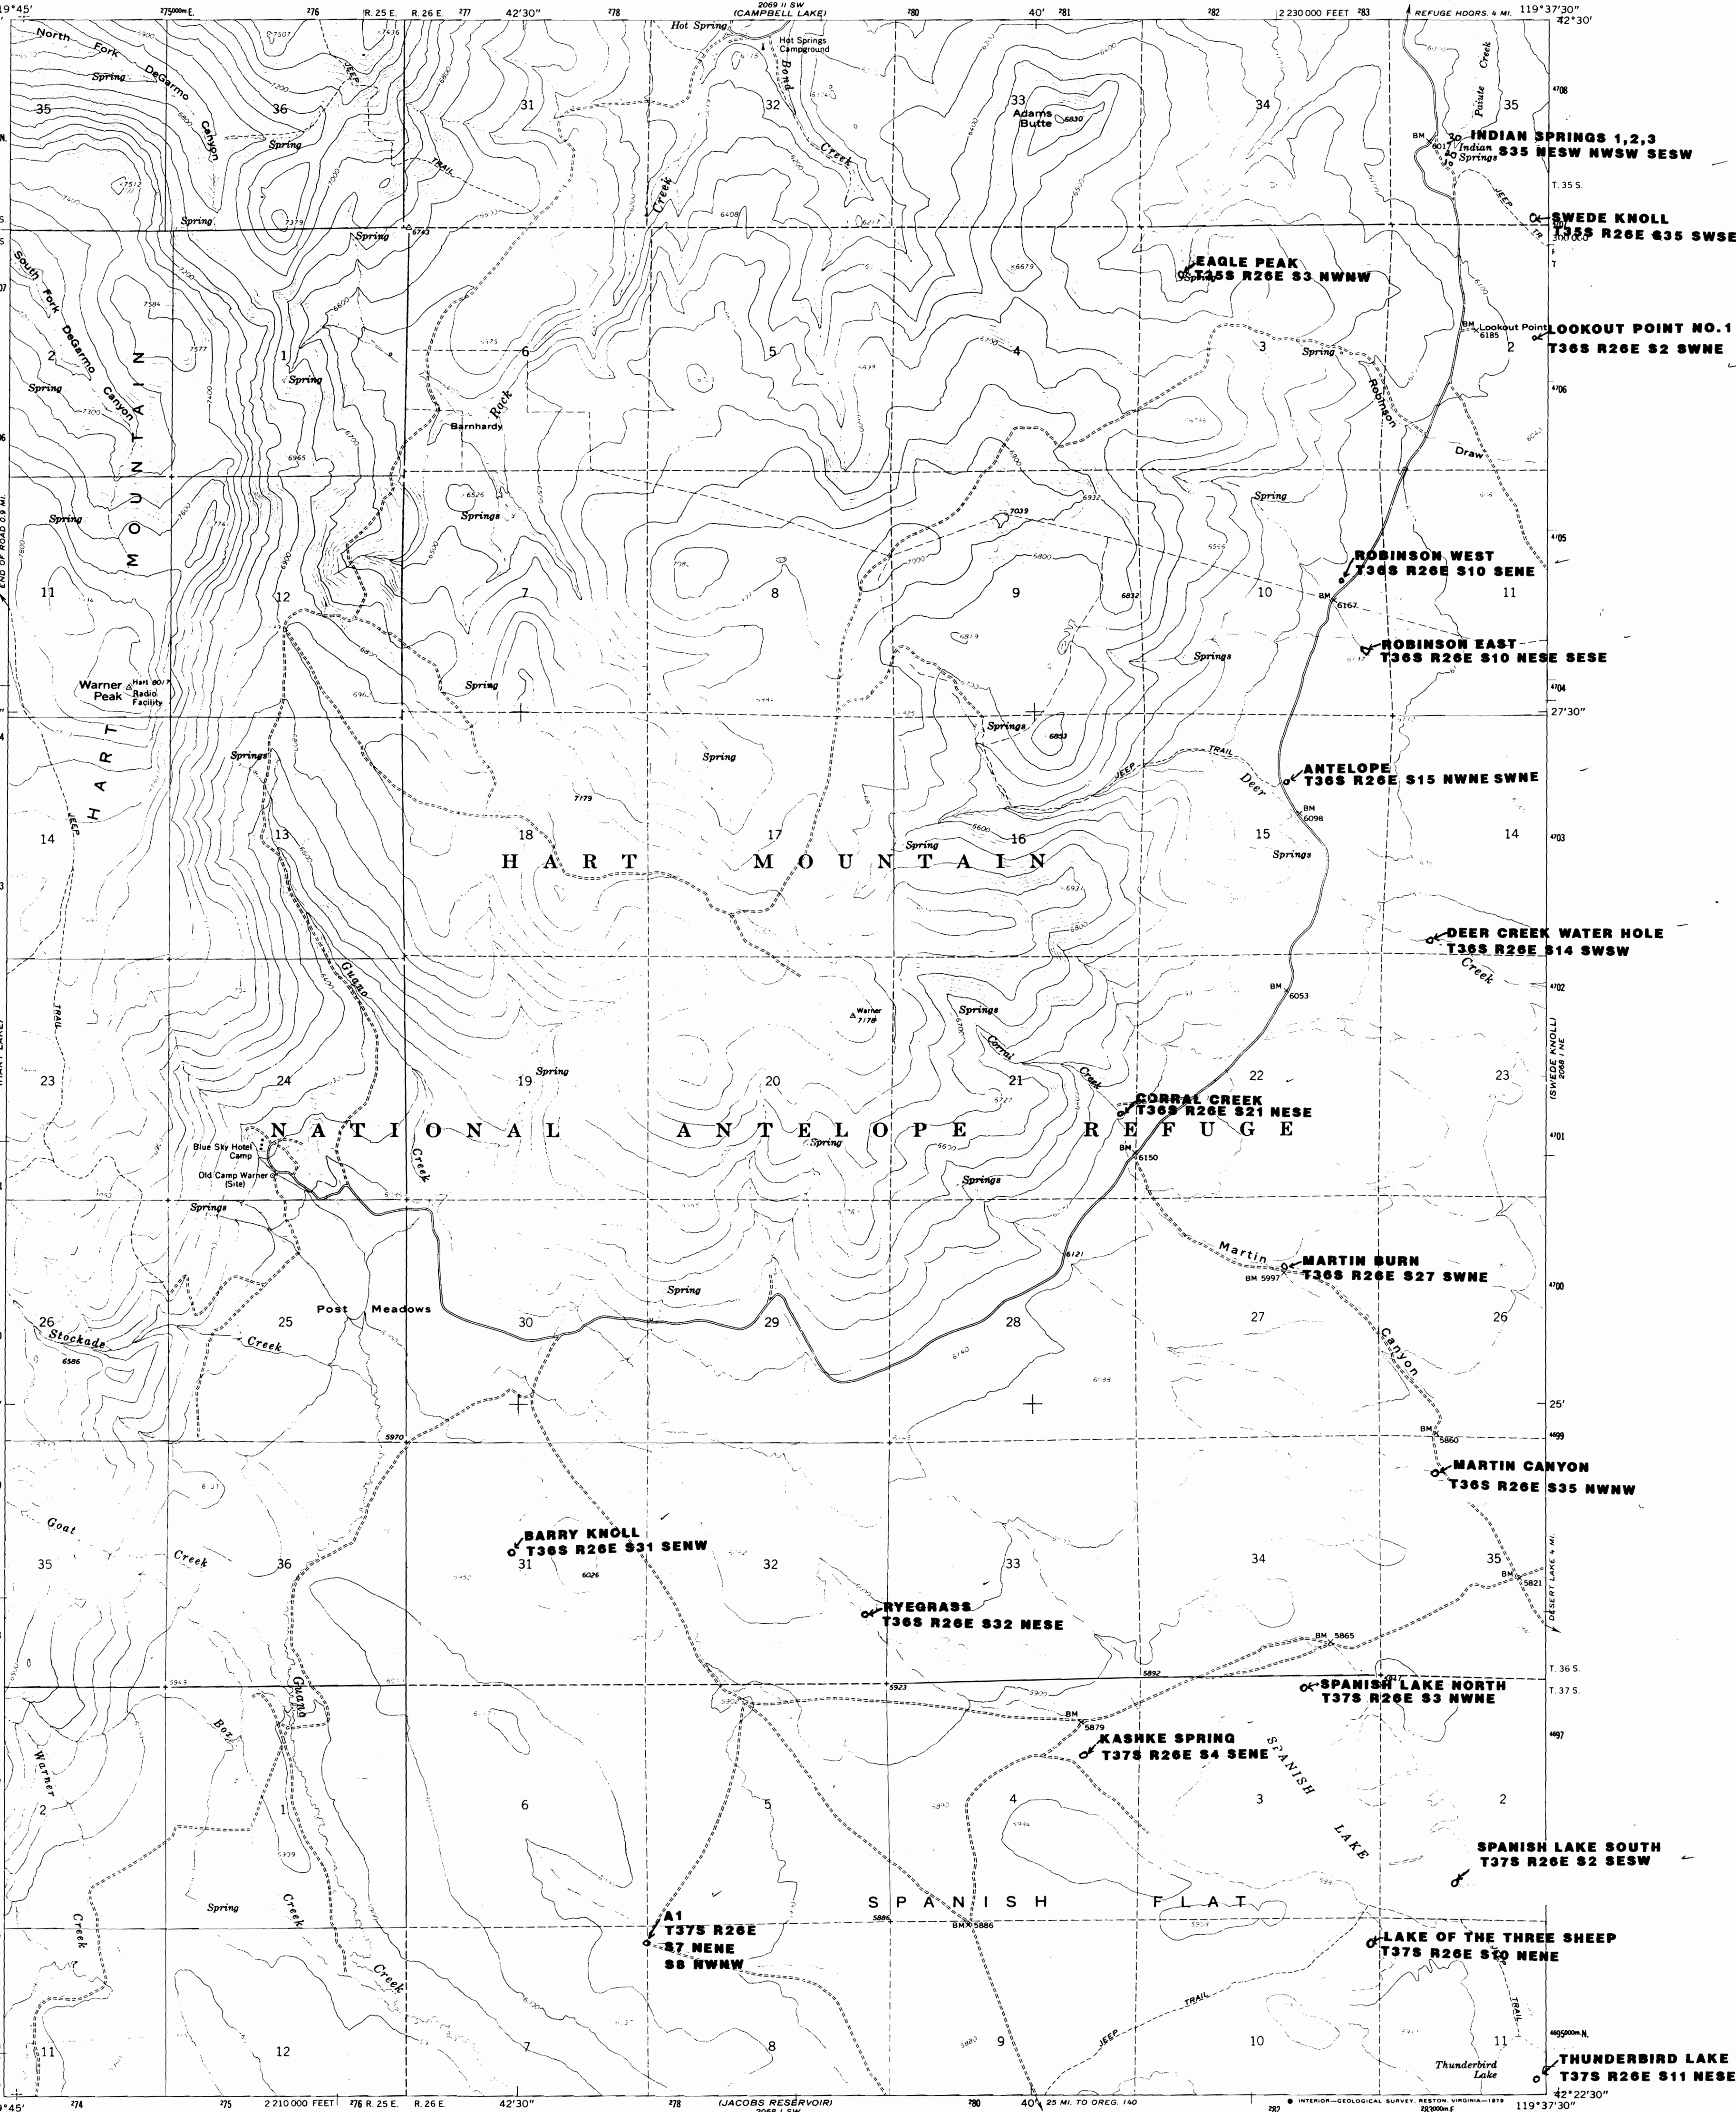


Mapped, edited, and published by the Geological Survey

Control by USGS and USC&GS

Topography by photogrammetric methods from aerial
photographs taken 1964. Field checked 1967

Polyconic projection. 1927 North American datum
10,000-foot grid based on Oregon coordinate system.

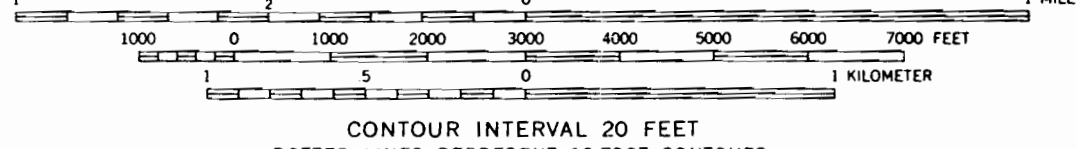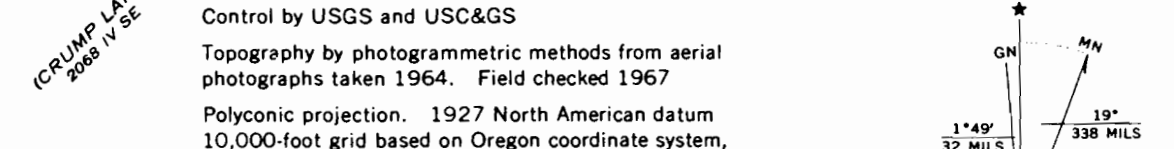

ROAD CLASSIFICATION
Light duty ————— Unimproved dirt —————