

2069 11 SE LAKE
(FLAGSTAFF LAKE)

UNITED STATES
DEPARTMENT OF THE INTERIOR
GEOLOGICAL SURVEY




HART MOUNTAIN NATIONAL ANTELOPE REFUGE

HB 2153 POND LOCATIONS

LEAGUE PEAK QUADRANGLE
OREGON-LAKE CO.
7.5 MINUTE SERIES (TOPOGRAPHIC)

2069 11 SE LAKE
(FLOOD LAKE)

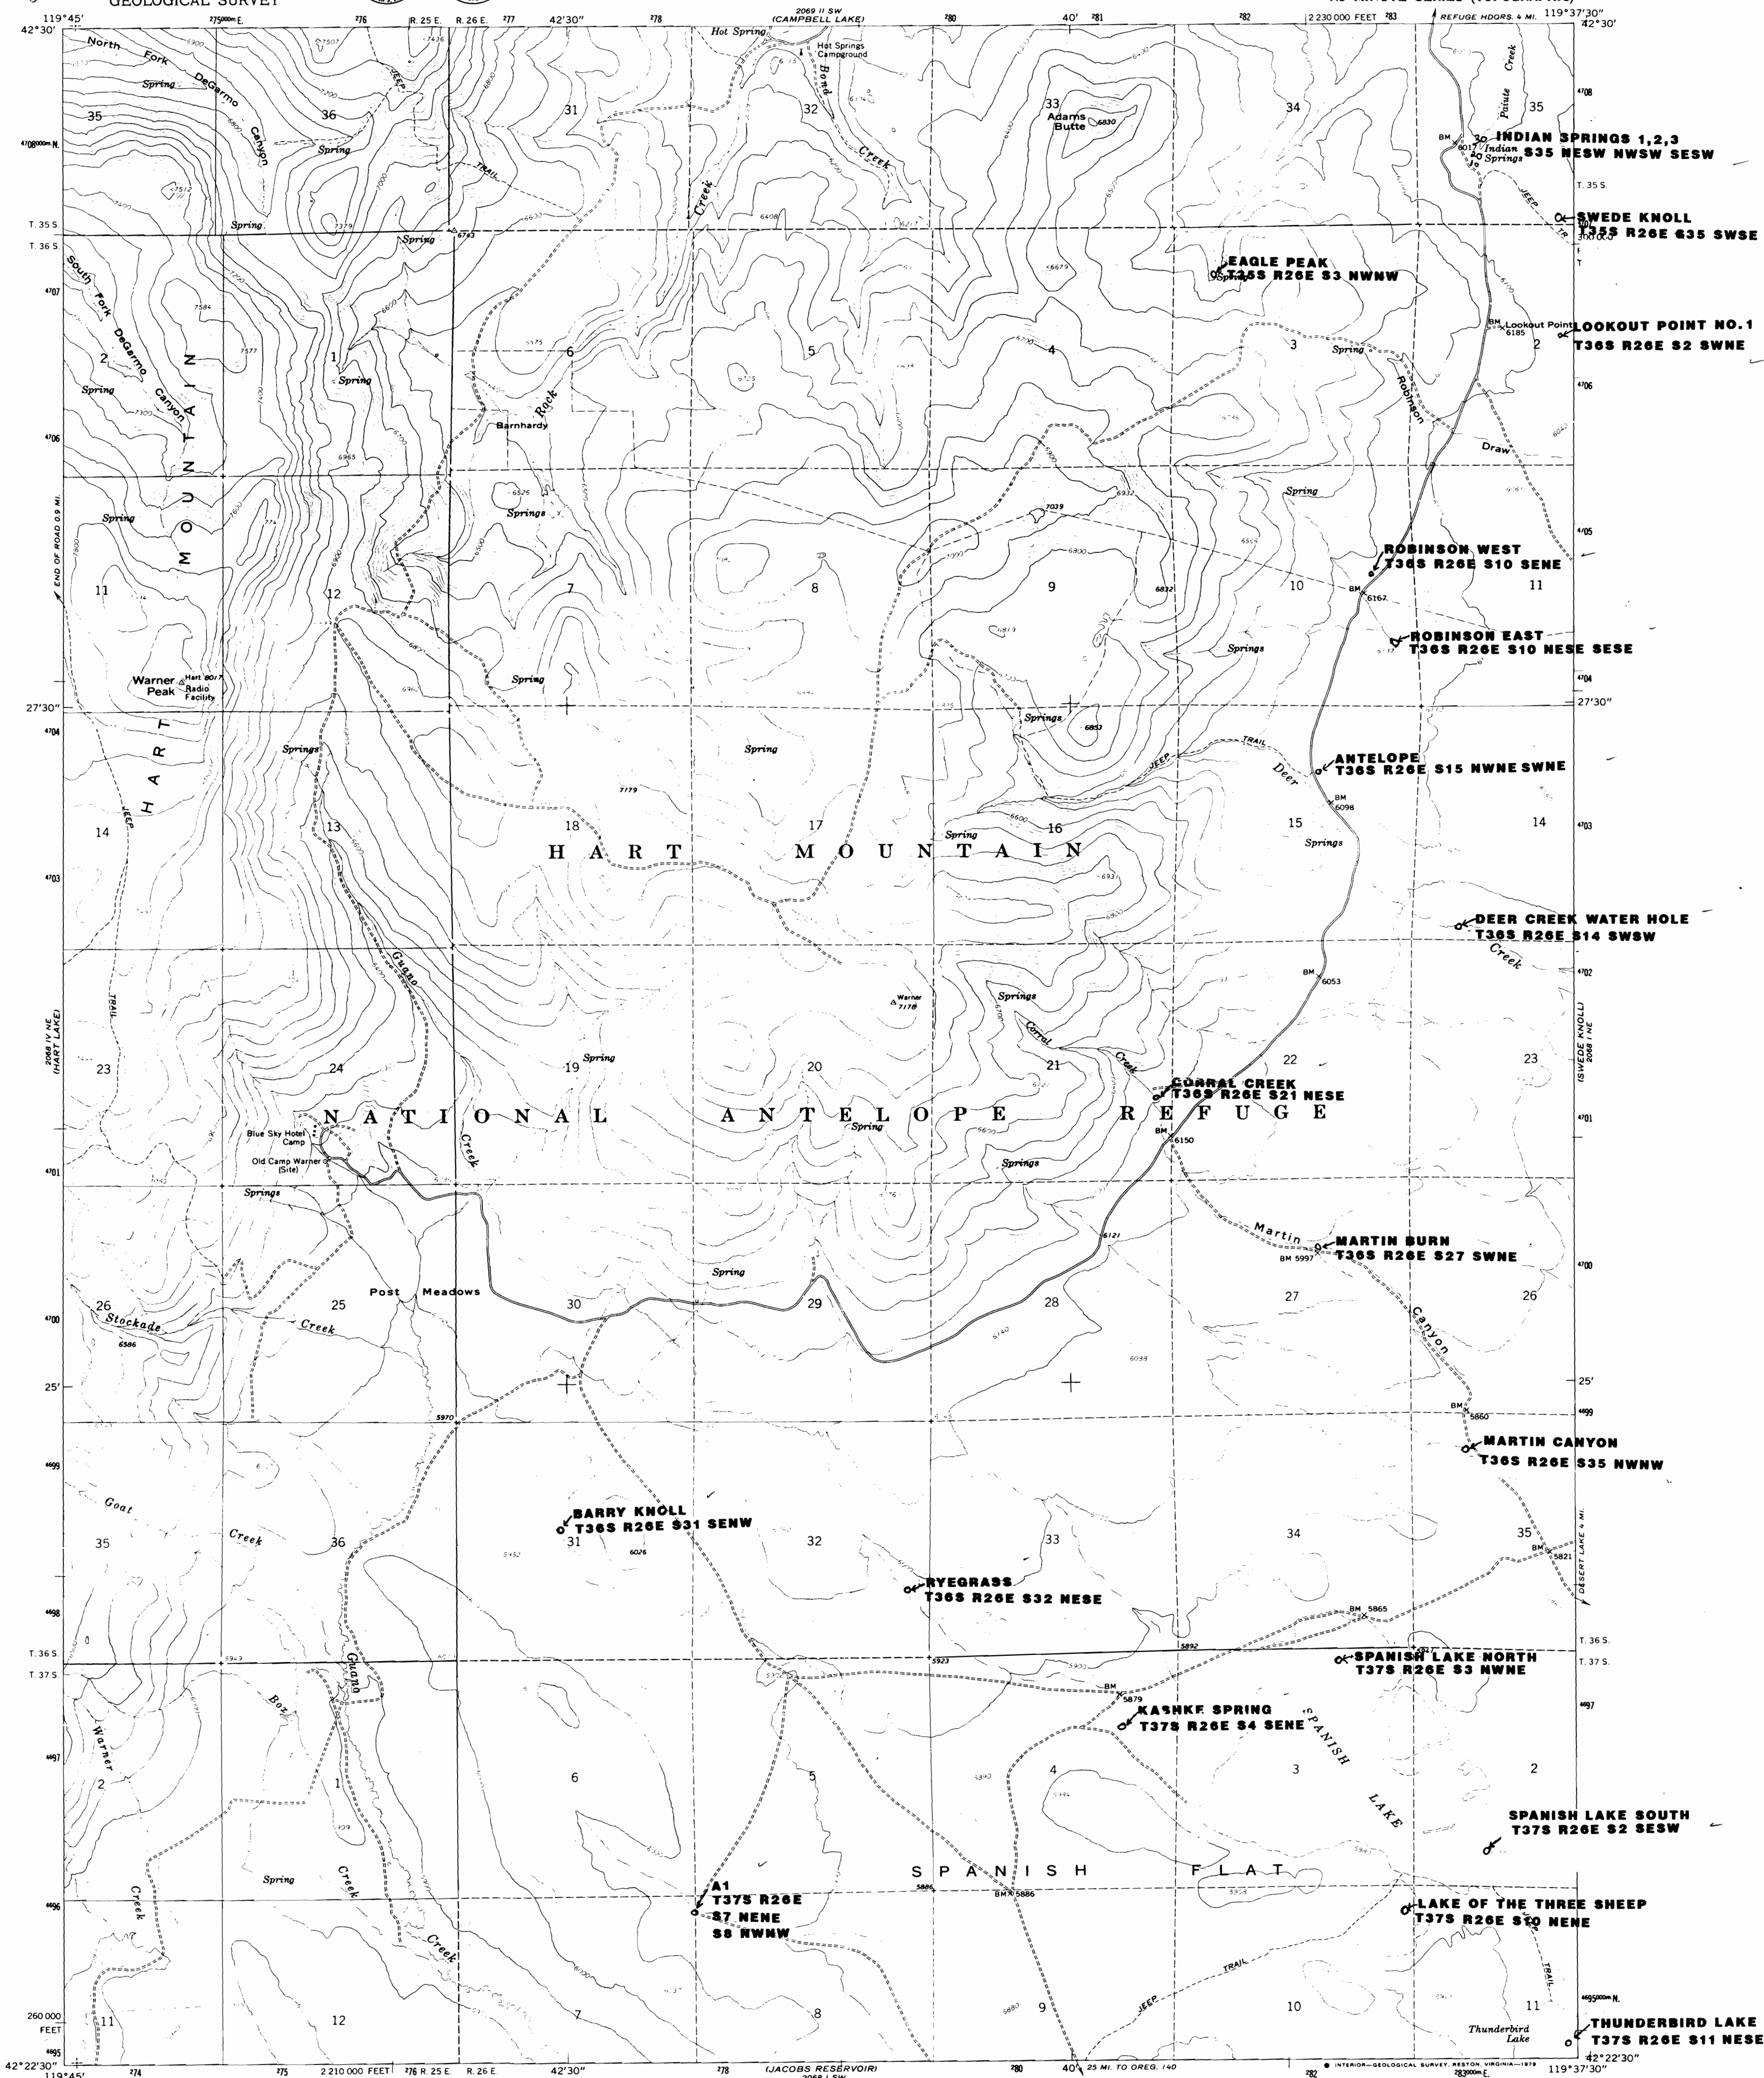


Mapped, edited, and published by the Geological Survey

Control by USGS and USC&GS

Topography by photogrammetric methods from aerial
photographs taken 1964. Field checked 1967

Polyconic projection. 1927 North American datum
10,000-foot grid based on Oregon coordinate system,
south zone

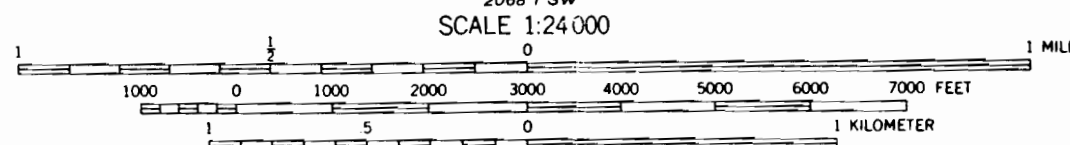

CONTOUR INTERVAL 20 FEET
DOTTED LINES REPRESENT 10-FOOT CONTOURS
NATIONAL GEODETIC VERTICAL DATUM OF 1929

ROAD CLASSIFICATION

Light-duty Unimproved

Application No. R-75330
Permit No.