


**HART MOUNTAIN
NATIONAL ANTELOPE REFUGE**

**HB 2153
POND LOCATIONS**

CAMPBELL LAKE QUADRANGLE
OREGON—LAKE CO.
7.5 MINUTE SERIES (TOPOGRAPHIC)

(BLUEJOINT LAKE EAST)
2069 11 NE

UNITED STATES
DEPARTMENT OF THE INTERIOR
GEOLOGICAL SURVEY

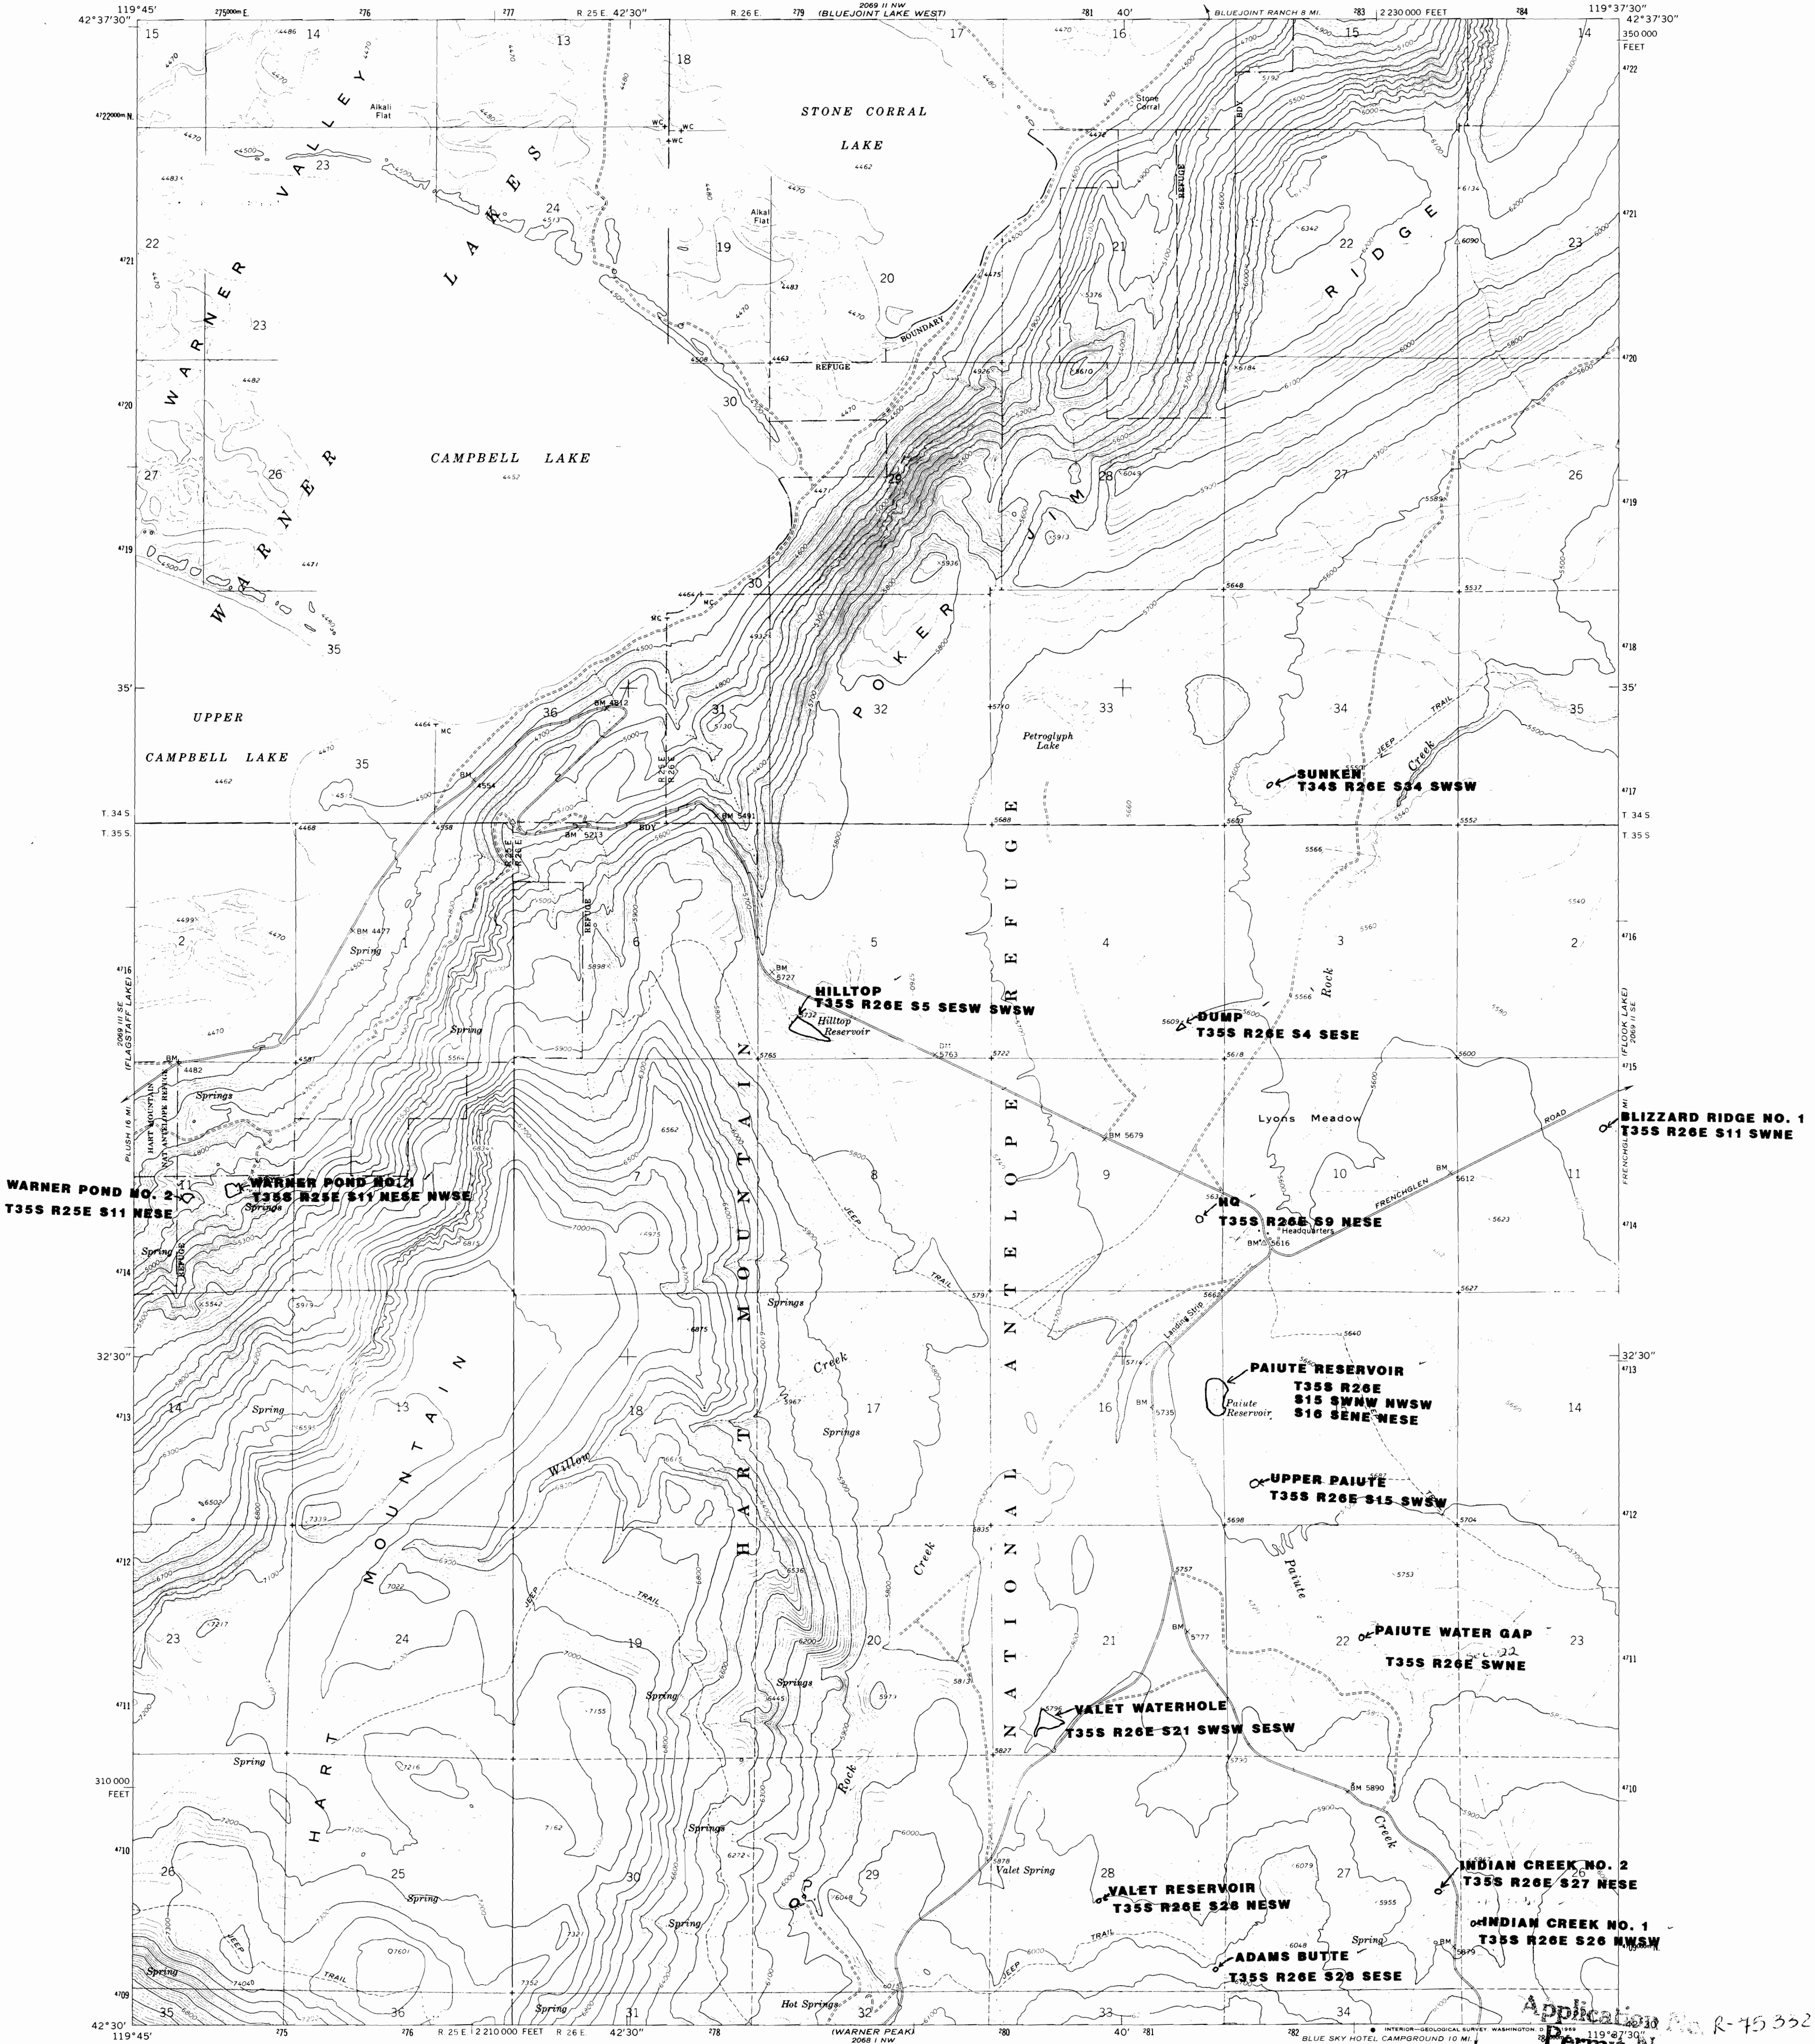

**WARNER POND NO. 2
T35S R25E S11 NESE**

**HILLTOP
T35S R26E S5 SESW SWSW**

**DUMP
T35S R26E S4 SESE**

**BLIZZARD RIDGE NO. 1
T35S R26E S11 SWNE**

**PAIUTE RESERVOIR
T35S R26E
S15 SNNW NWSW
S16 SENE NESE**

**UPPER PAIUTE
T35S R26E S15 SWSW**

**PAIUTE WATER GAP
T35S R26E SWNE**

**VALET WATERHOLE
T35S R26E S21 SWSW SESW**

**VALET RESERVOIR
T35S R26E S28 NESW**

**ADAMS BUTTE
T35S R26E S28 SESE**

**INDIAN CREEK NO. 2
T35S R26E S27 NESE**

**INDIAN CREEK NO. 1
T35S R26E S26 NWSW**

Application No. R-75332
Permit No.
CERTIFICATE NO. C3490

Mapped, edited, and published by the Geological Survey
Control by USGS and USC&GS
Topography by photogrammetric methods from aerial
photographs taken 1964. Field checked 1967
Polyconic projection. 1927 North American datum
10,000-foot grid based on Oregon coordinate system,
south zone
1000-meter Universal Transverse Mercator grid ticks,
zone 11, shown in blue
Fine red dashed lines indicate selected fence lines

UTM GRID AND 1967 MAGNETIC NORTH
DECLINATION AT CENTER OF SHEET

SCALE 1:24000
CONTOUR INTERVAL 20 FEET
DOTTED LINES REPRESENT 10-FOOT CONTOURS
DATUM IS MEAN SEA LEVEL

QUADRANGLE LOCATION

CAMPBELL LAKE, OREG.
N4230—W11937.5/7.5

1967