


HART MOUNTAIN NATIONAL ANTELOPE REFUGE

HB 2153 POND LOCATIONS

CAMPBELL LAKE QUADRANGLE
OREGON—LAKE CO.
7.5 MINUTE SERIES (TOPOGRAPHIC)

2009 11 NE
(BLUEJOINT LAKE EAST)

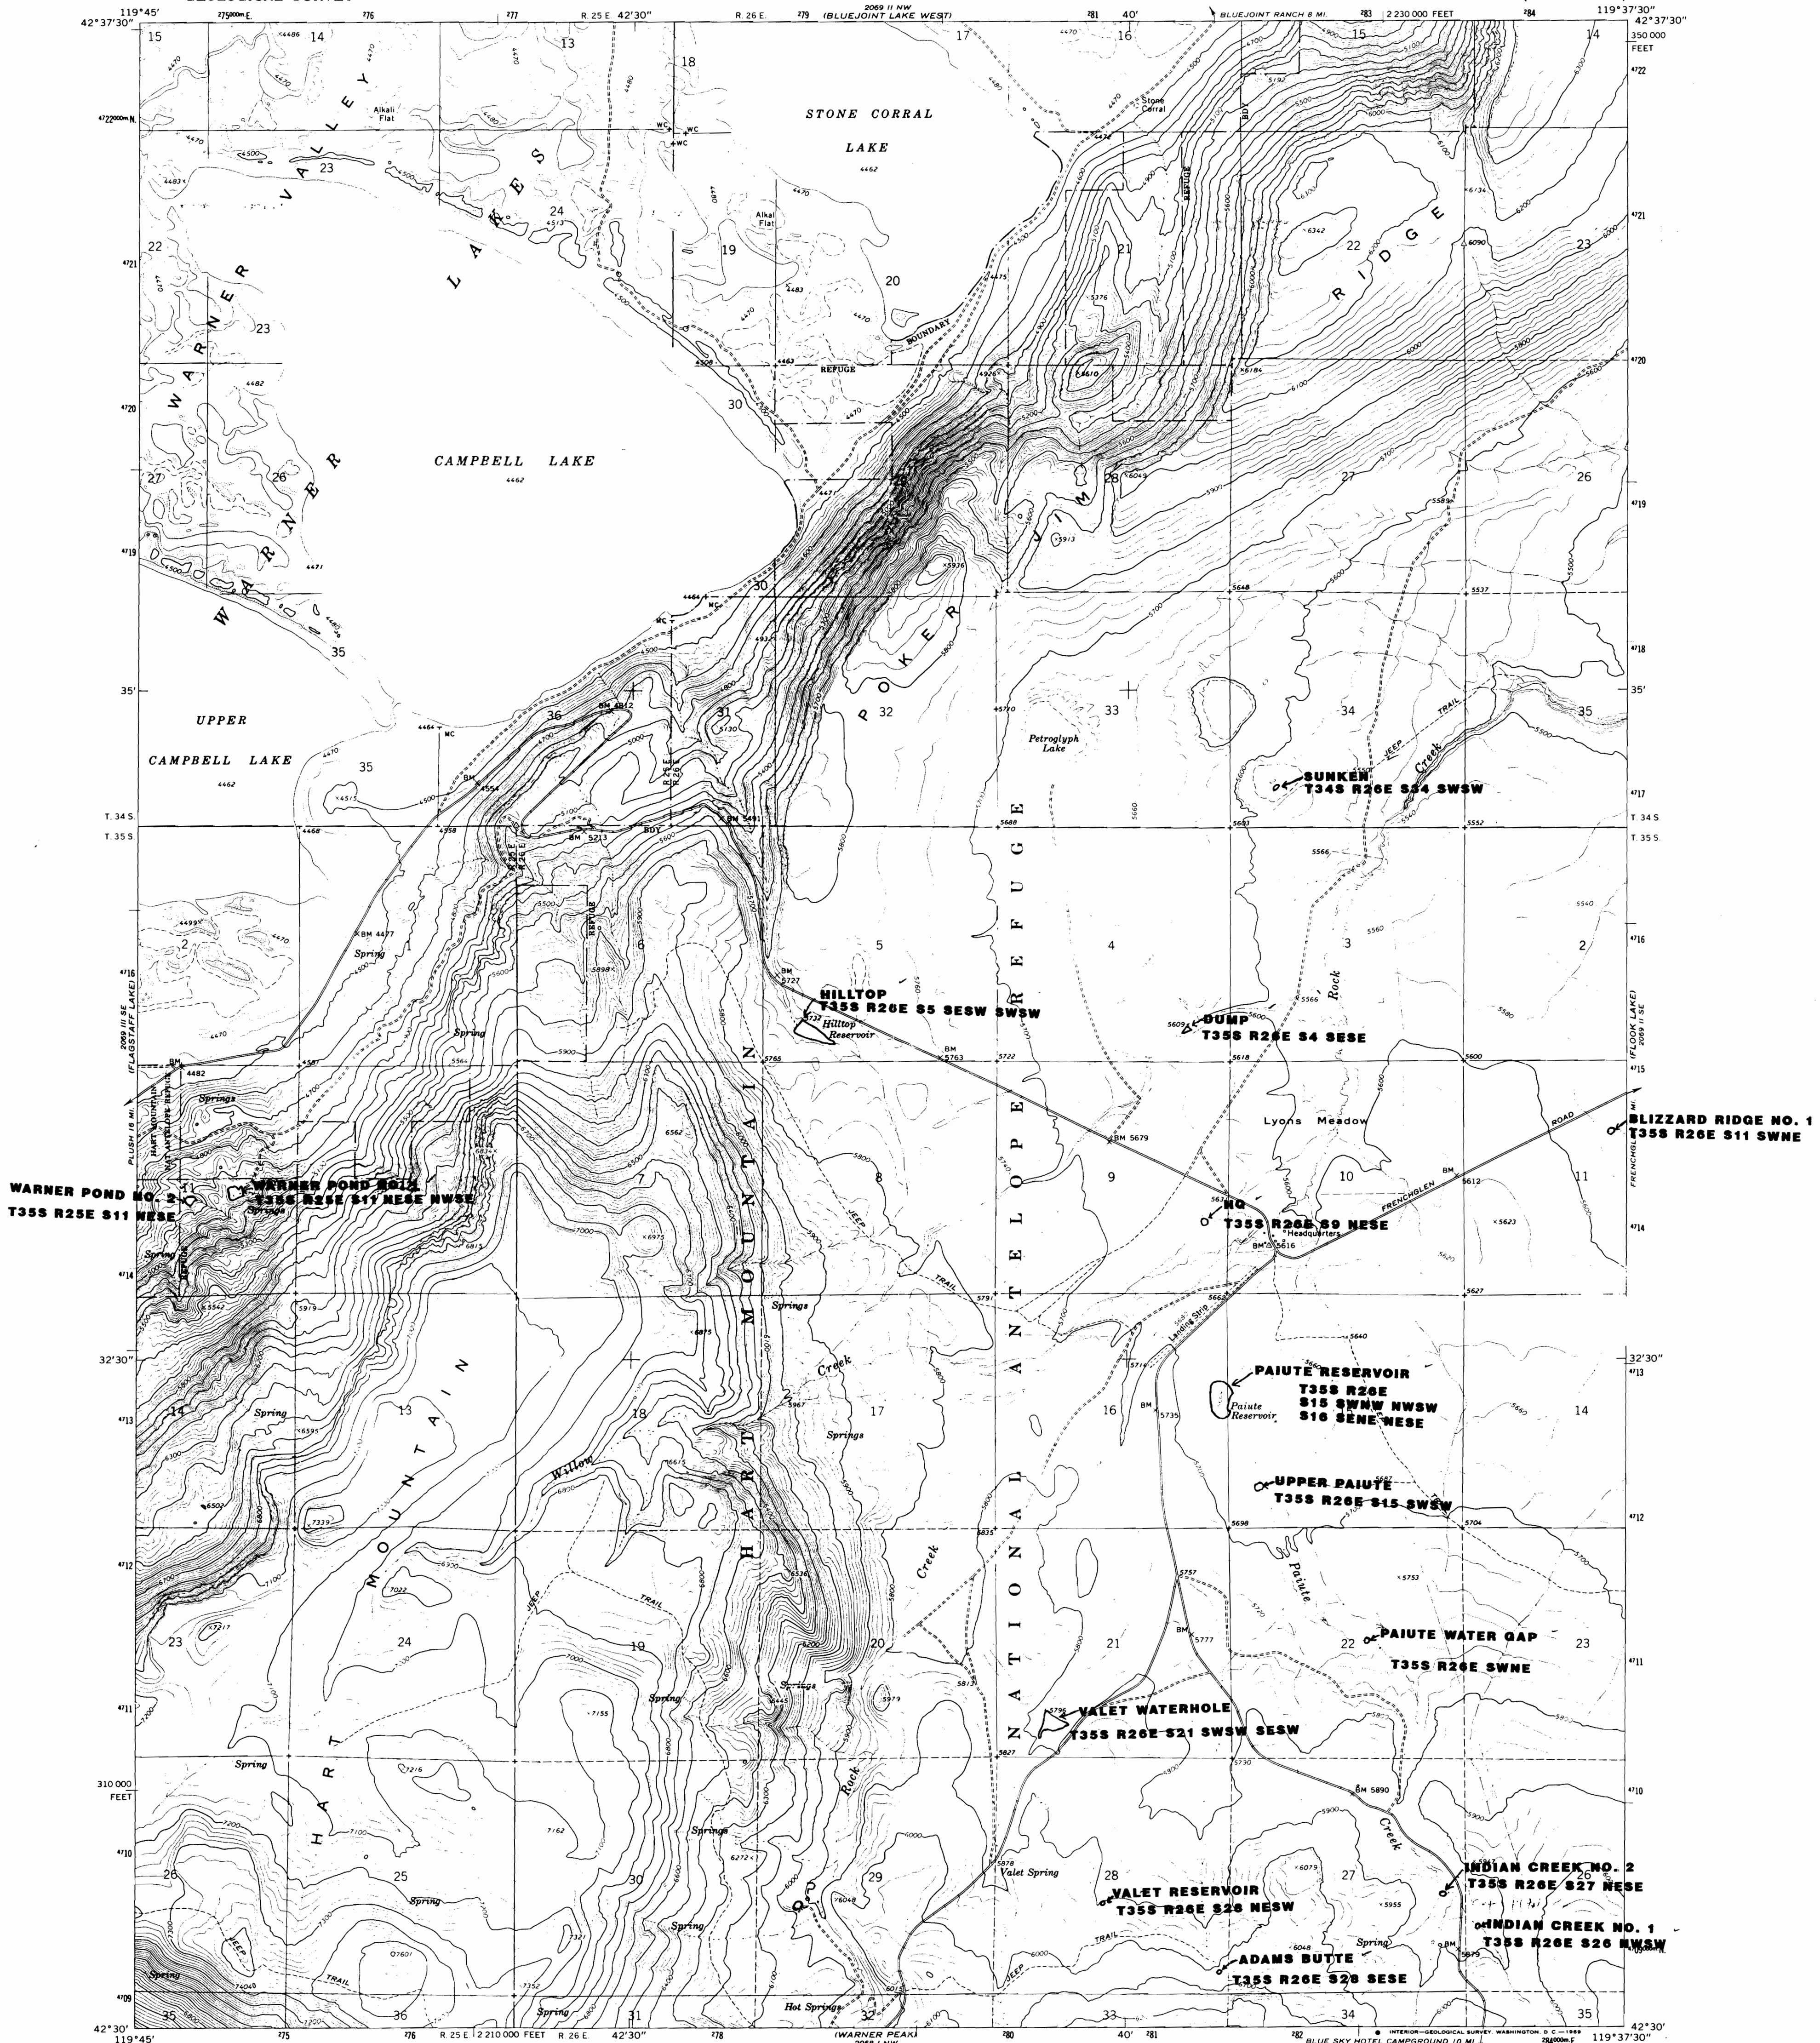

WARNER POND NO. 2
T35S R25E S11 NESE

HILLTOP
T35S R26E S5 SESW SWSW

DUMP
T35S R26E S4 SESE

BLIZZARD RIDGE NO. 1
T35S R26E S11 SWNE

PAIUTE RESERVOIR

UPPER PAIUTE
T35S R26E S15 SWSW

PAIUTE WATER GAP
T35S R26E SWNE

VALET WATERHOLE
T35S R26E S21 SWSW SESW


VALET RESERVOIR

ADAMS BUTTE
T35S R26E S28 SESE

INDIAN CREEK NO. 2
T35S R26E S27 NESE

INDIAN CREEK NO. 1
T35S R26E S26 NWSW

Mapped, edited, and published by the Geological Survey
Control by USGS and USC&GS
Topography by photogrammetric methods from aerial
photographs taken 1964. Field checked 1967
Polyconic projection. 1927 North American datum
10,000-foot grid based on Oregon coordinate system,
south zone
1000-meter Universal Transverse Mercator grid ticks,
zone 11, shown in blue
Fine red dashed lines indicate selected fence lines

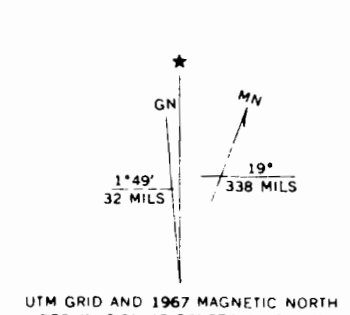

SCALE 1:24,000
CONTOUR INTERVAL 20 FEET
DOTTED LINES REPRESENT 10-FOOT CONTOURS
DATUM IS MEAN SEA LEVEL



ROAD CLASSIFICATION
Light-duty ——— Unimproved dirt ———

Application No. R-75336
Permit No. 69494

THIS MAP COMPLIES WITH NATIONAL MAP ACCURACY STANDARDS
FOR SALE BY U. S. GEOLOGICAL SURVEY, DENVER, COLORADO 80225, OR WASHINGTON, D. C. 20242
A FOLDER DESCRIBING TOPOGRAPHIC MAPS AND SYMBOLS IS AVAILABLE ON REQUEST

CAMPBELL LAKE, OREG.
N4230—W11937.5/7.5