


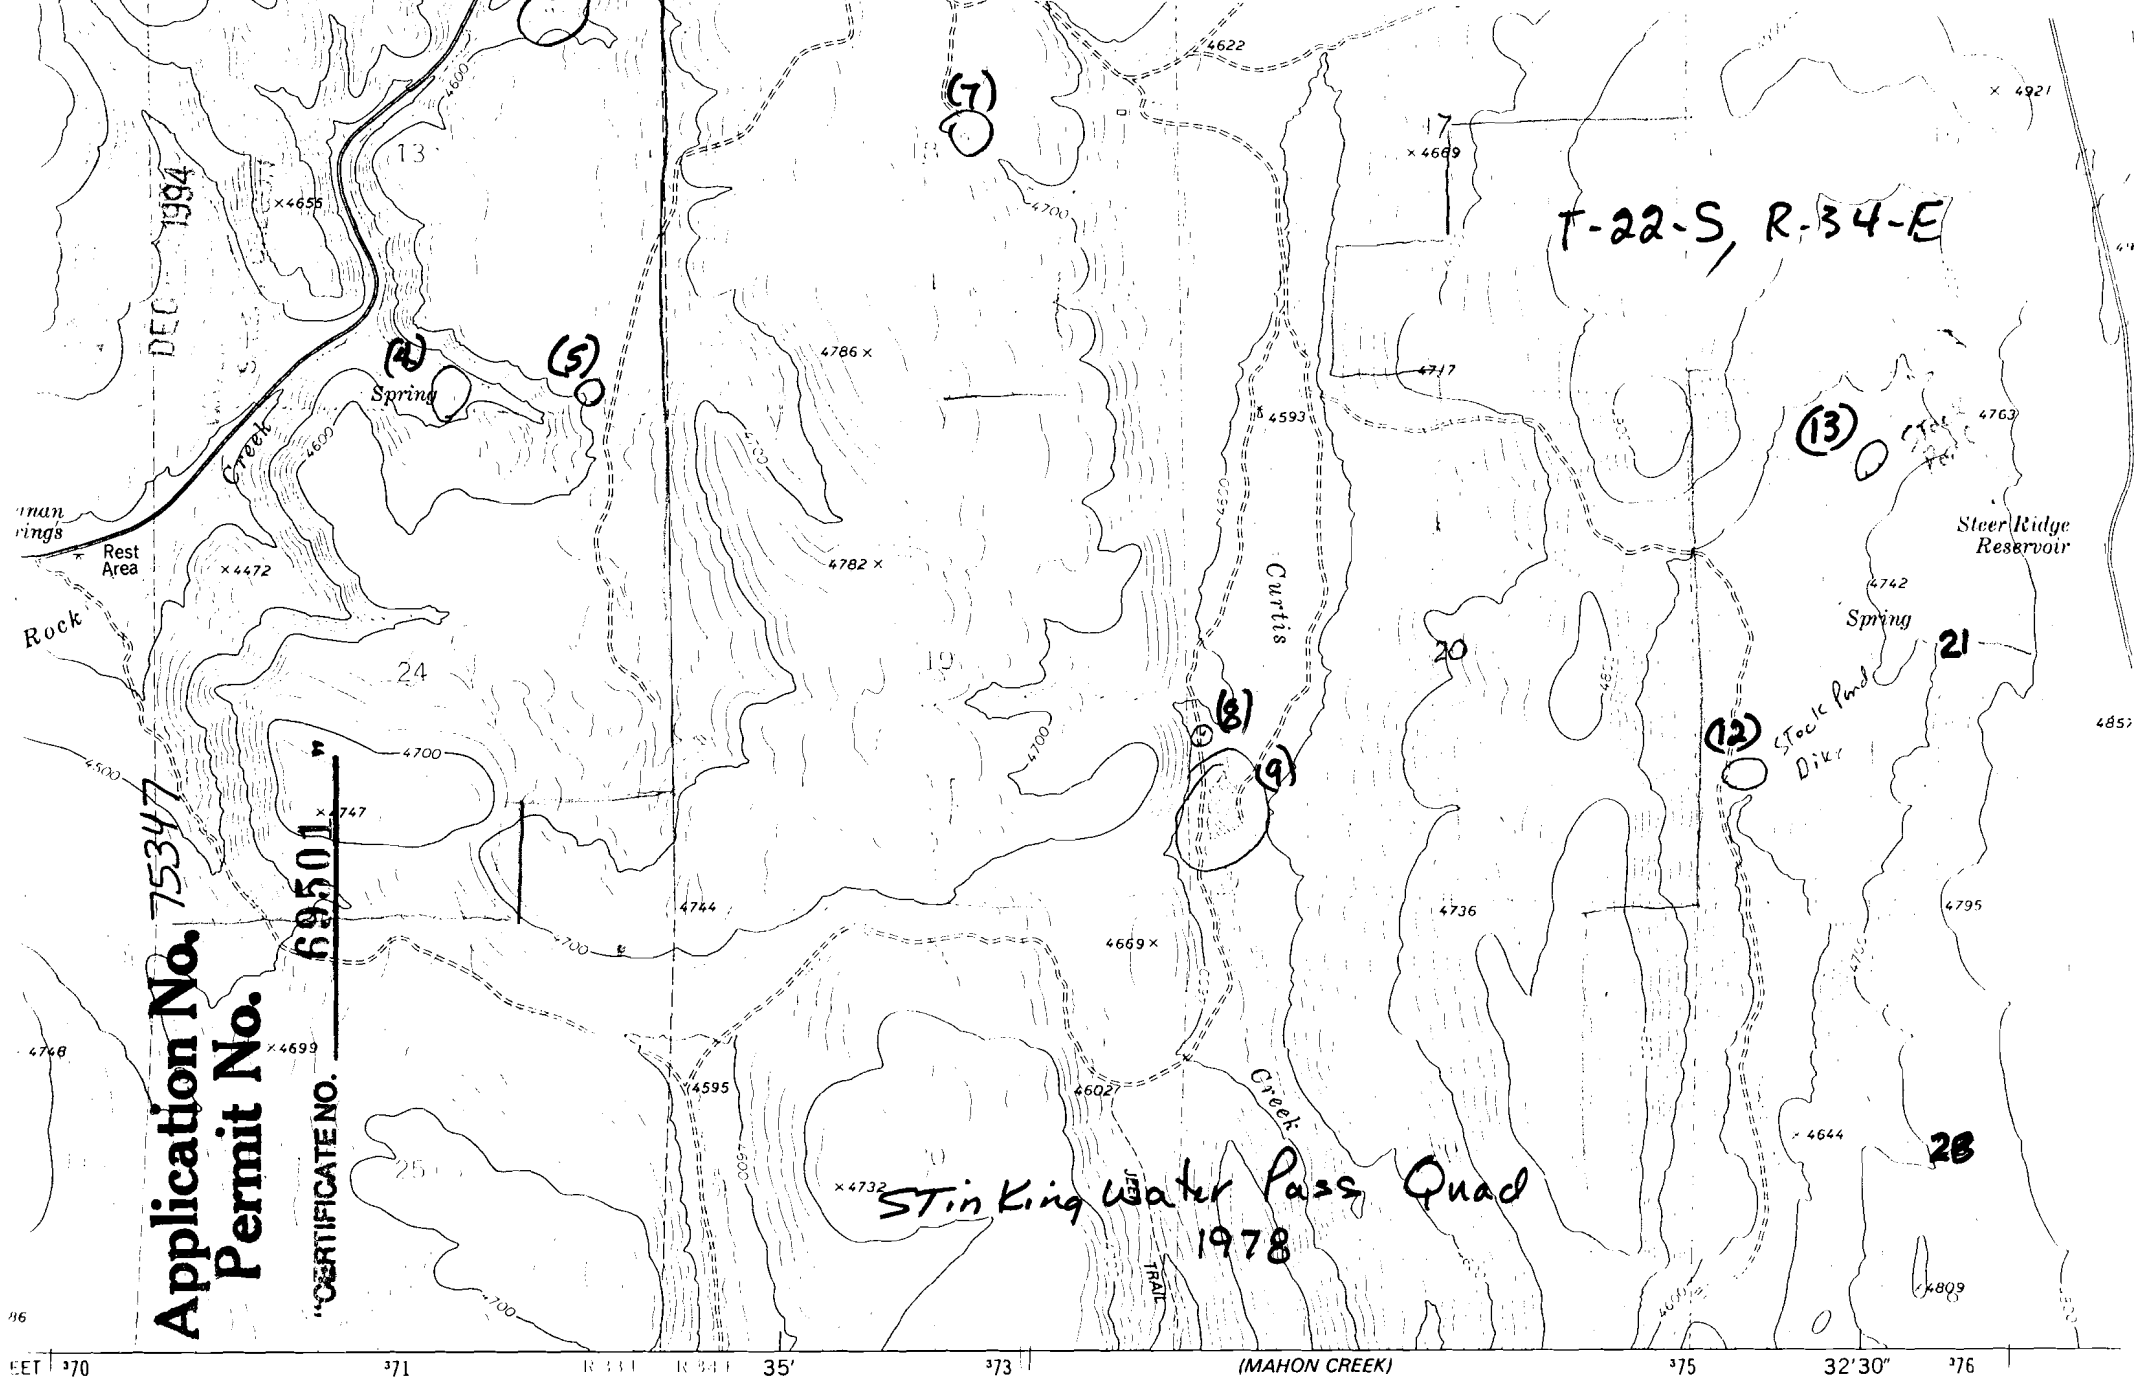

Published by the Geological Survey

Methods from aerial
checked 1973. Map edited 1978

ticks: Oregon coordinate
informal conic)

Meridian grid line

