


Application No. 75349
Permit No.

"CERTIFICATE NO. 69503"

Buchanan Quad
1973

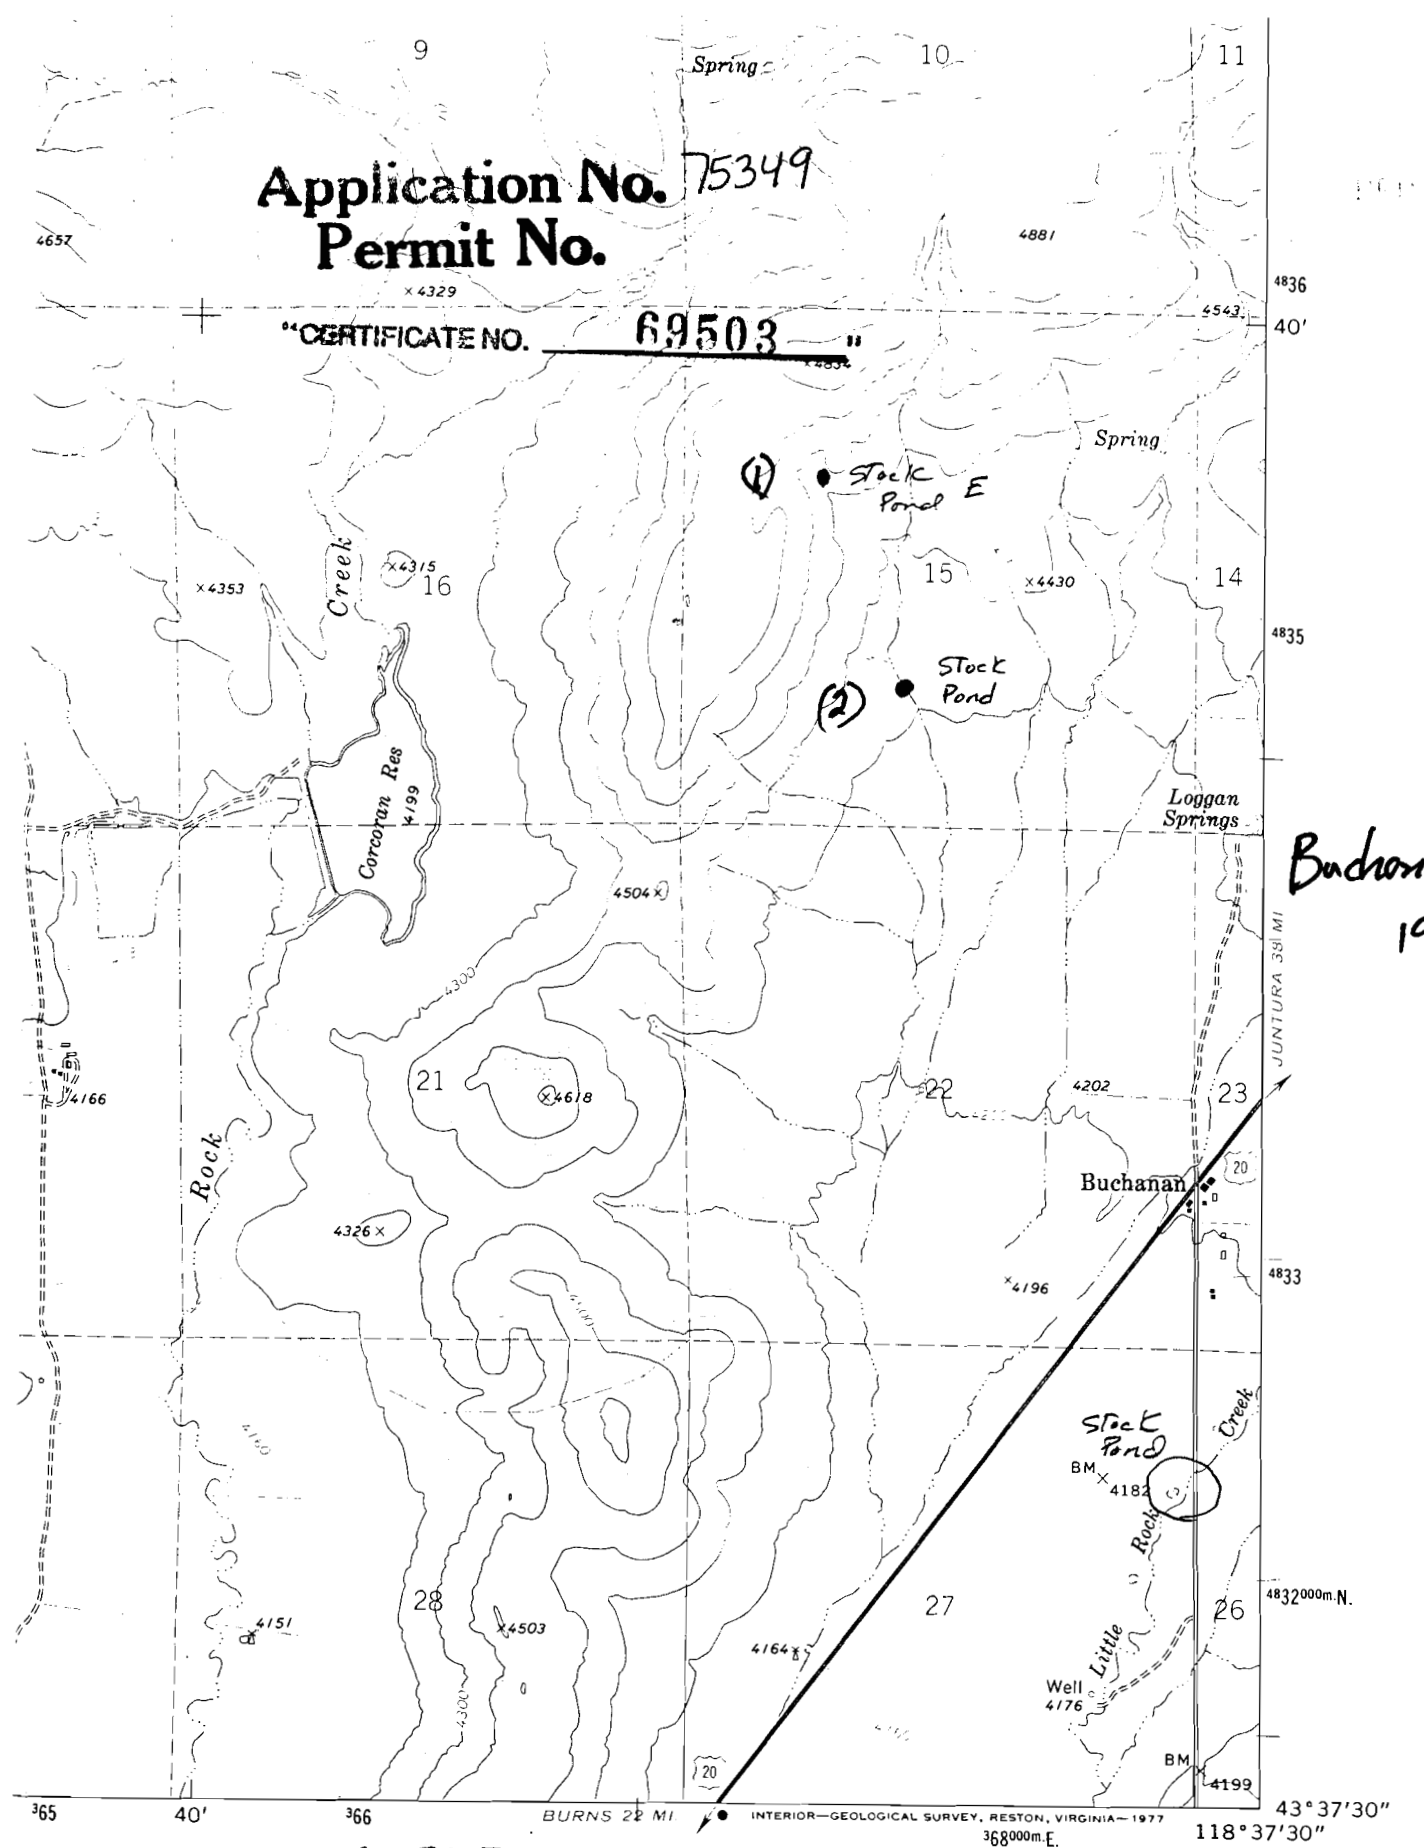

225-73 E

ROAD CLASSIFICATION

- Primary highway, hard surface ————— Light-duty road, hard or improved surface —————
Secondary highway, hard surface ————— Unimproved road. =====
○ Interstate Route ○ U. S. Route ○ State Route

(MAHON CREEK)
2271 II SE

OREGON.

22711 NW
(BUCHANAN)

UNITED STATES
DEPARTMENT OF THE INTERIOR
GEOLOGICAL SURVEY

100 1000

118°37'30"
43°37'30"

370000mE

371

R 33 E R 34 E

Application No. 75349
Permit No.

CERTIFICATE NO. 69503 T 22 S
T 23 S

