

T38S R14E


SUPPLEMENTAL
DETERMINATION
LOST RIVER
61-169E
61-170E
3-30-90

JUNGE PIPE

U.S.A.

THIS PARCEL
IS PART OF
U.S.F.S. DEED
TO W. H. FRENCH
DATED
7-26-90
PATENT #
36-90-0019
Vol 1170 P. 20393

SEE: 3-16-92 LETTER
FROM U.S.A.
DWIGHT FRENCH
OREG. WATER RD.
RESOURCE DEPT.
ABOUT OUR WATER RIGHT
GERBE TO THIS PARCEL.
LETTER IS IN PADDY WATER RIGHT SECT.
OF CURRENT DOCUMENTS BINDER.

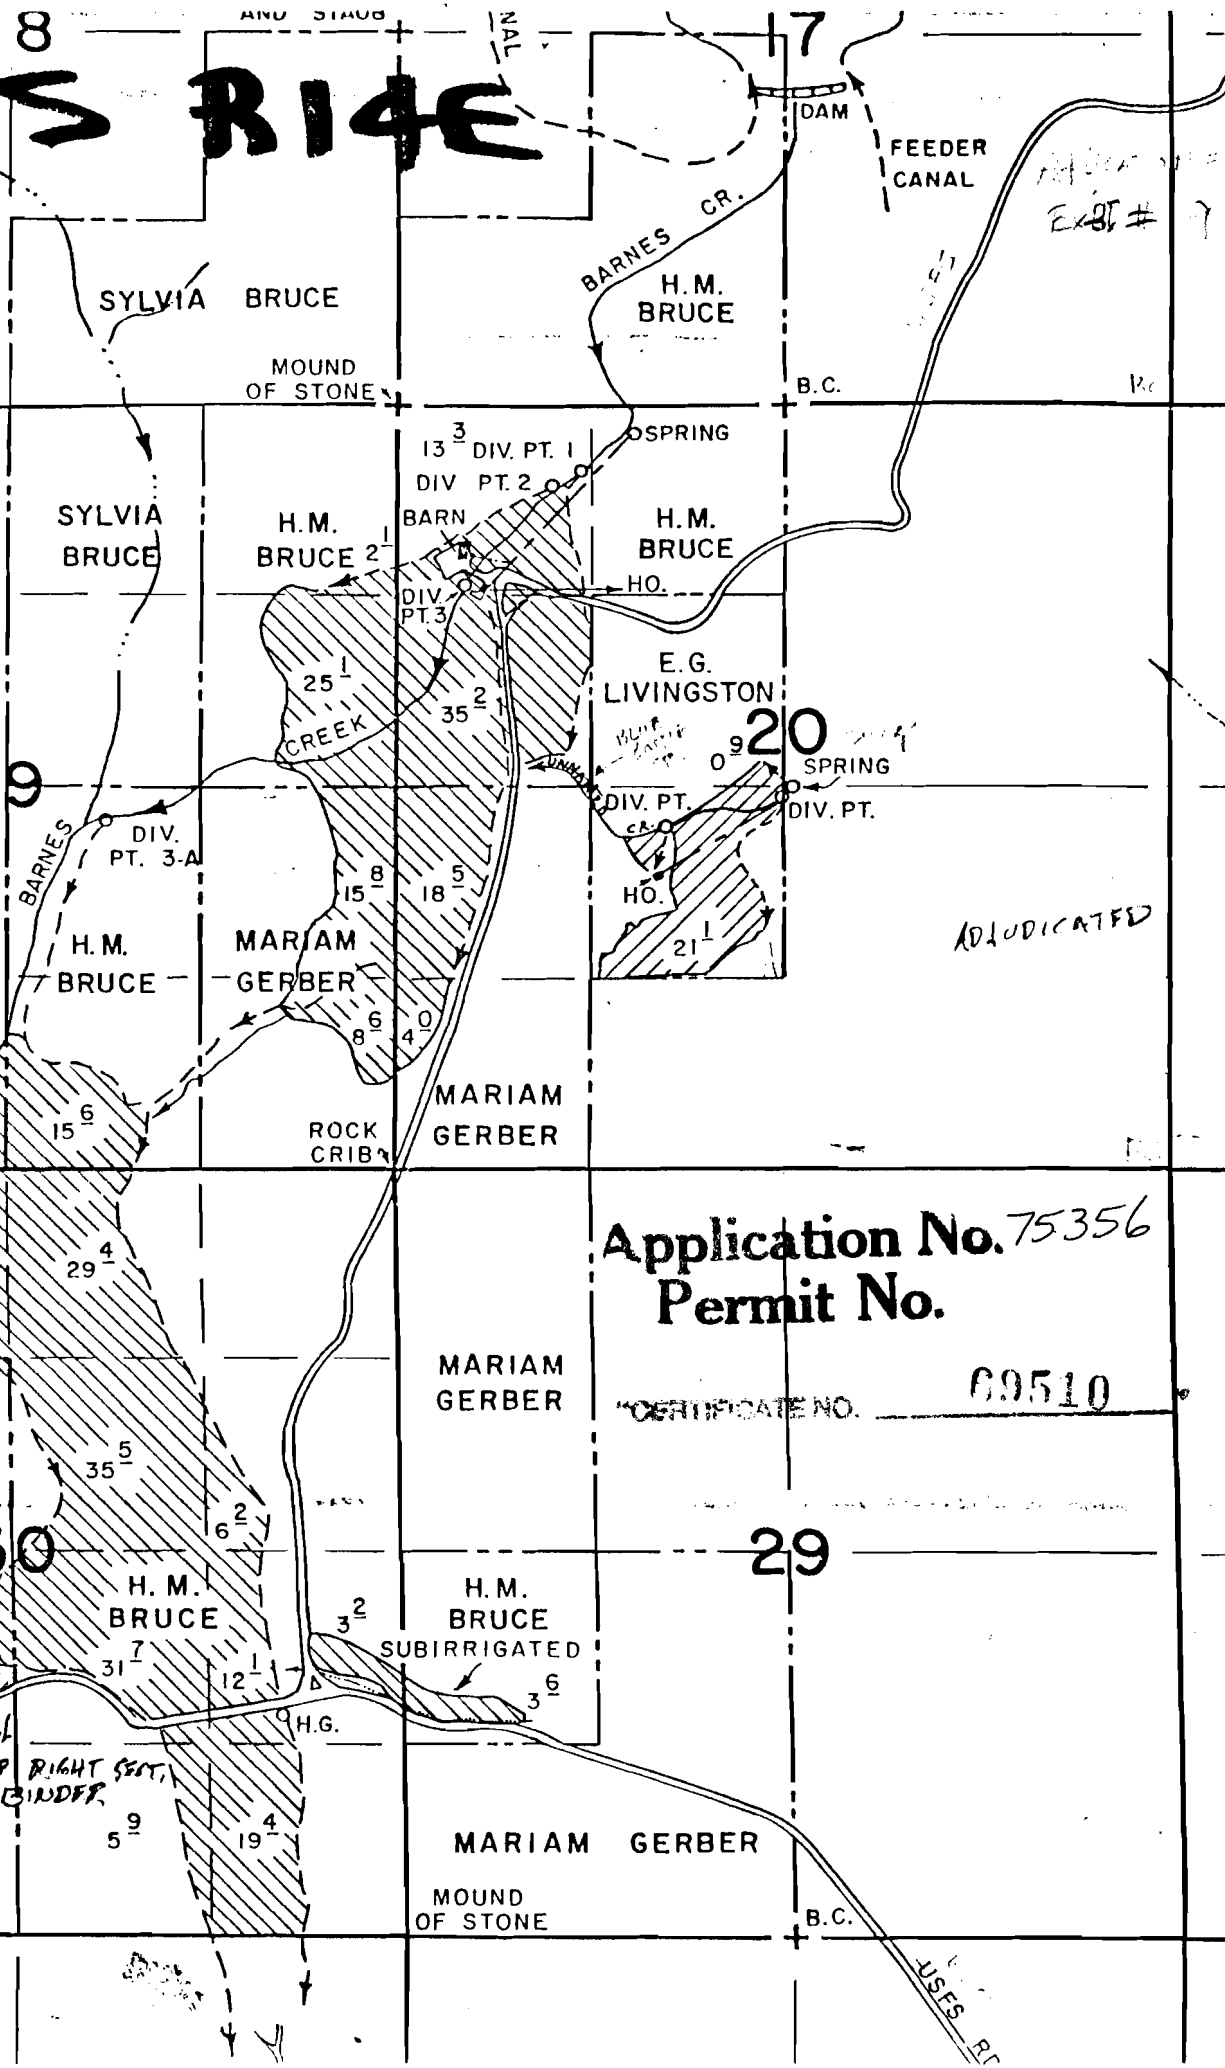

DAM
FEEDER CANAL

EXBT # 7

ADJUDICATED

Application No. 75356
Permit No.

CERTIFICATE NO. 69510

29

30

B.C.

JUNGE PIPE