

2689 I SE
(STEAMBOAT POINT)


UNITED STATES
DEPARTMENT OF THE INTERIOR
GEOLOGICAL SURVEY

HART MOUNTAIN NATIONAL ANTELOPE REFUGE

HB 2153 POND LOCATIONS



SIXMILE DRAW QUADRANGLE
OREGON
7.5 MINUTE SERIES (TOPOGRAPHIC)

2689 I SE
(DUNHAM PLAT WEST)

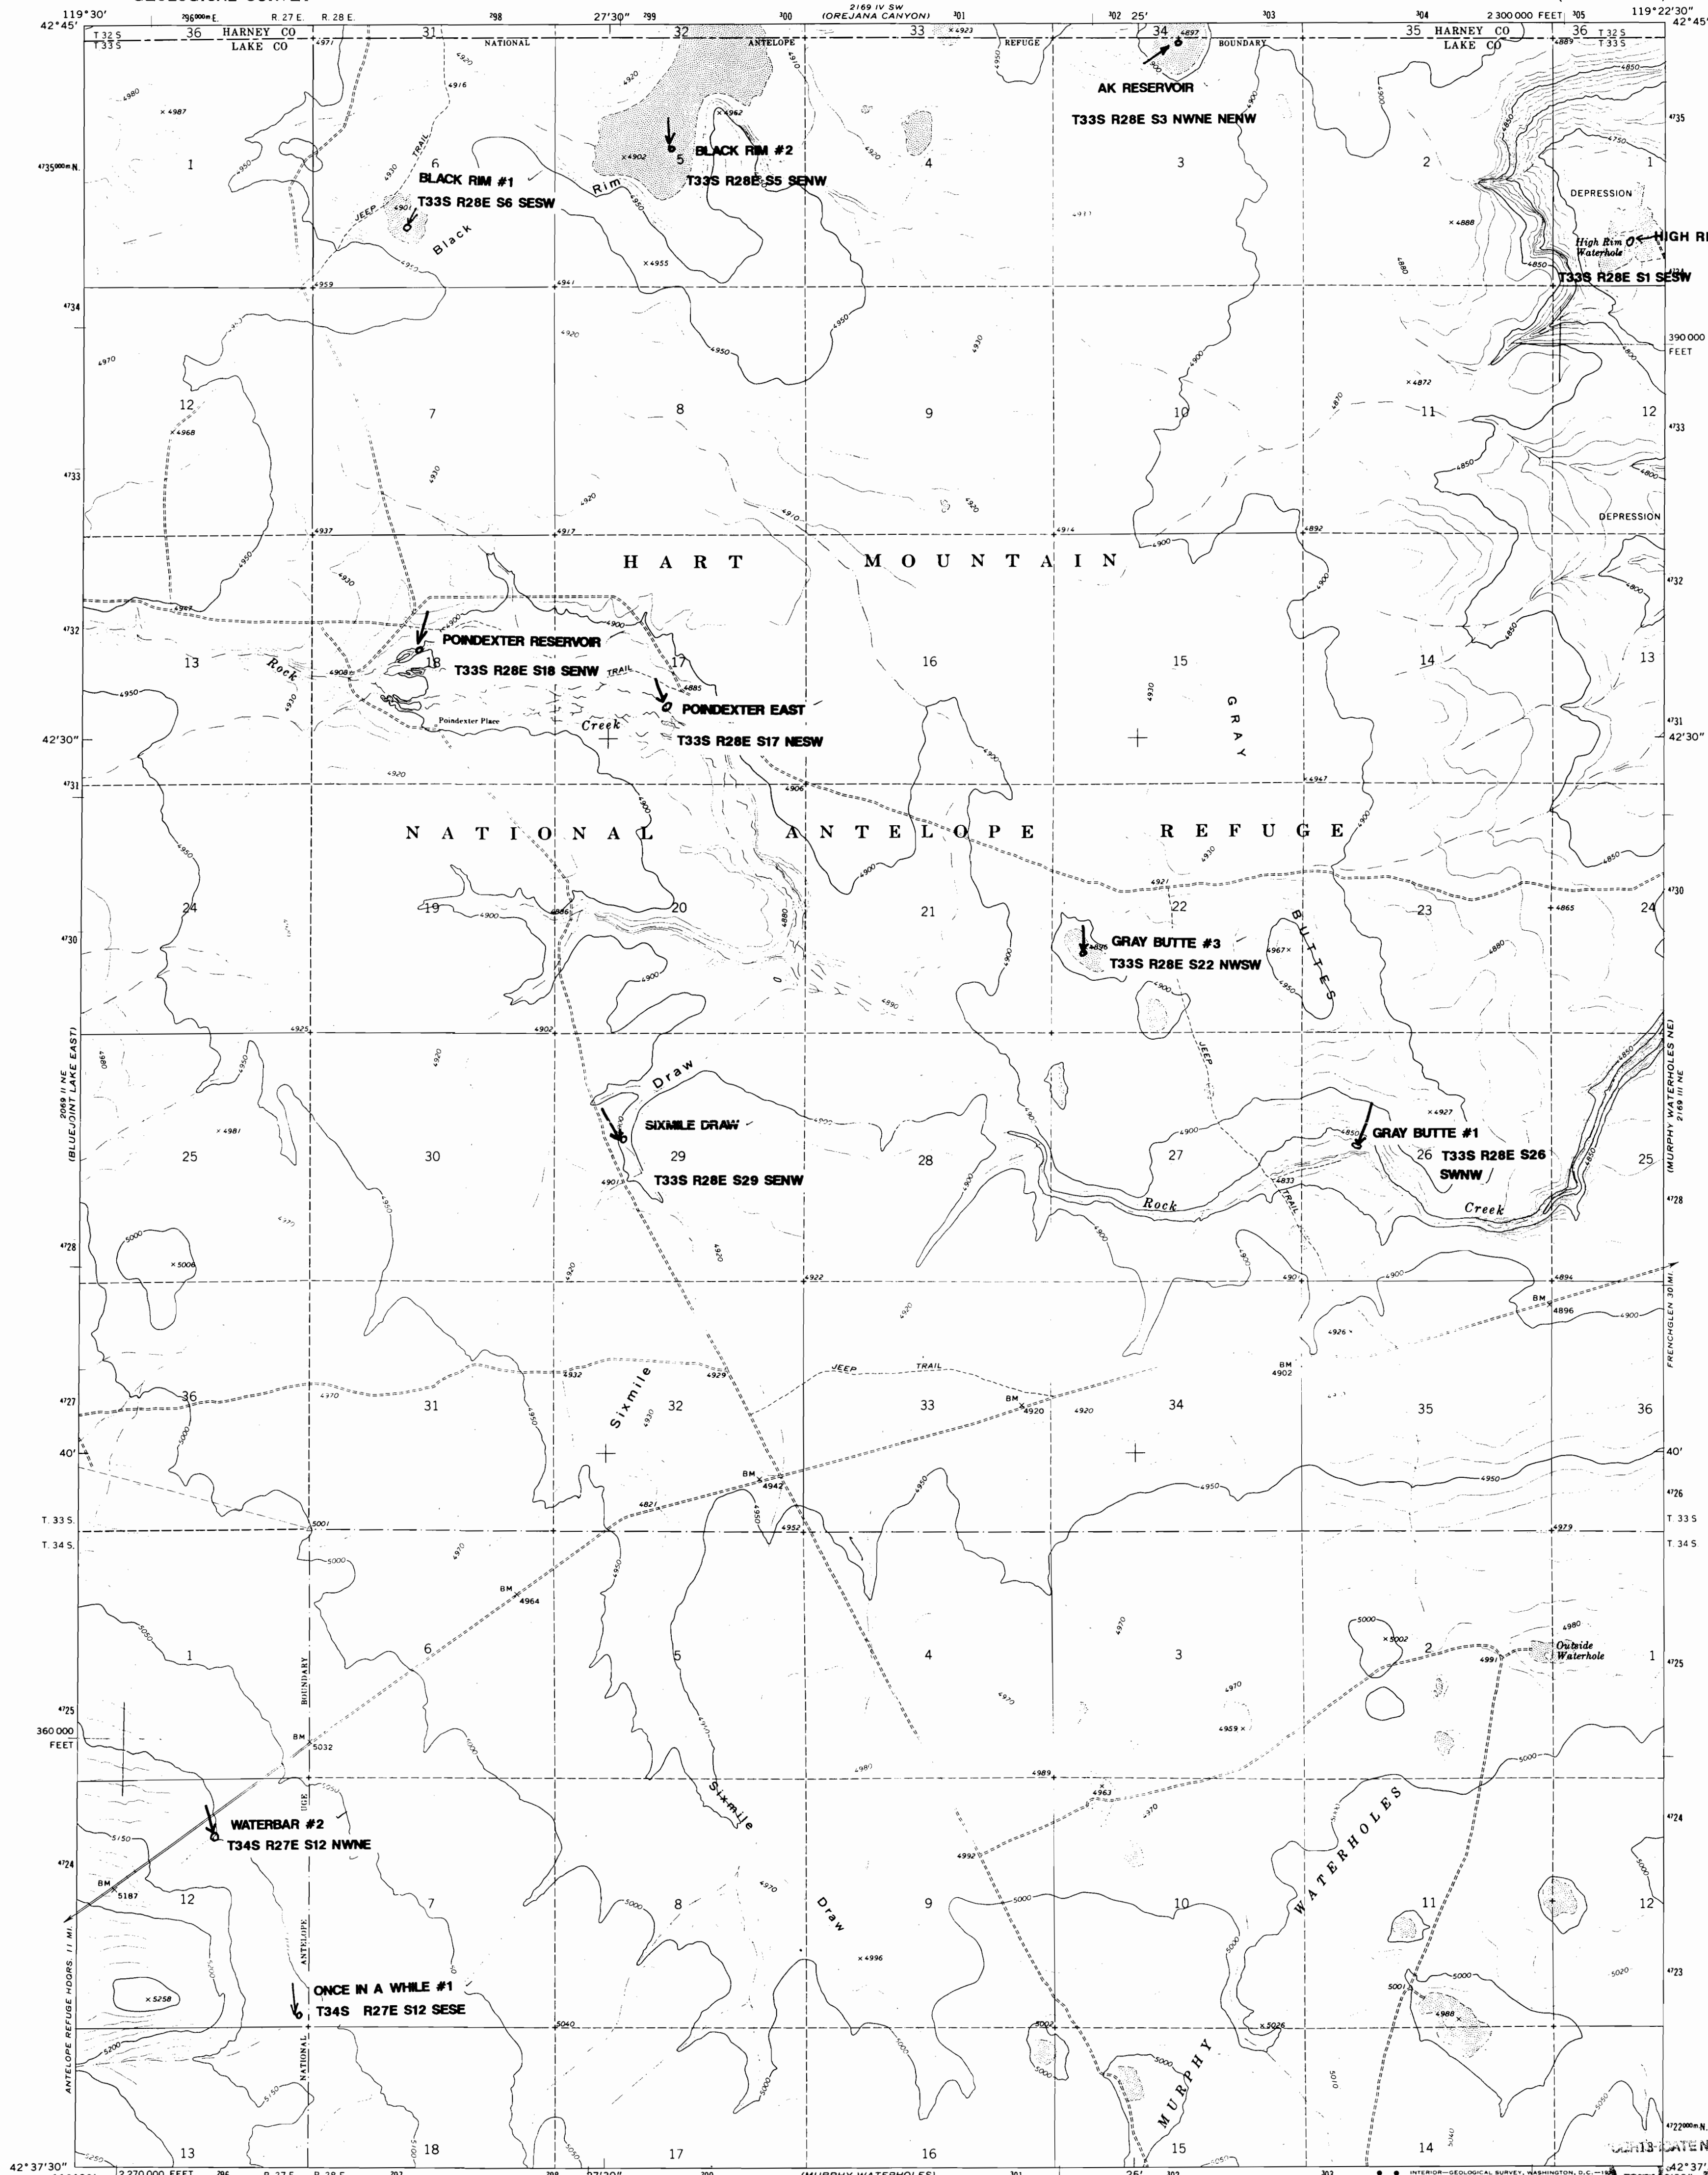

2689 I SE
(FLOCK LAKE)

Mapped, edited, and published by the Geological Survey
Control by USGS and USC&GS
Topography by photogrammetric methods from aerial
photographs taken 1969. Field checked 1971
Projection and 10,000-foot grid ticks: Oregon coordinate
system, south zone (Lambert conformal conic)
1000-meter Universal Transverse Mercator grid ticks,
zone 11, shown in blue. 1927 North American datum
Fine red dashed lines indicate selected fence lines

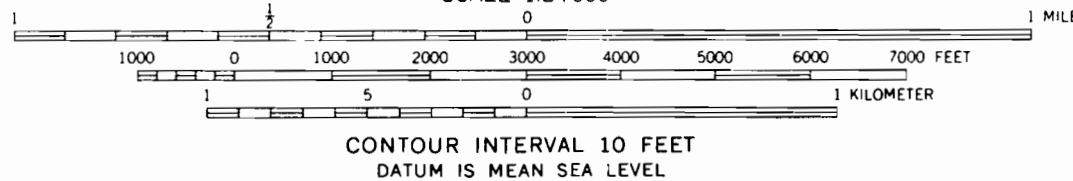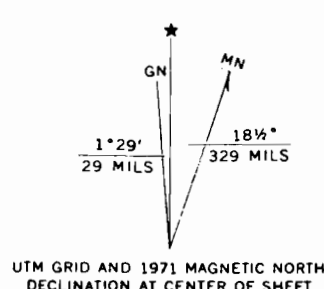

ROAD CLASSIFICATION
Primary highway, hard surface
Secondary highway, hard surface
Unimproved road
Interstate Route
U. S. Route
State Route

SIXMILE DRAW, OREG.
N4237.5-W11922.5/7.5

1971

Application No. R-75358
Permit No.