


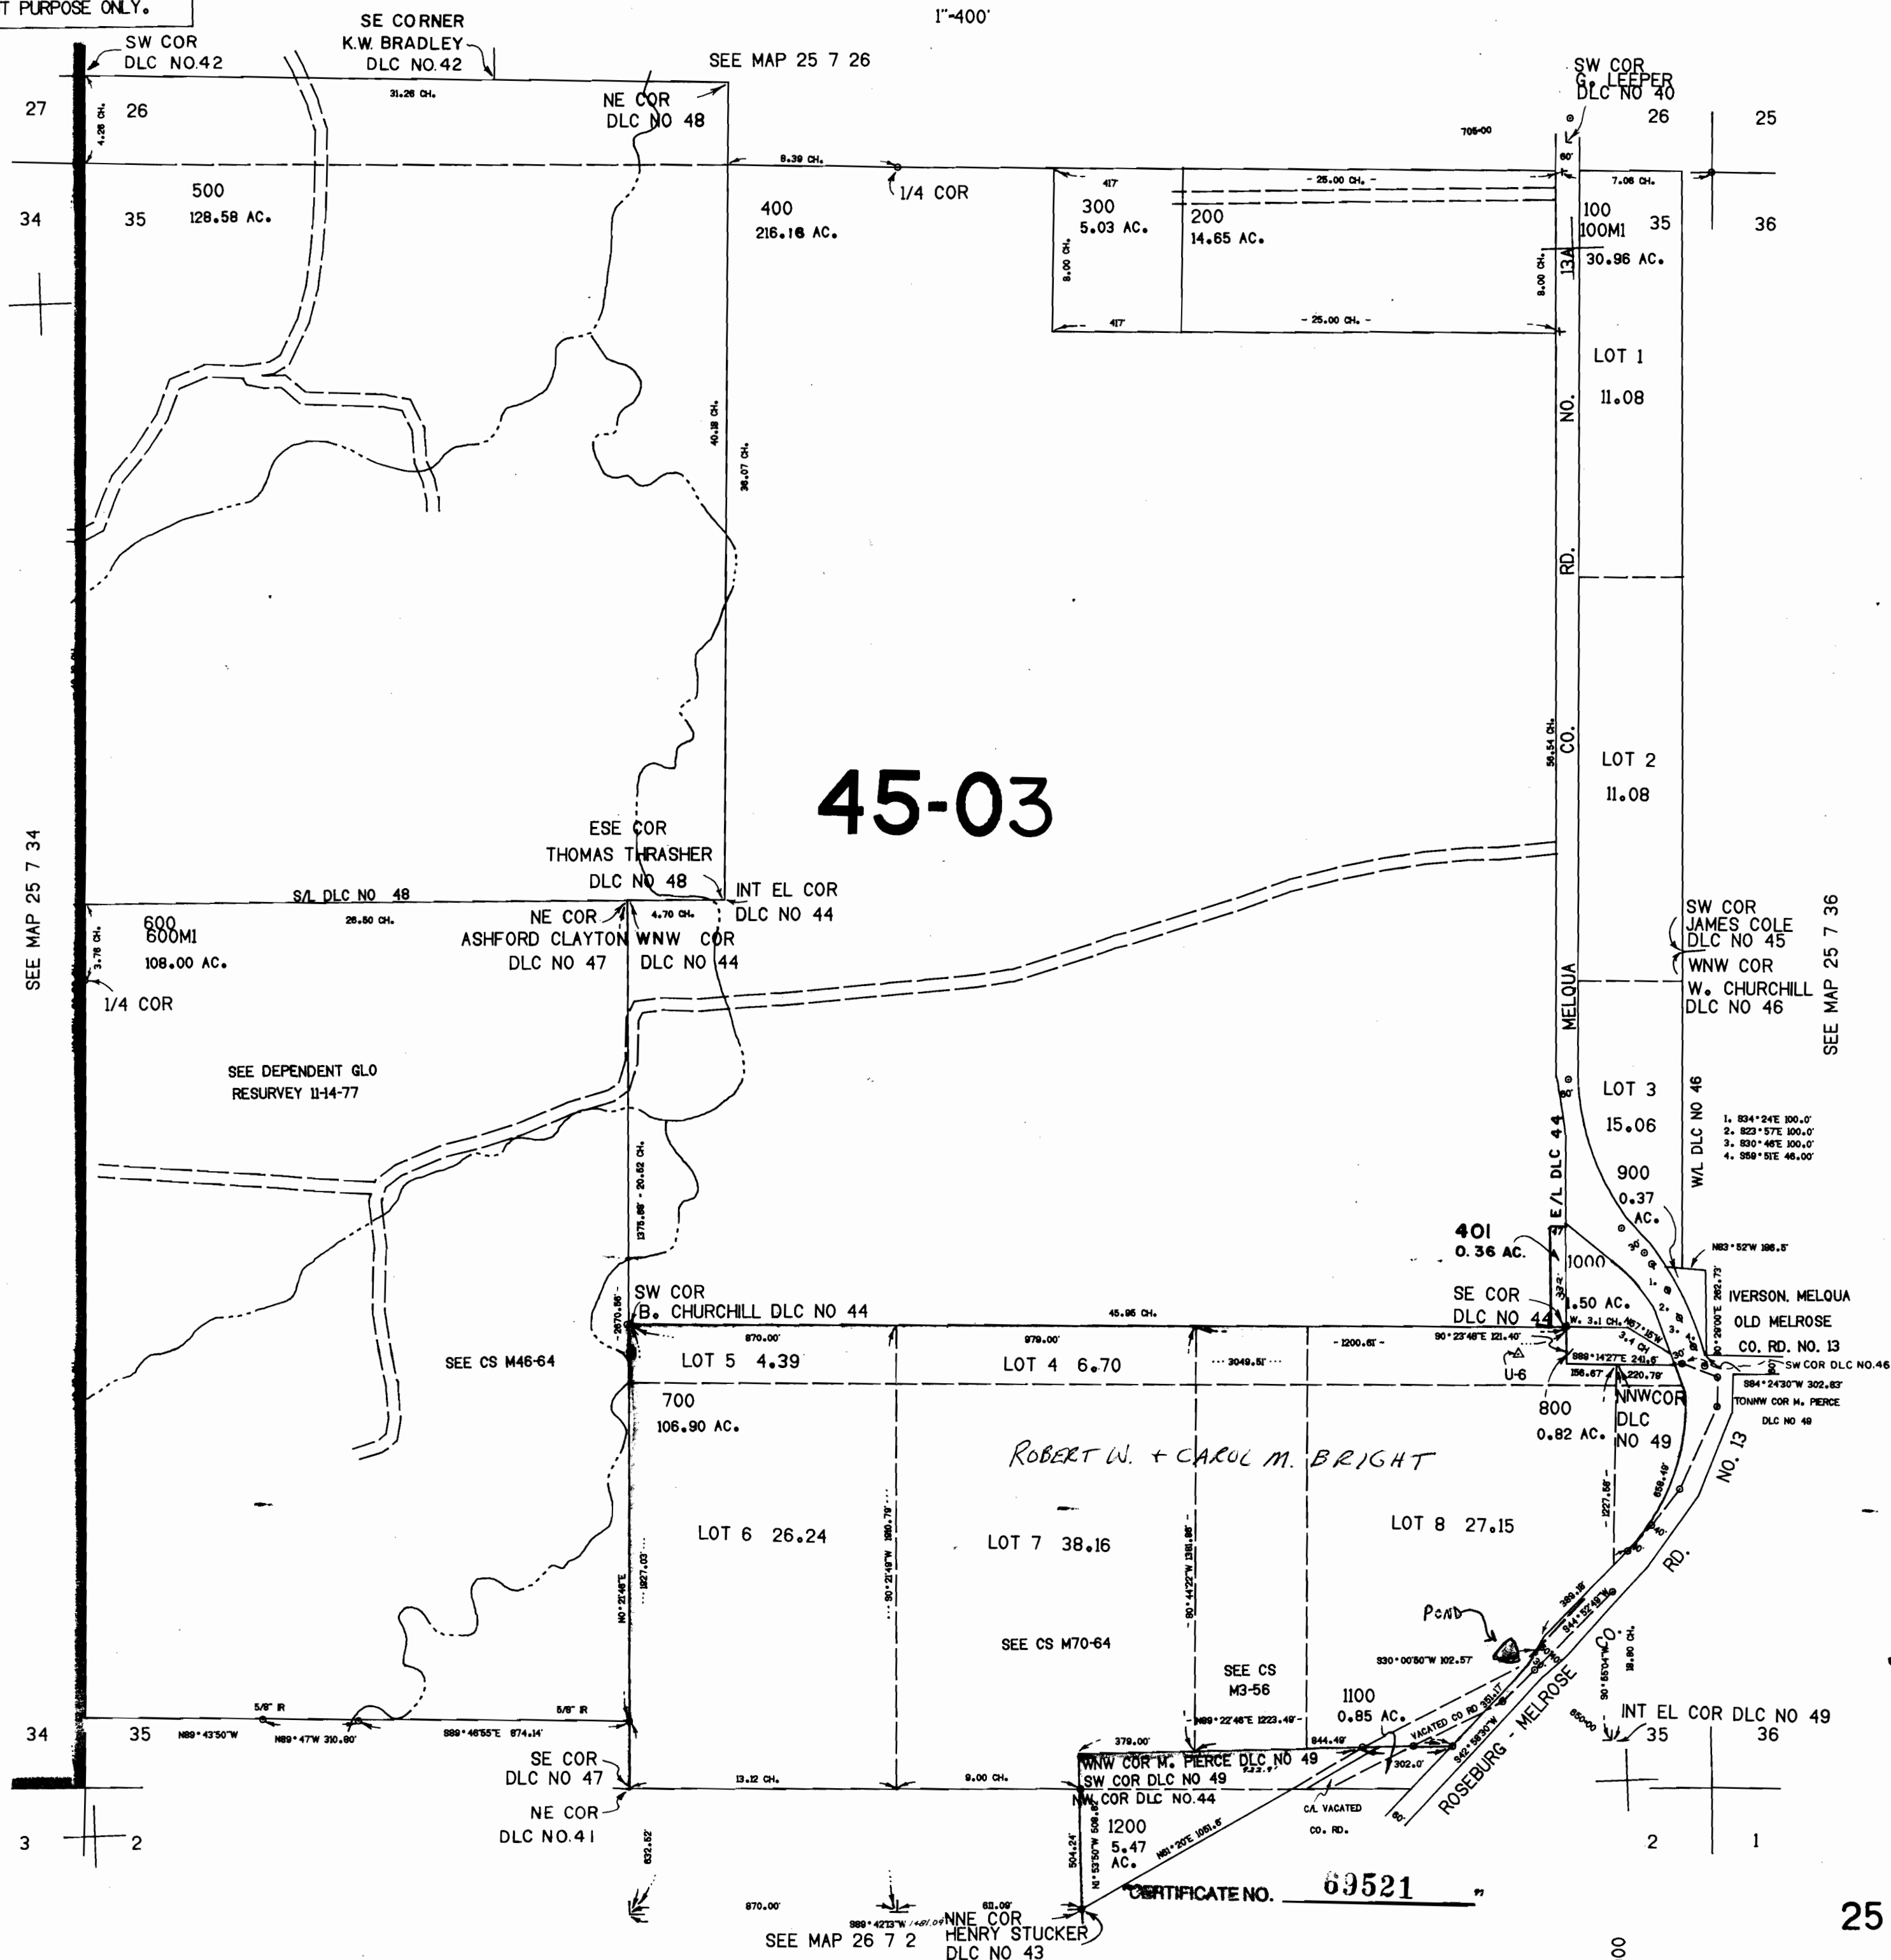

626.0