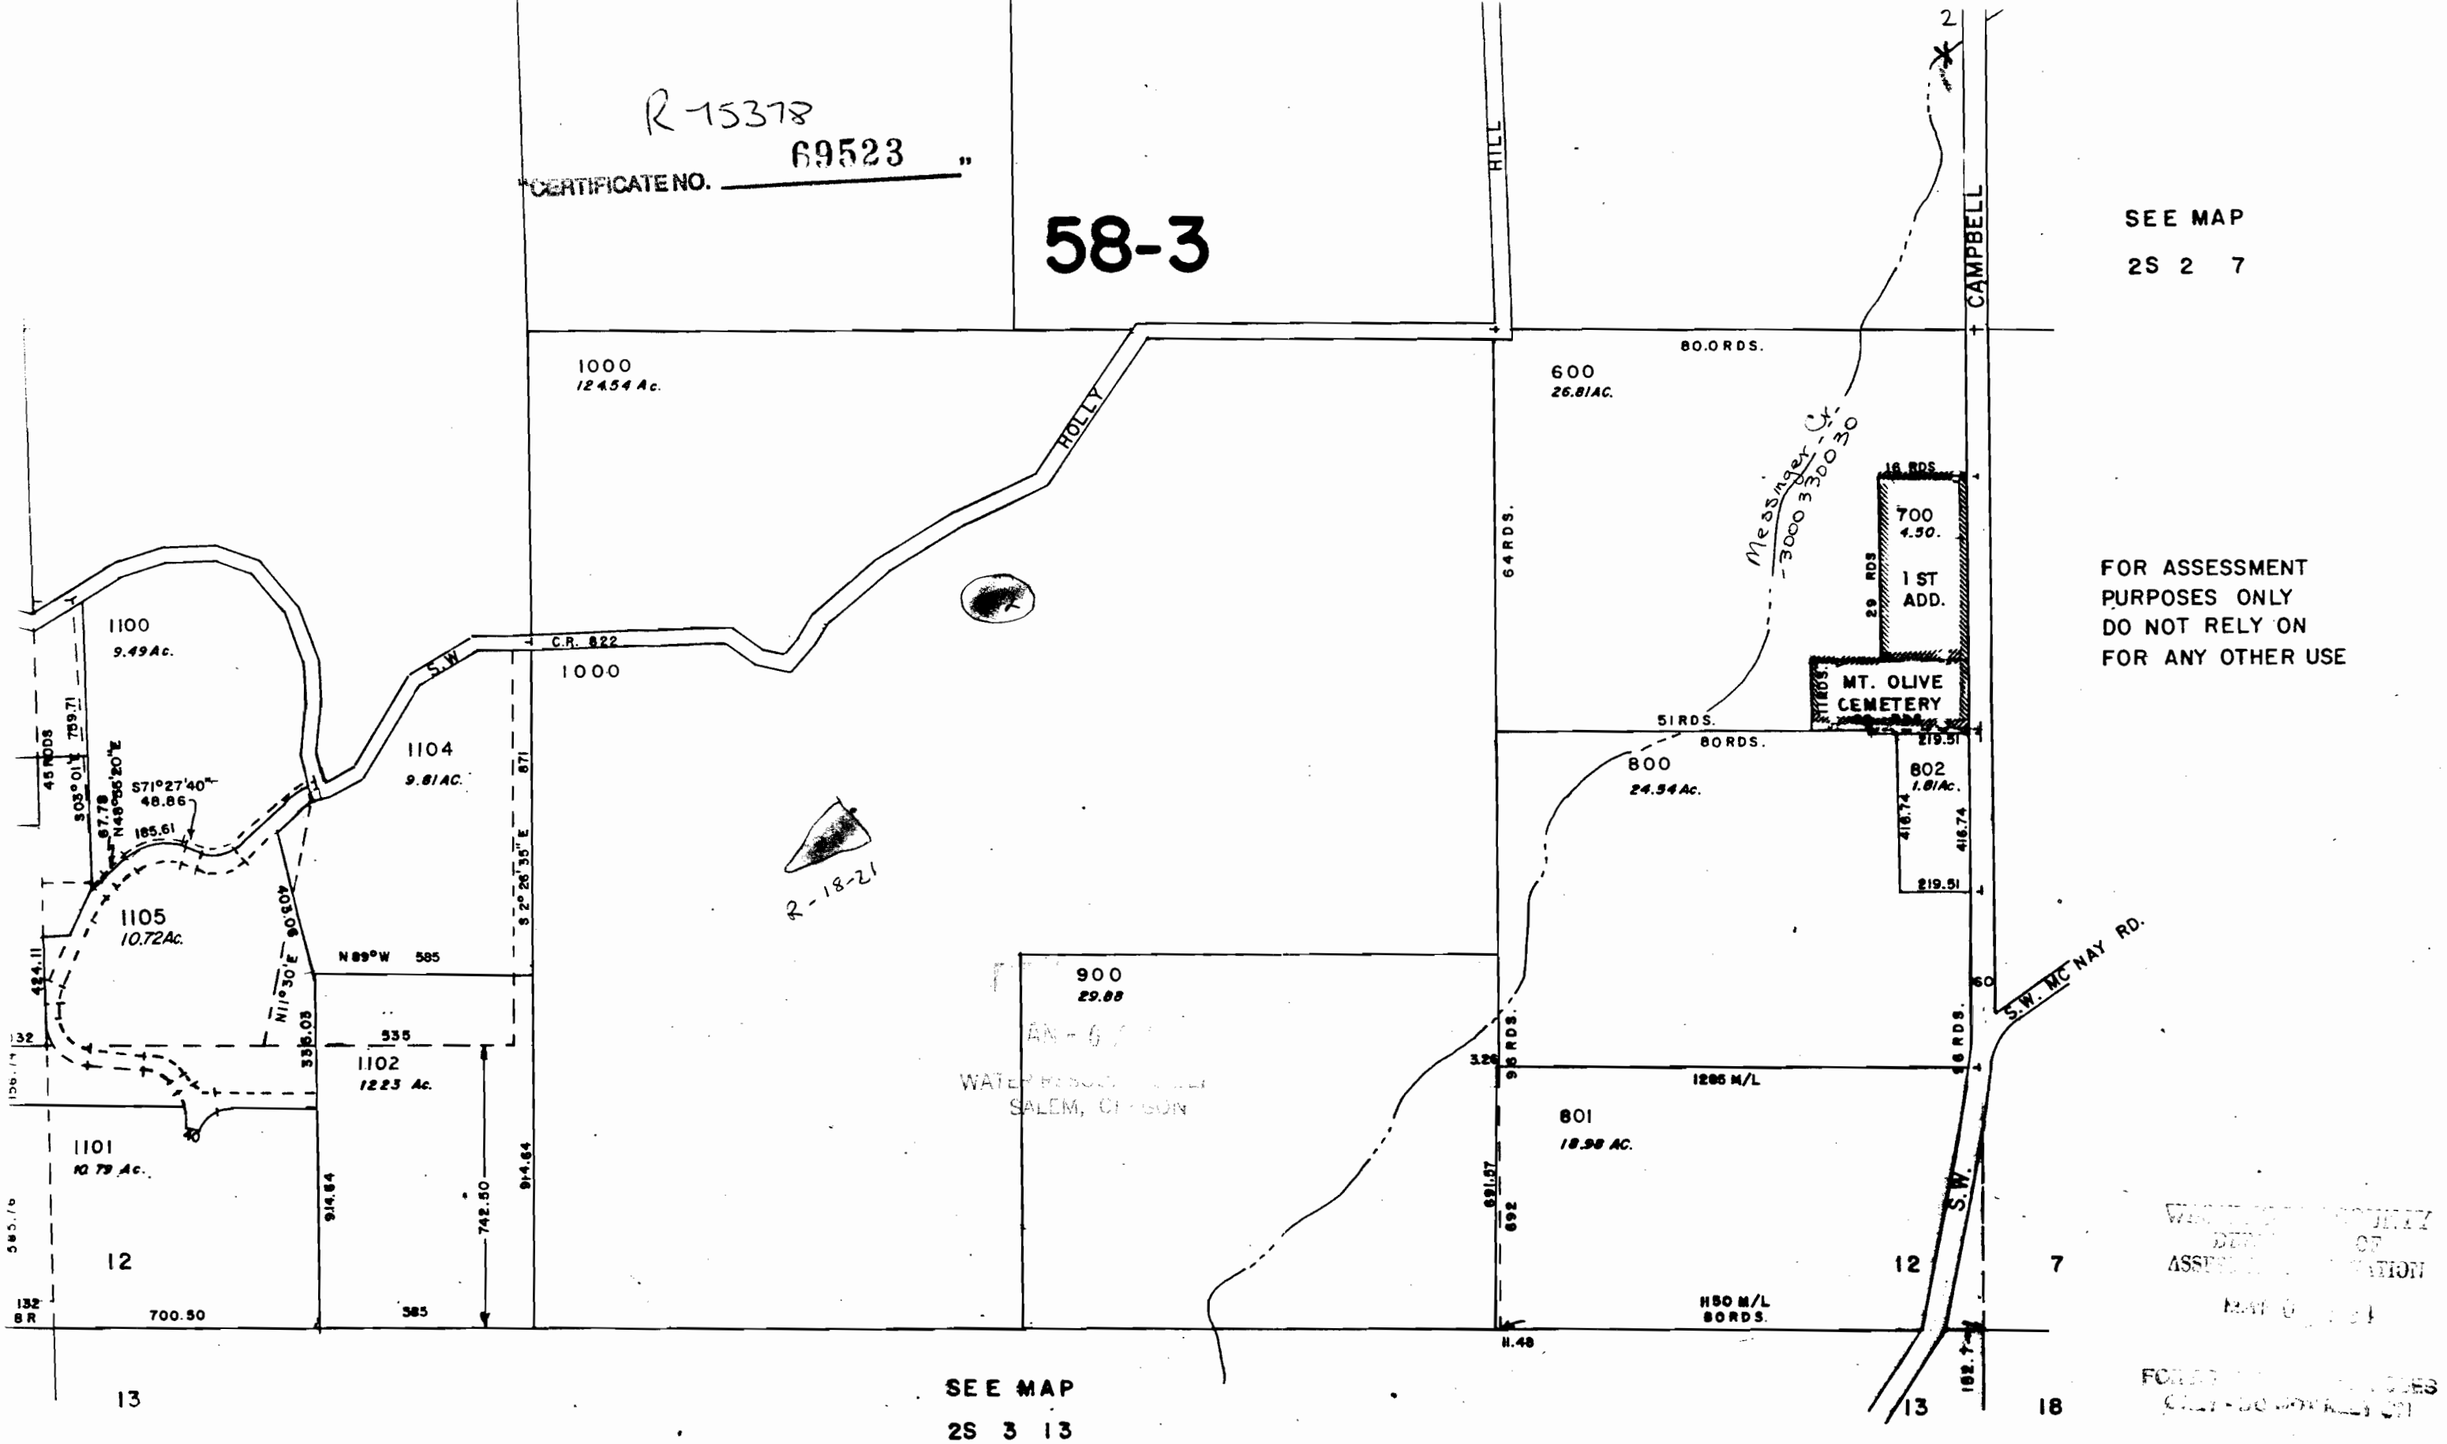
R-15378
CERTIFICATE NO. 69523
58-3
HILL
CAMPBELL
SEE MAP
2S 2 7
FOR ASSESSMENT
PURPOSES ONLY
DO NOT RELY ON
FOR ANY OTHER USE
1000
HOLLY
C.R. 822
S.W.
1100
9.49 Ac.
1104
9.81 AC.
1105
10.72 Ac.
1102
12.23 Ac.
1101
10.79 Ac.
S71°27'40"
48.86
185.61
N89°W 585
N11°30'E
871
S2°26'35"E
914.64
742.50
700.50
585
535
336.03
424.11
45 RODS
303°01'
789.71
87.78
N48°55'20"E
12
13
900
29.88
WATER RESOURCES DEPARTMENT
SALEM, OREGON
SEE MAP
2S 3 13
600
26.81AC.
80.0 RDS.
64 RDS.
Messinger Ck.
16 RDS
700
4.50.
29 RDS
1 ST
ADD.
MT. OLIVE
CEMETERY
51 RDS.
80 RDS.
219.51
800
24.54 Ac.
802
1.81 Ac.
416.74
219.51
S.W. McNAY RD.
96 RDS.
1285 M/L
801
18.98 AC.
691.67
692
1150 M/L
80 RDS.
11.48
12
7
13
18

