

THIS MAP WAS PREPARED FOR
ASSESSMENT PURPOSE ONLY
AVAILABLE FROM DCGIS


SECTION 26 T28S R5W WM
DOUGLAS COUNTY

Application No. R-75399
Permit No.

28 5 26

REVISED ON
6/24/92

1" = 400'

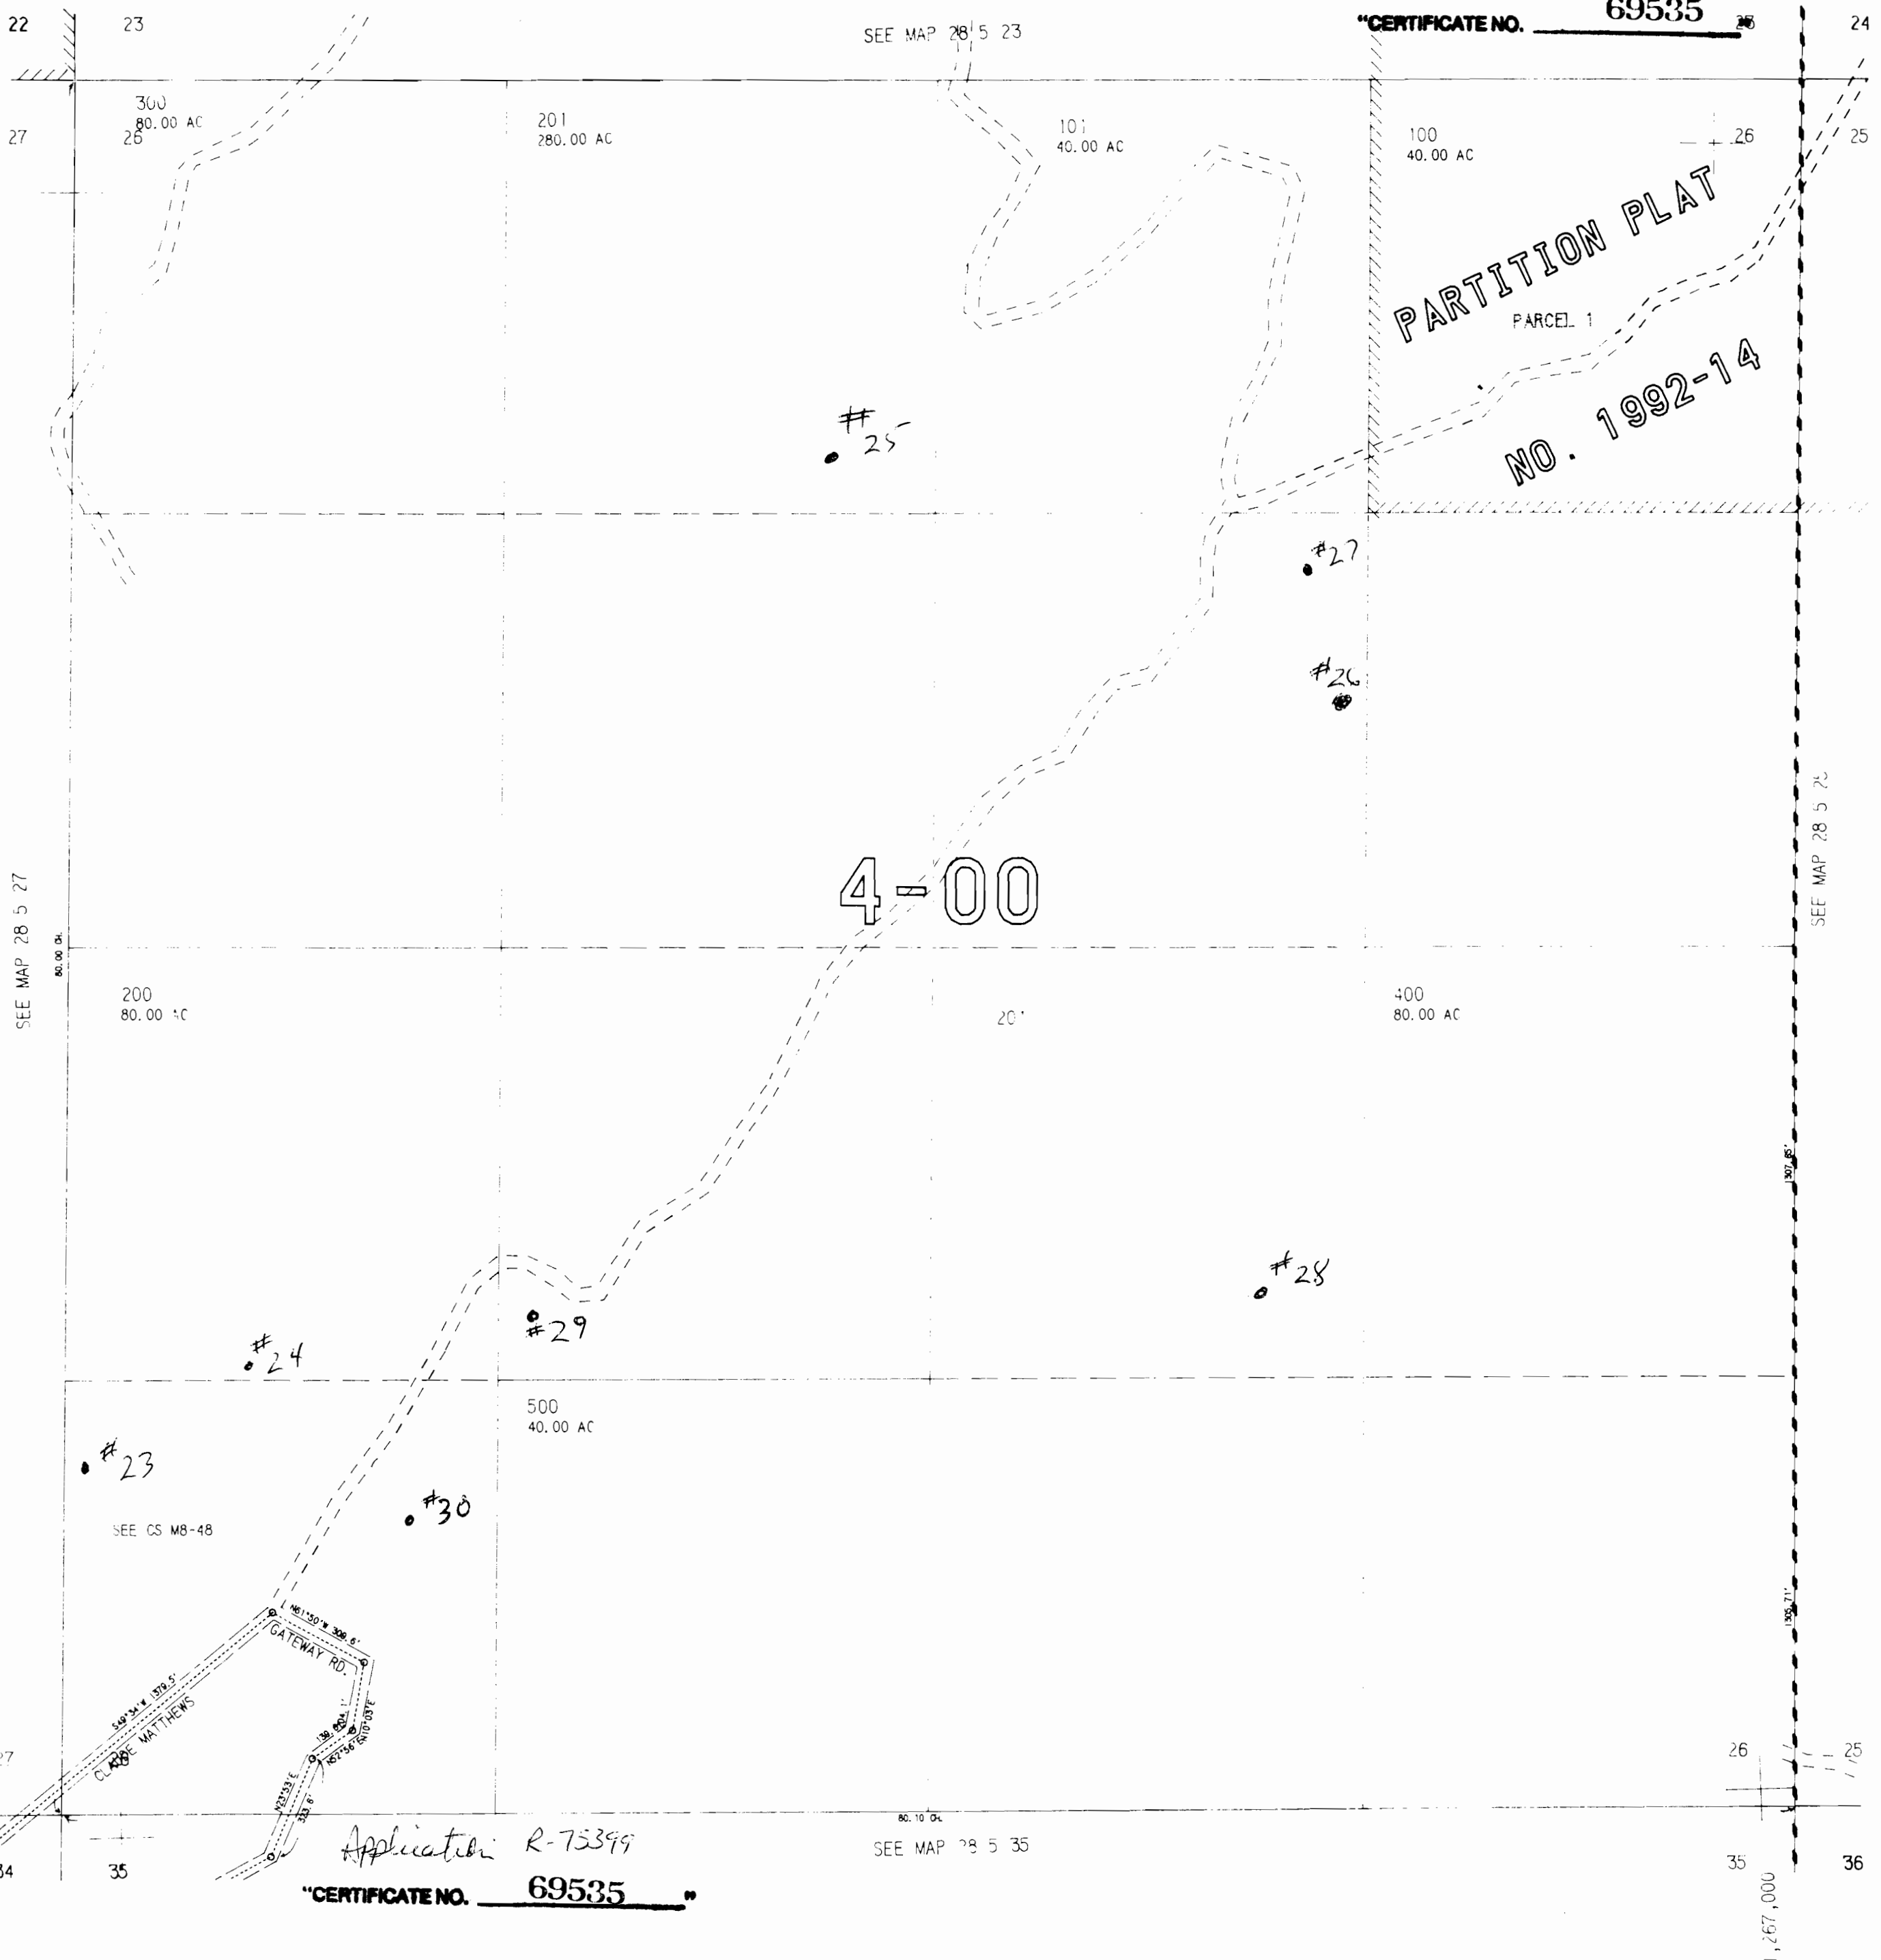

CANCELLED NO'S

534,000

28 5 26

1"-400'

Application No. R-75399
Permit No.

22 | 23

S89° 43'E 40.20 CH.

27	26
----	----

100
280.00 AC.

300
119.19 AC.

4-00

100

SEE MAP 28 5 26

SEE MAP 28 5 28

CLARK'S BRANCH
CO. RD. NO. 105

400
160.00 AC.

SEE CS MB-48

#22

GATEWAY RD.

CLAUDE MATTHEWS
GATEWAY RD.

27 | 26

SEE MAP 28 5 34

Applicant: R-75399
"CERTIFICATE NO. 69535"

28 5 27

1,262,000

SECTION 35 T.28S. R.5W. W.M.
DOUGLAS COUNTY

THIS MAP WAS PREPARED FOR
ASSESSMENT PURPOSE ONLY.


Application R-75399

1"=400'

Application No. R-75399
Permit No.

CERTIFICATE NO. 69535

SEE MAP 28 5 26

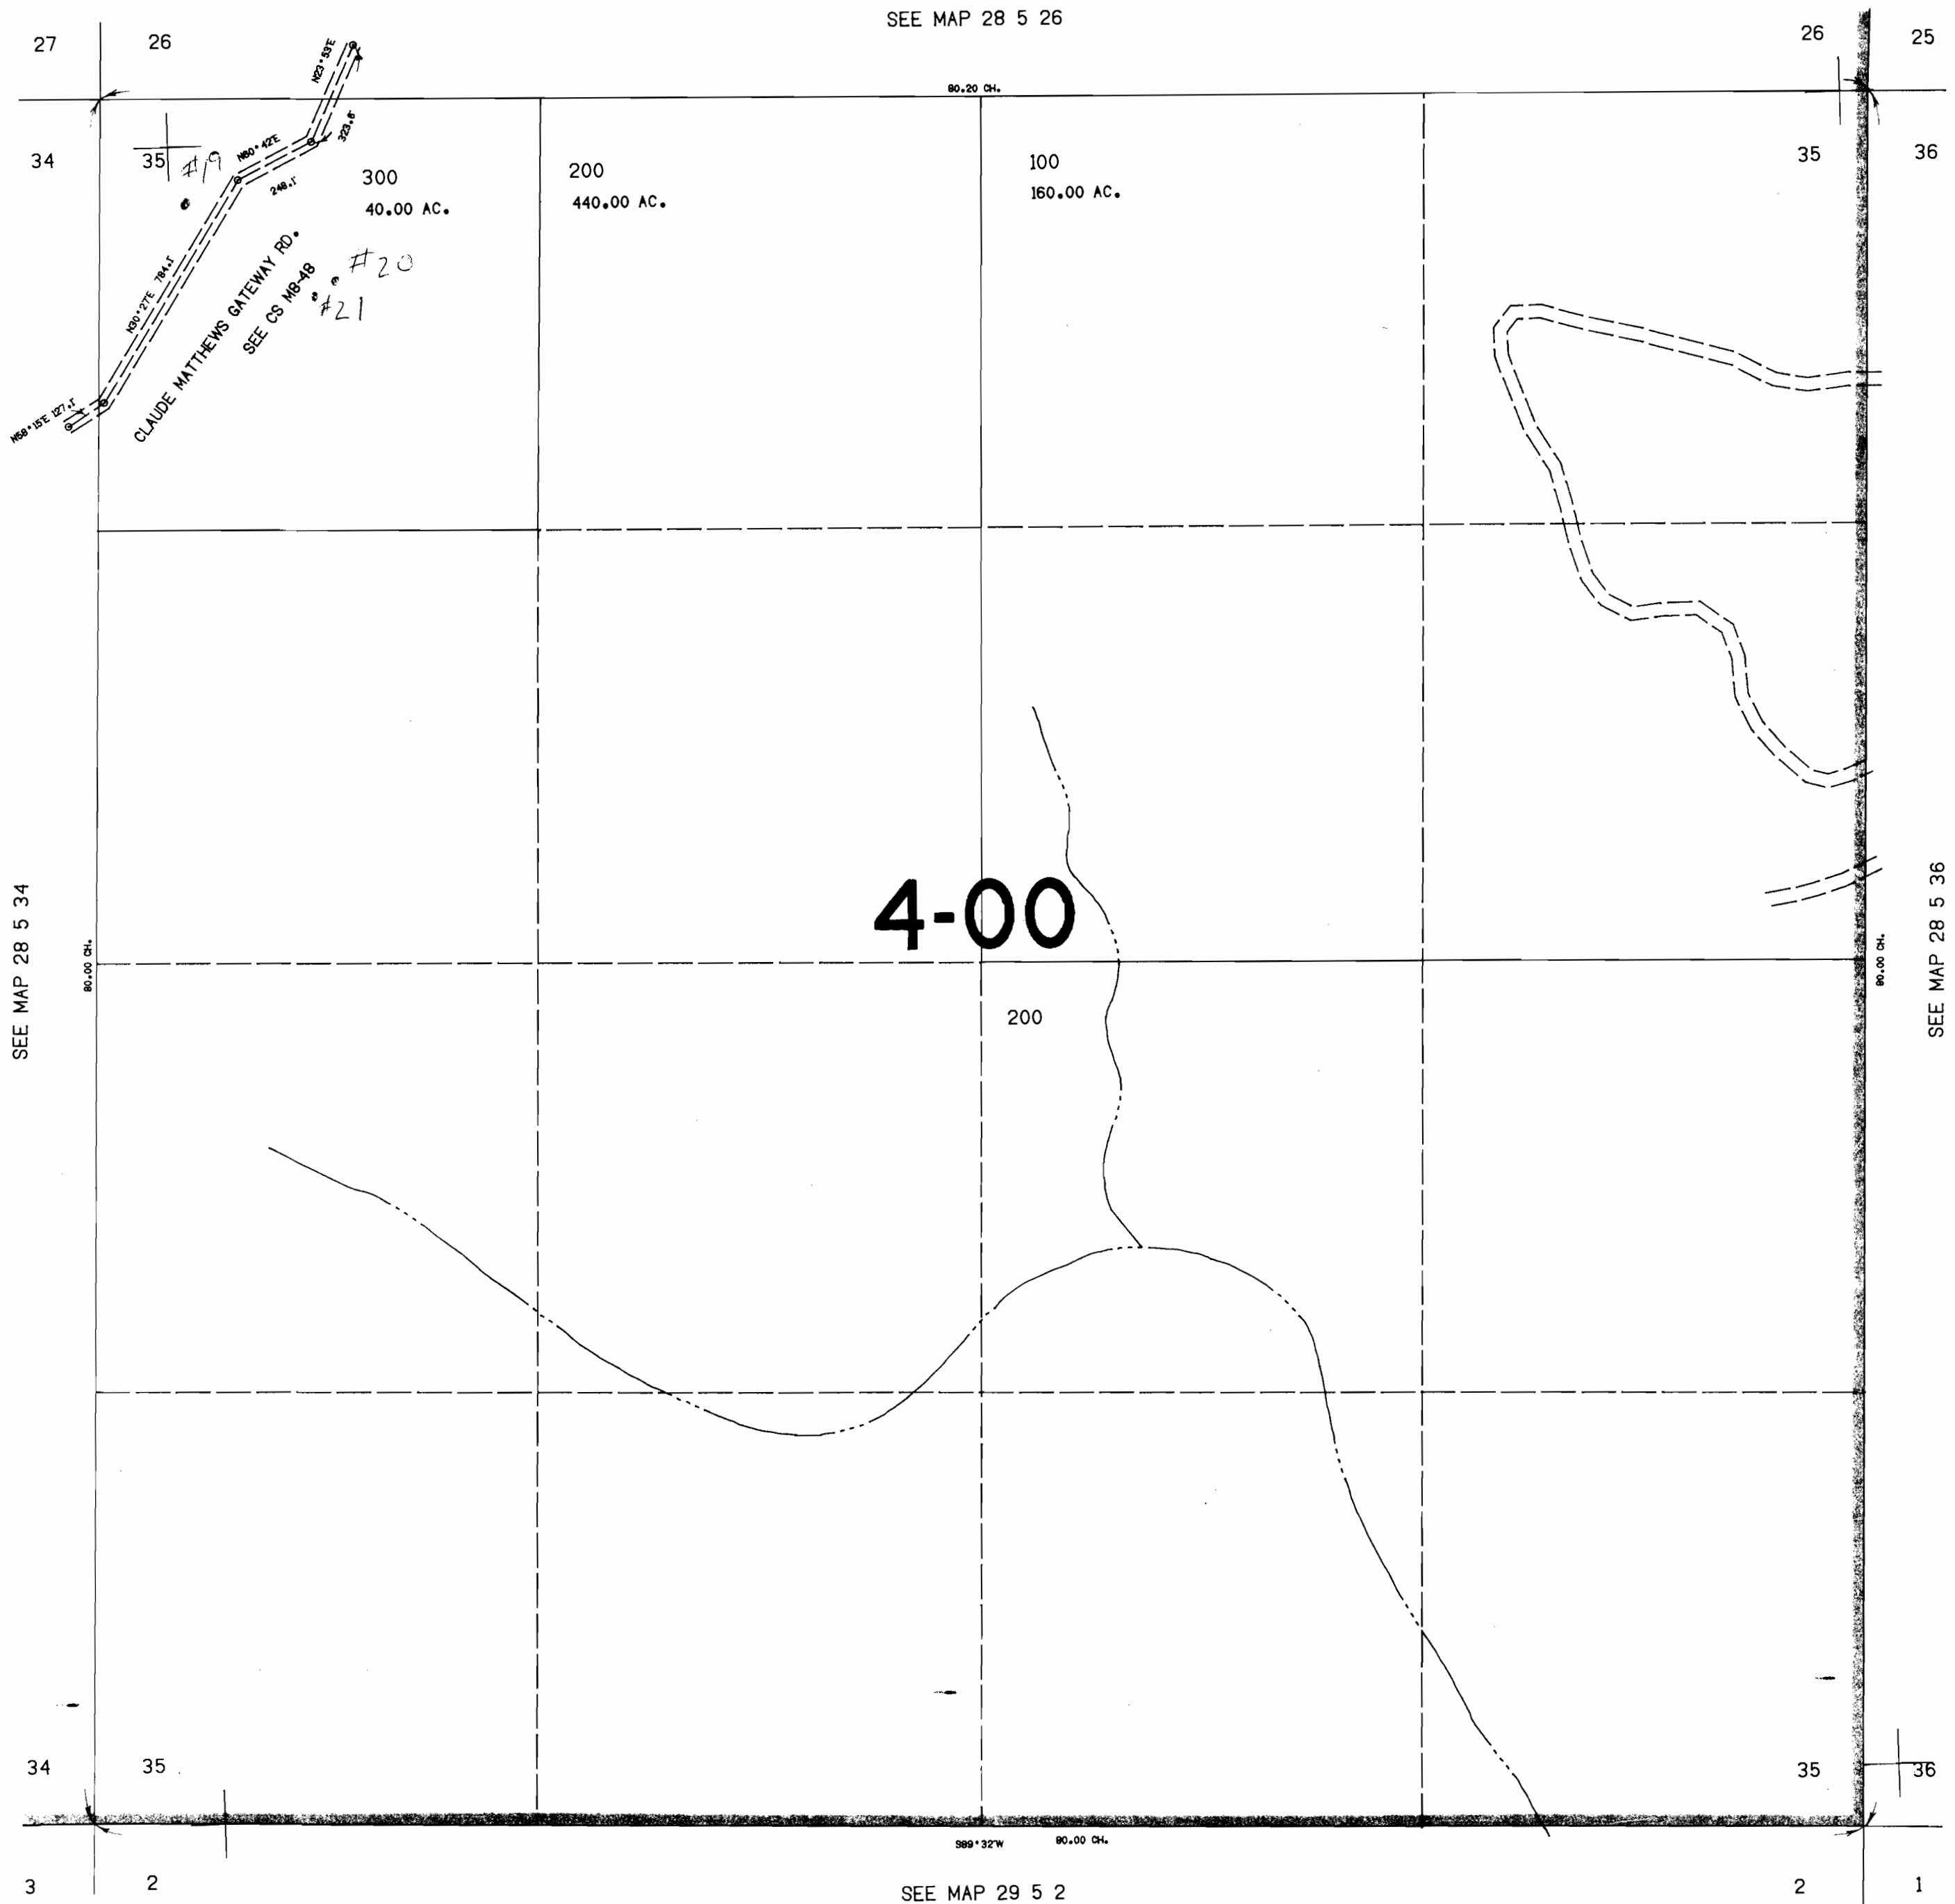


1"-400'

Application No. R-75399
Permit No.

Application R-75399
"CERTIFICATE NO. 69535

"CERTIFICATE NO. 69535

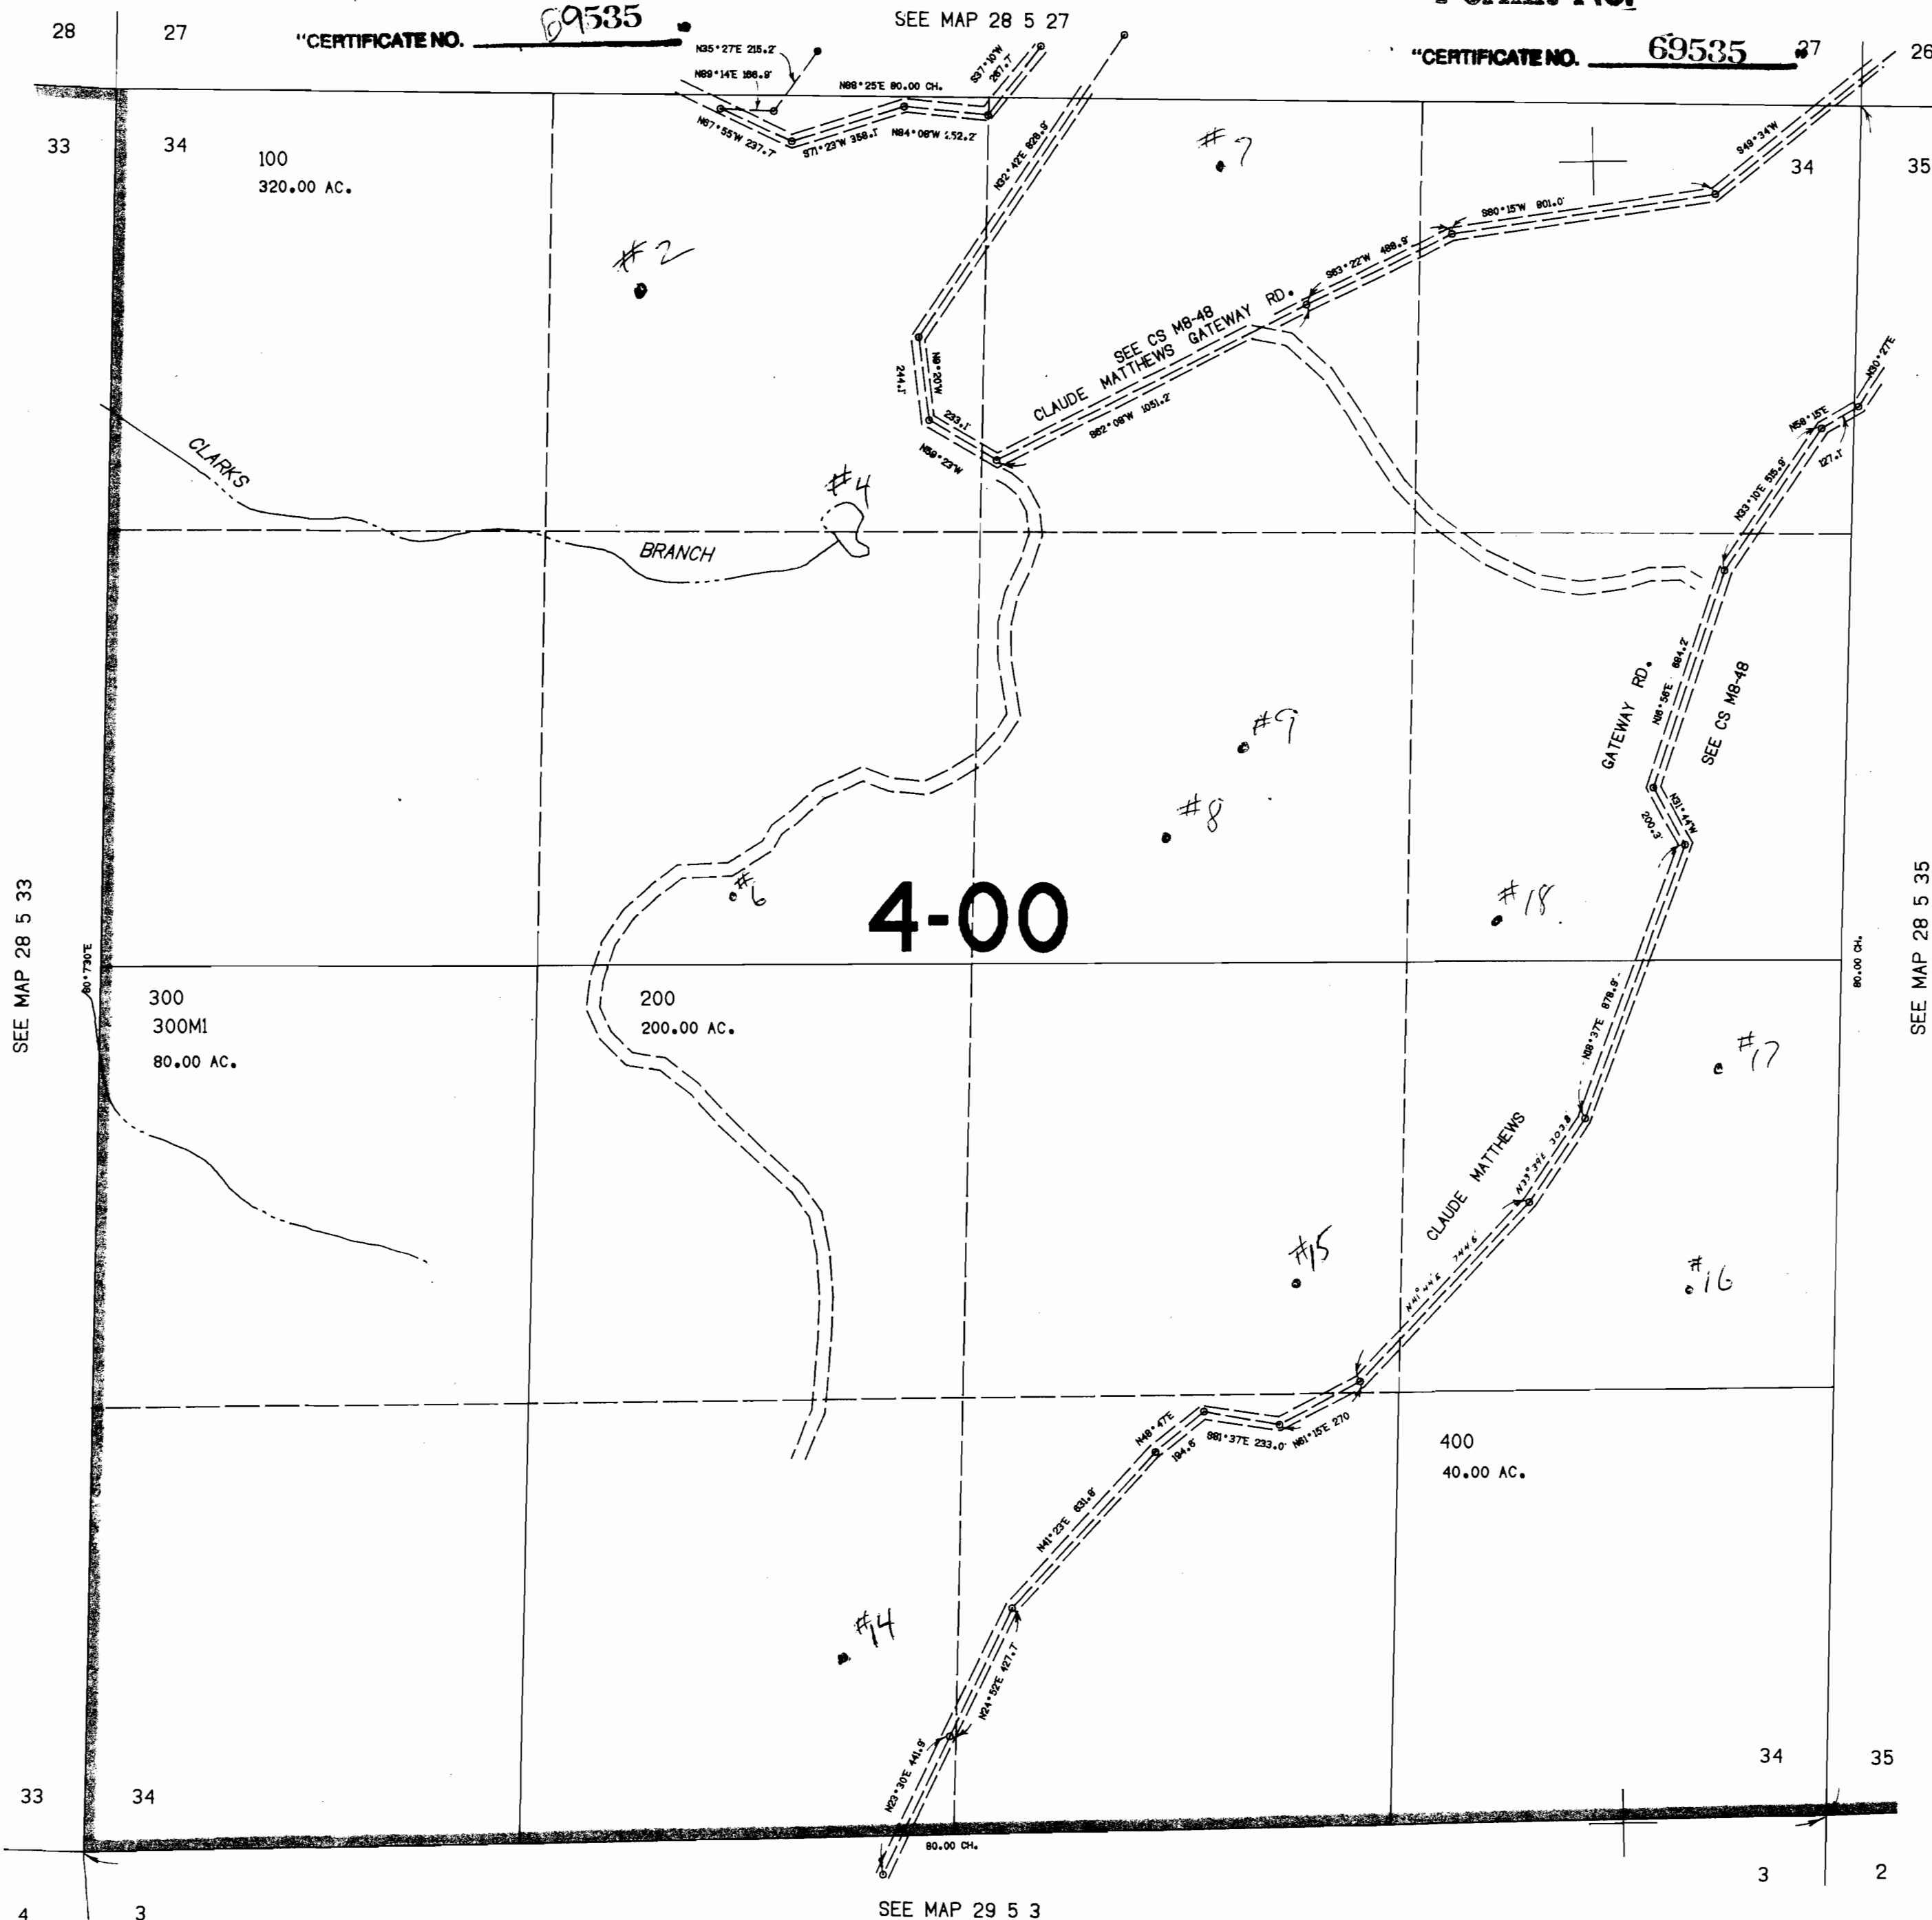

529.000

28 5 34

1.261.000

This map was prepared for
the purpose of showing only

SECTION 4 T.29 S. R. 5 W. W.M.
DOUGLAS COUNTY

REVISED ON
10-5-92

69535

29 5 4

"CERTIFICATE"
Application No. R-15399
Permit No.

SEE MAP 28 5 33

1" = 400'

5291.42' 589°59'42"E APPROX 1/4 COR.

2645.8'

32 33

5 4
200
200MI
202.98Ac.

100
162.98Ac.

4 3

LOT 41.49
RICHARDSON

LOT 41.49

LOT 41.49

LOT 41.49

CREEK

200 MI

19-00

APPROX
1/4 COR.

CS
M 81.24

300
40.00Ac.

400
200.00Ac.

CS
51.130

APPROX
1/4 COR.

M 25.20

#13

#11

525,000

500
40.00Ac.

40 CH = 2040'

APPROX
1/4 COR.

80.35 CH = 3213.1'

SEE MAP 29 5 9

1255,000

29 5 4

SECTION 3 T.29S. R.5W. W.M.
DOUGLAS COUNTY

$$l'' = 400'$$

Application No. R-75399
Permit No.

This map was prepared for
assessment purpose only.

Application: R 75399

"CERTIFICATE NO.

33

34

SEE MAP 28 5 34

34

35

$$80 \text{ Ch} = 5280'$$

4

3

300
121.48 AC

#10

LOT 41.48

100
164 08 AC.

LOT 41.42

LOT 4136

LOT 4130

3

2

135828

[illegible]

50° 10' E.

SEE MAP 29 5 2

SEE MAP 29 5 4

30.30.7

40 ch 2640

4

3

SEE M 5-38

WEST 80 44 Cn = 5309.04'

SEE MAP 29 5 10

10

19

90 5.4 2.640

525,000

19-00

400
280 00 AC.

ROCK CREE

1,260,000