


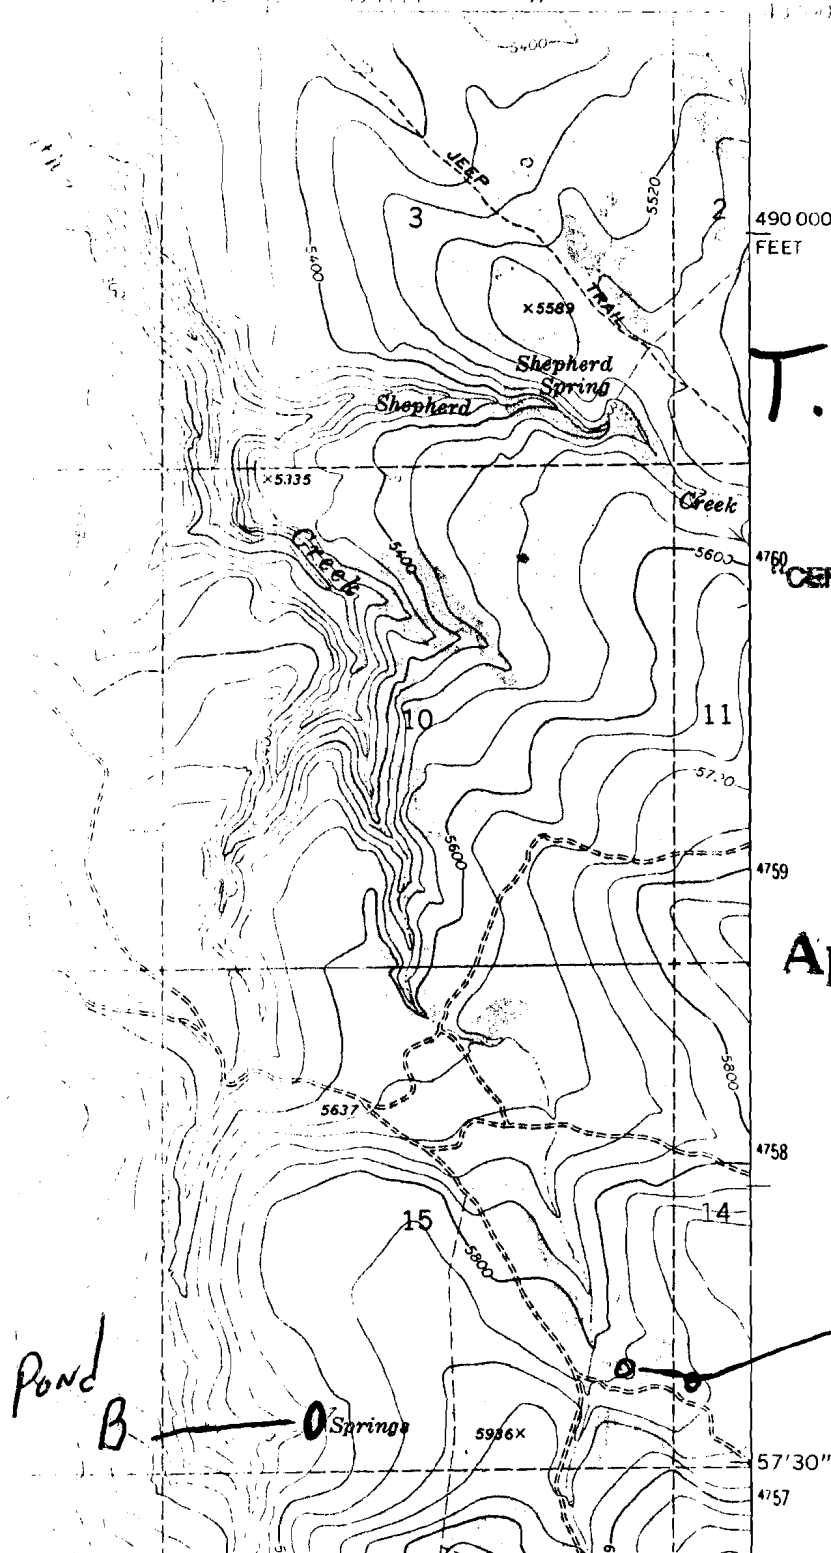

T.30S., R 34E.

W.M.

CERTIFICATE NO. 69549

Application No. R-75414
Permit No.POISON SPRINGS, OREG.
N4252.5—W11830/7.5

1968

AMS 2269 I NE—SERIES V892