


T. 30 S., R. 34 E. W.M.

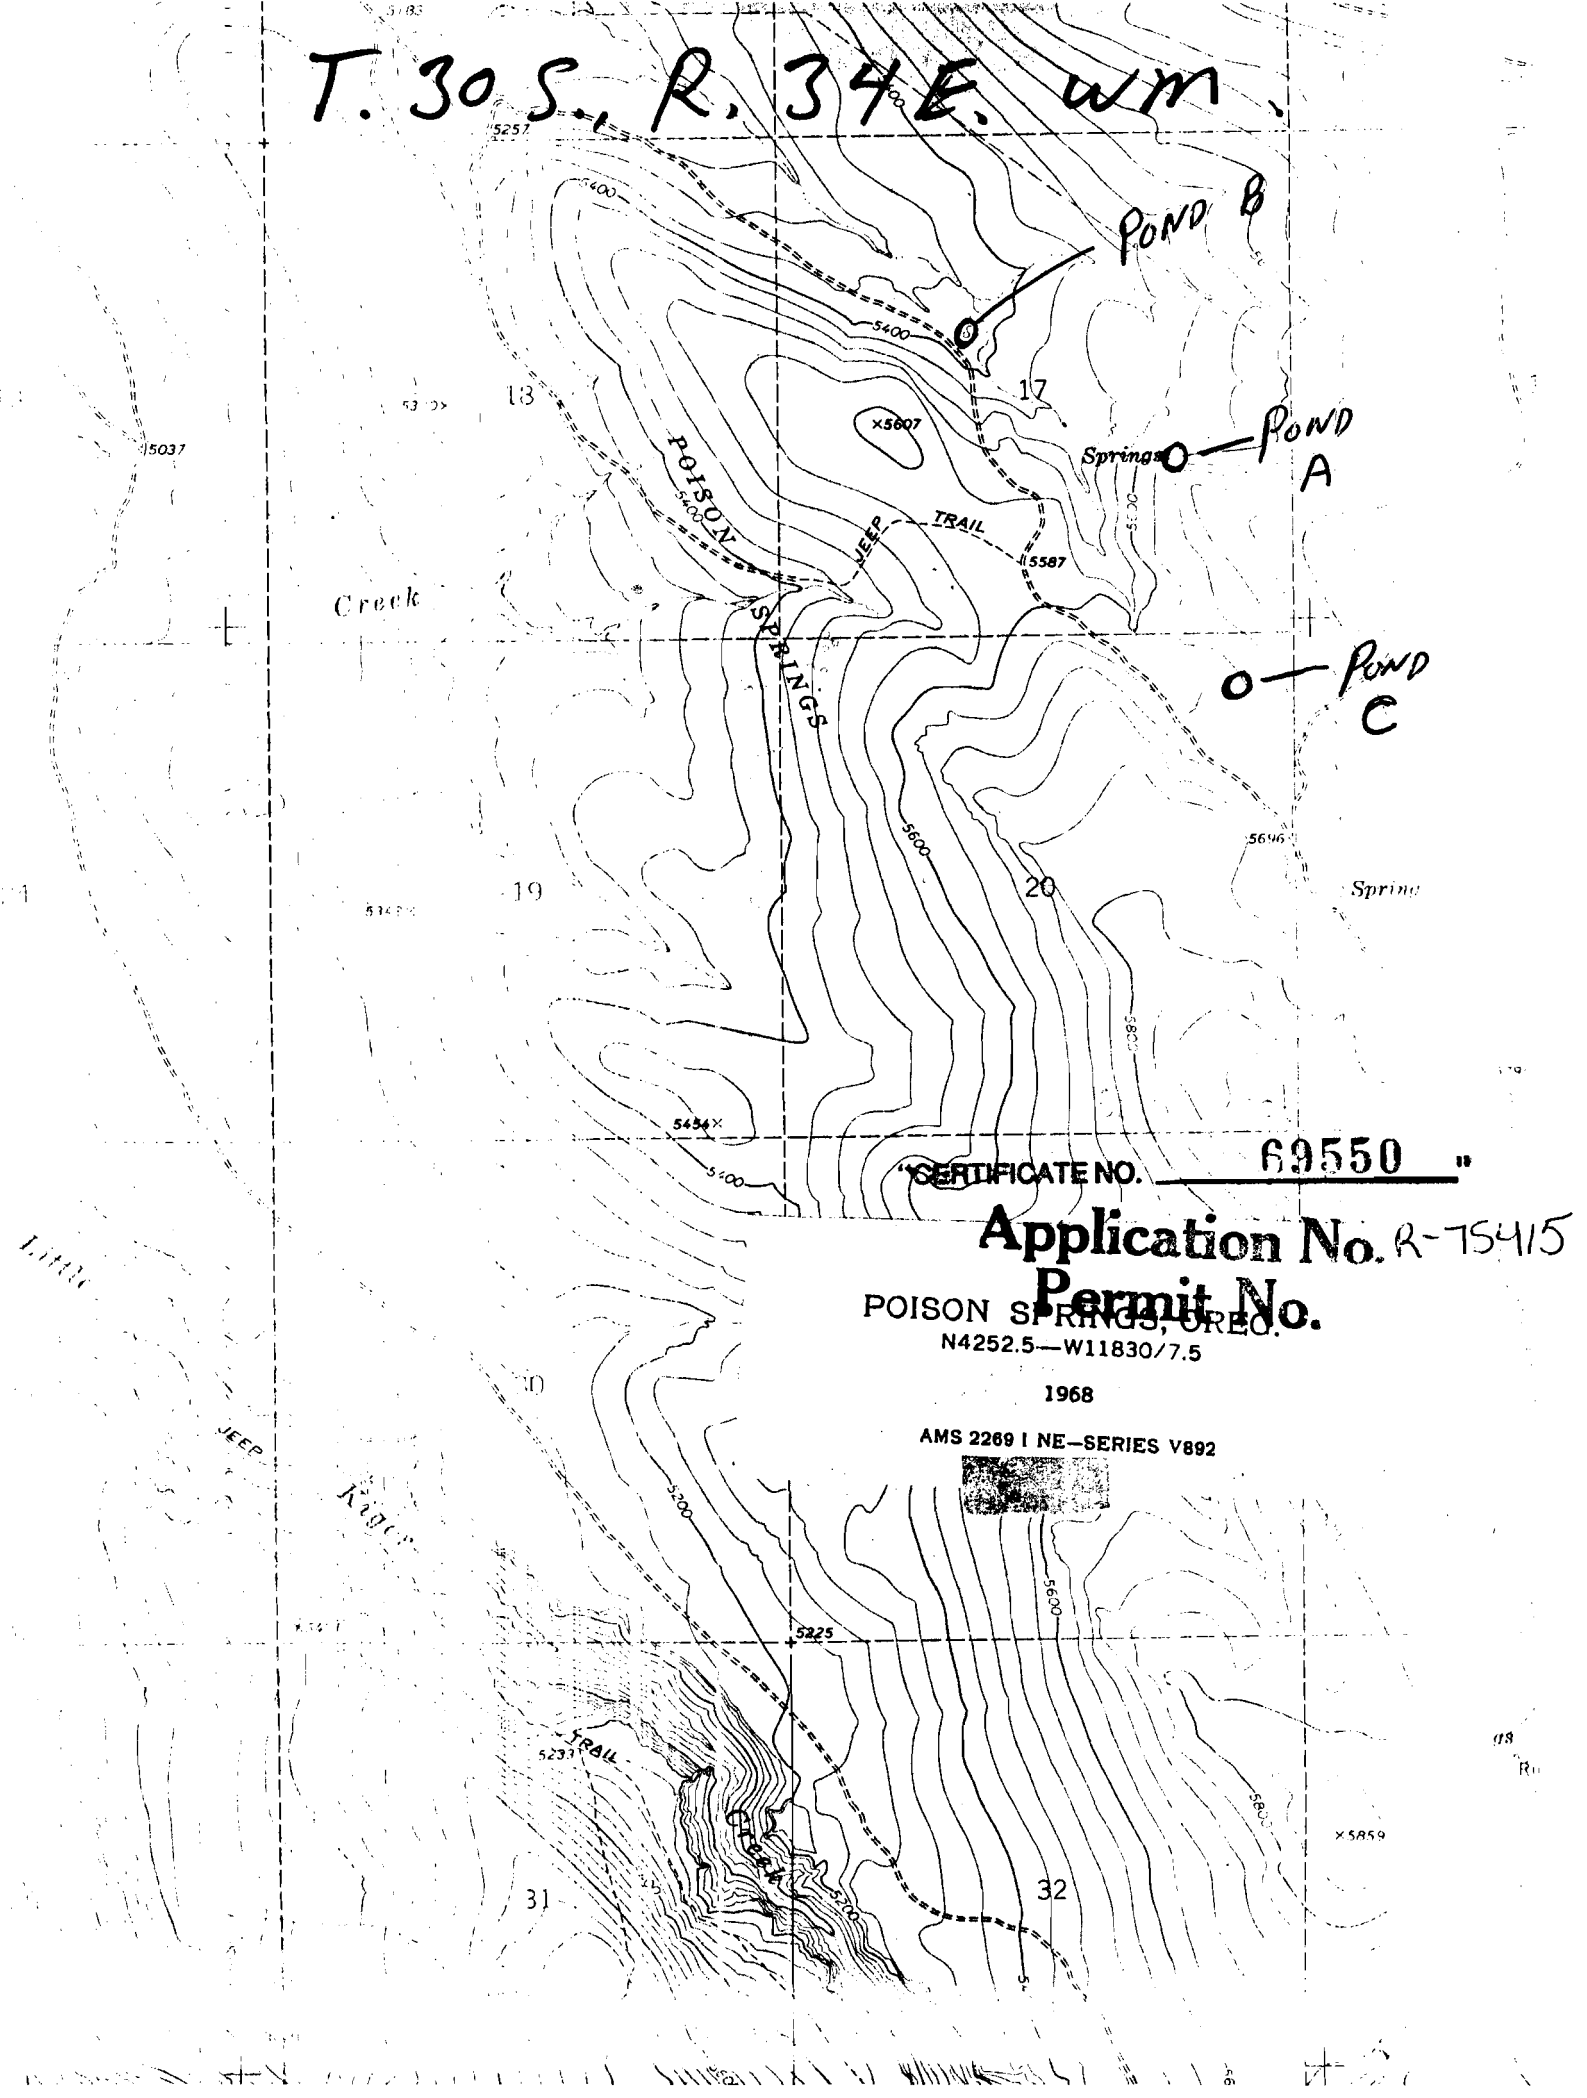

CERTIFICATE NO. 69550

Application No. R-75415

Permit No.

POISON SPRINGS, OREG.
N4252.5—W11830/7.5

1968

AMS 2269 I NE—SERIES V892



X5859