


Application No R-75416
Permit No.

CERTIFICATE NO. 69551 "

T. 30 S. R. 34 E. W.M.

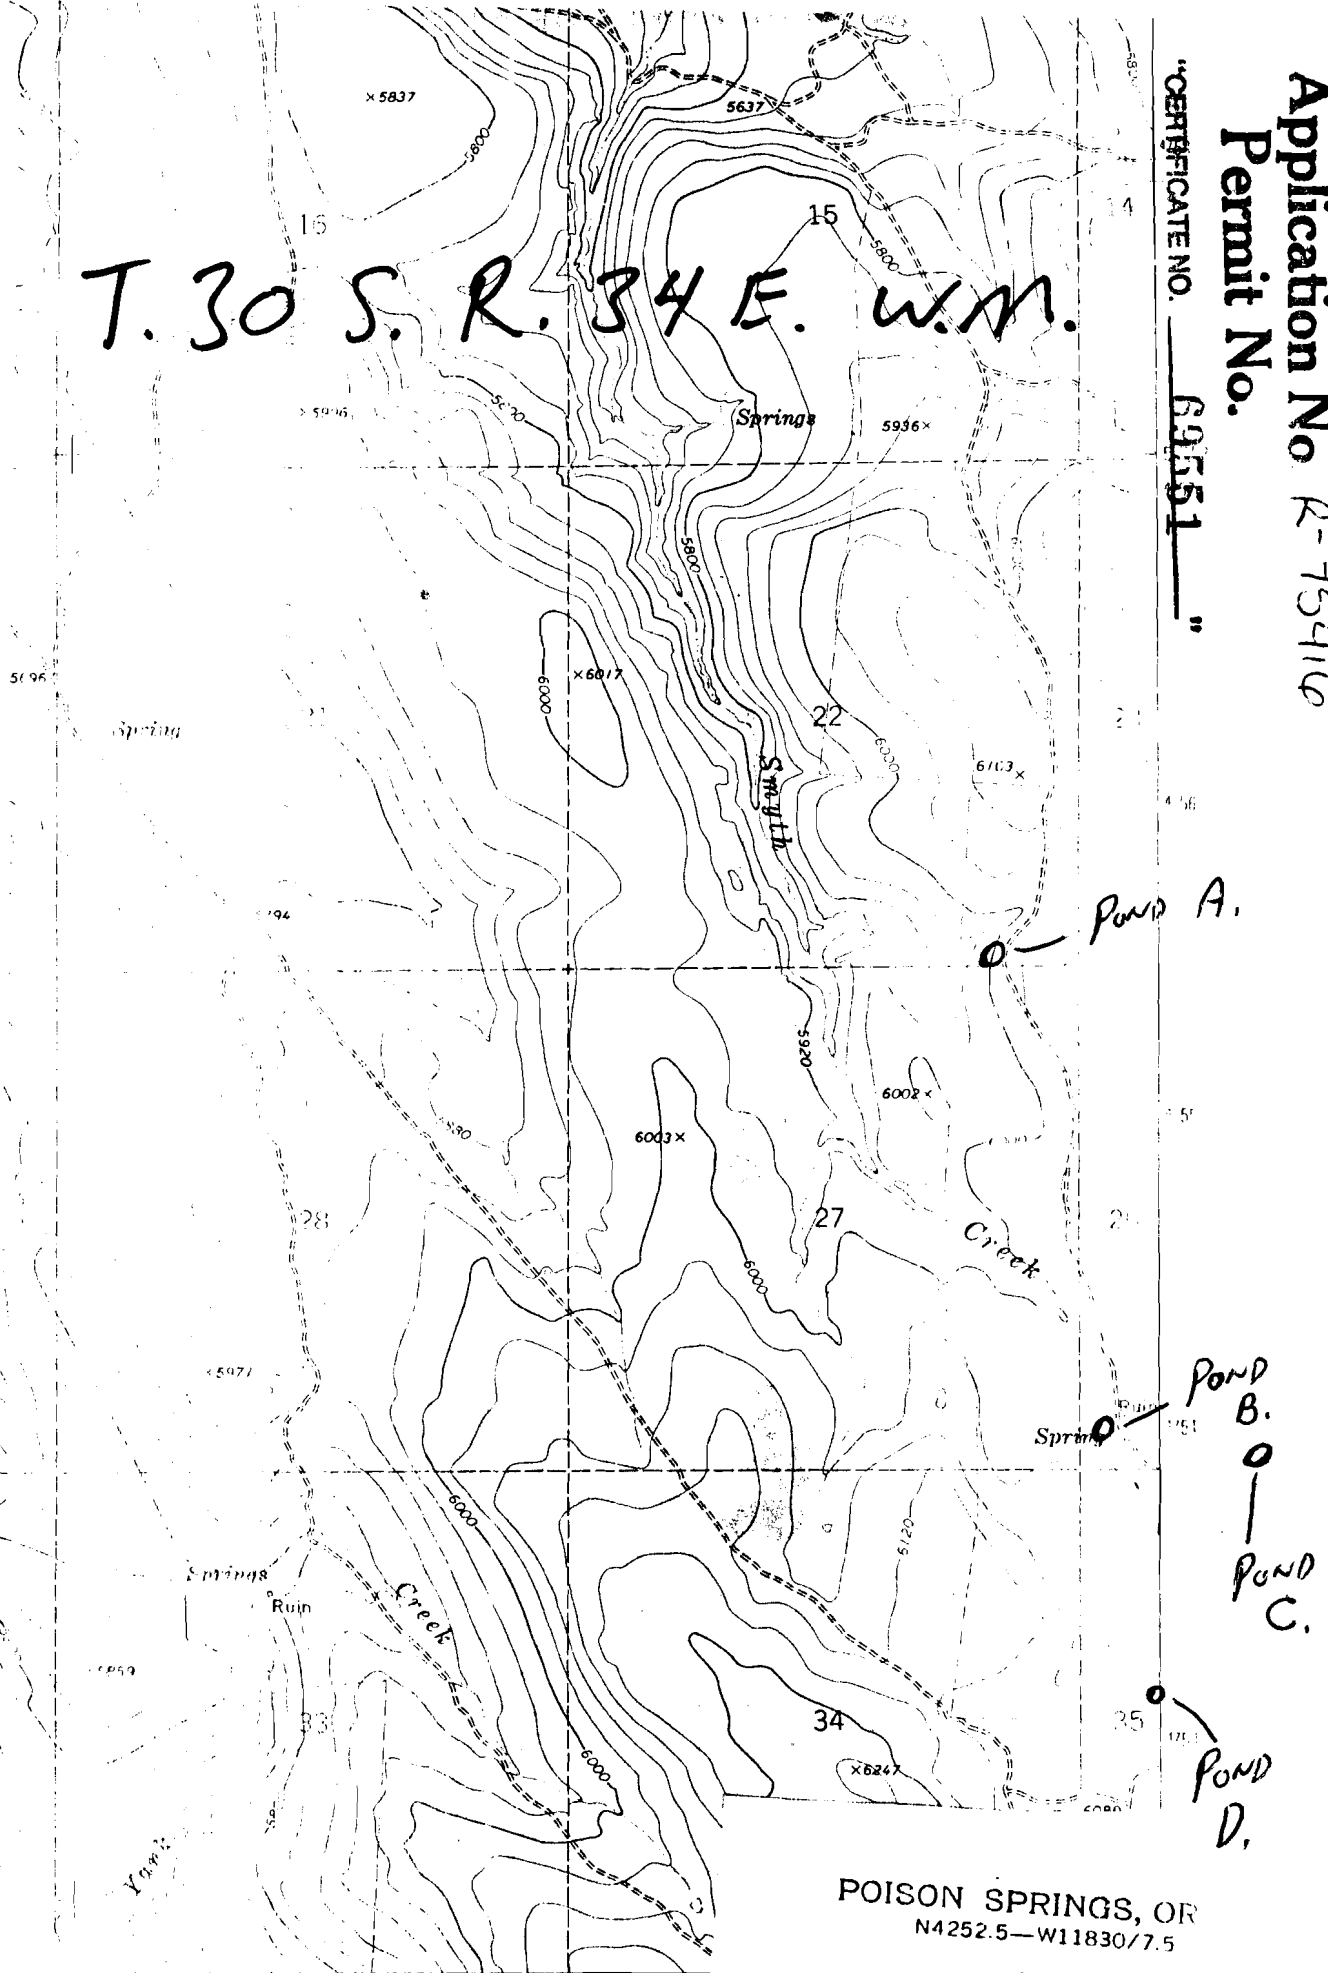

POISON SPRINGS, OR
N4252.5-W11830/7.5

1968

AM 1200 LINE 1000000