


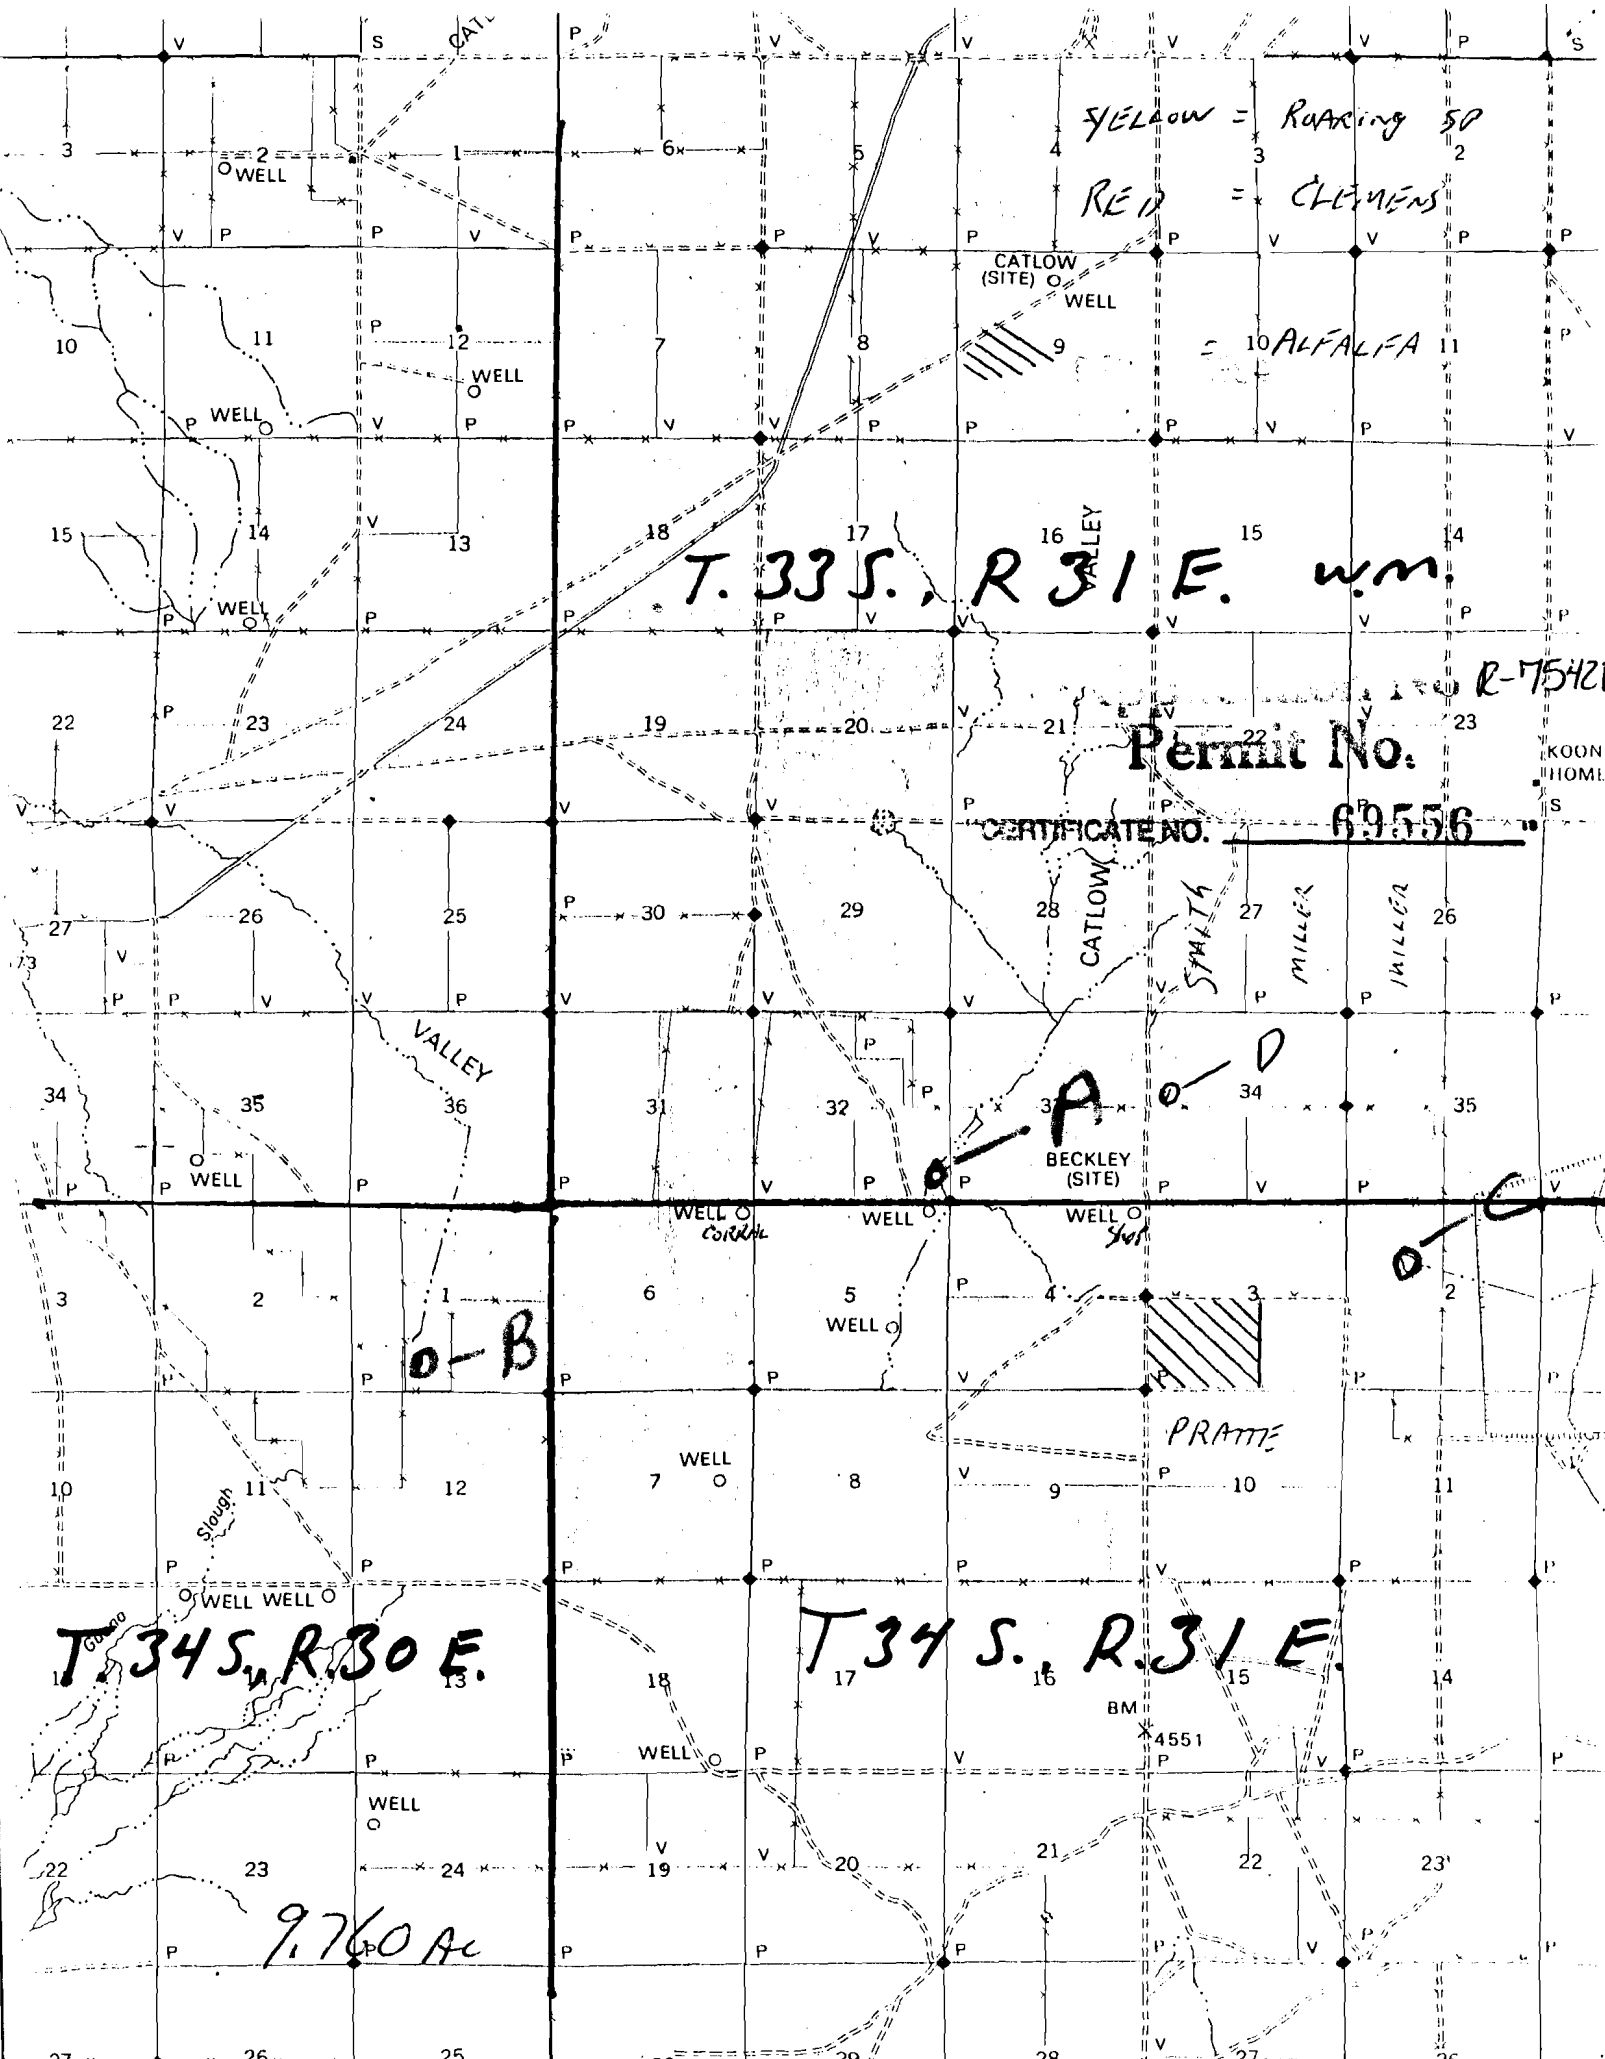

RED = CLEMENS

ALFALFA

T. 33 S., R. 31 E. W.M.

R-75421

Permit No.

CERTIFICATE NO. 69556

KOOK HOME

BECKLEY (SITE)

PRATTE

T. 34 S., R. 30 E.

T. 34 S., R. 31 E.

9.760 Ac

BM 4551