

LAKE

25 30
36 31

SEE MAP 40 19

30 29
31 32

40 19 31

SCALE 1:9600




Application No. R-75425
Permit No.

CANCELLED NO'S
600

WATER RIGHT NO. 69559

SEE MAP 40 18

pond

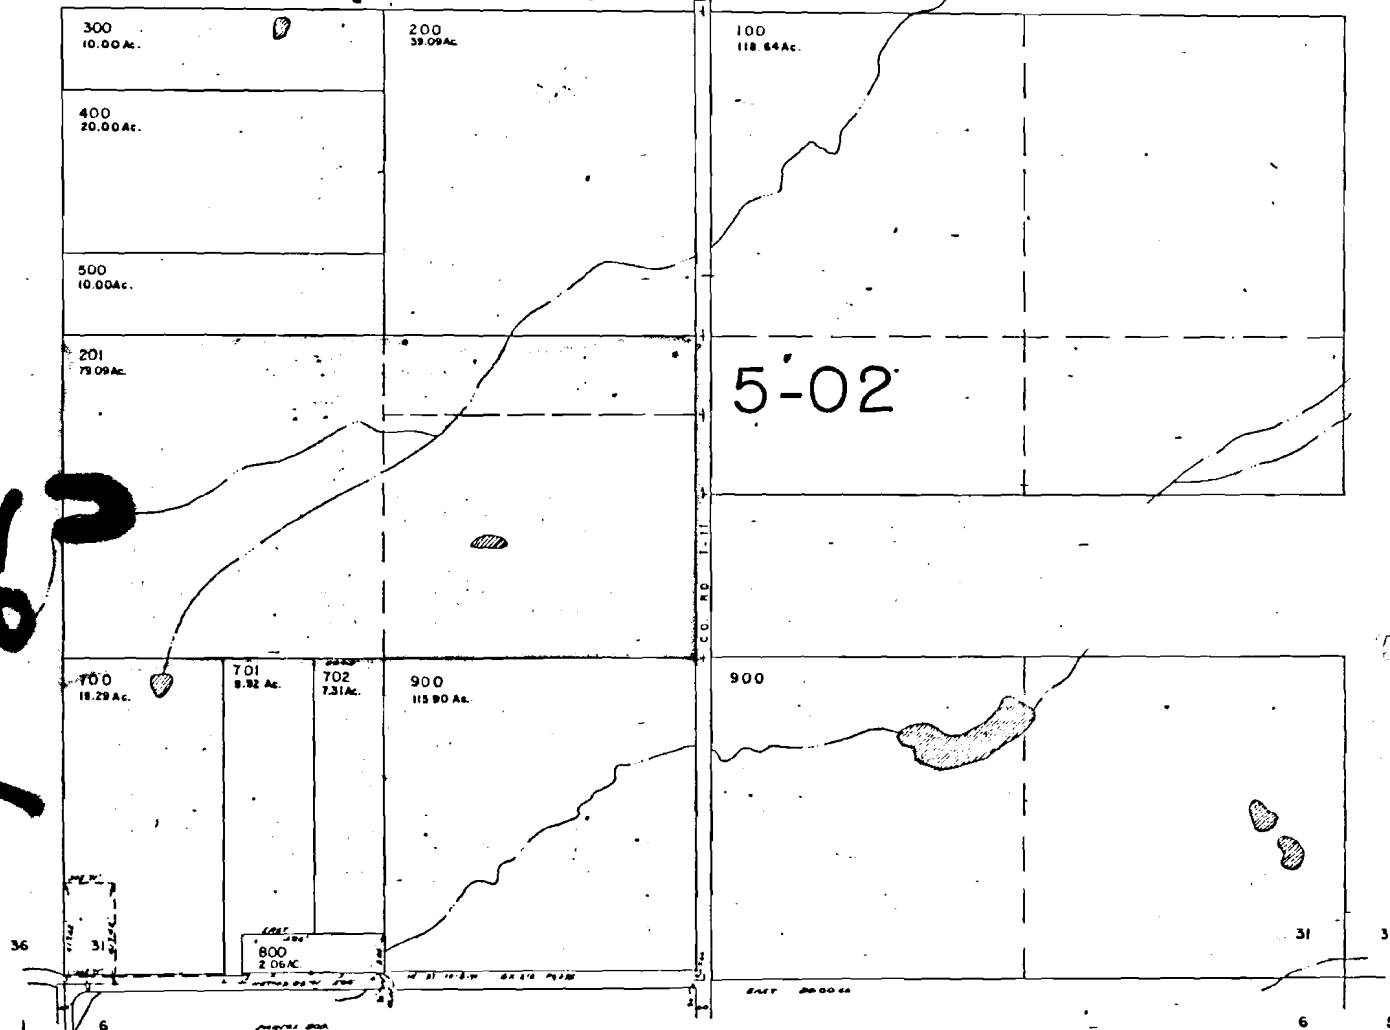

SEE MAP 40 19

OCT 2 1994

RECEIVED
JAN 13 1992
DEPT. OF REVENUE STATE OF OREGON
ASSESSMENT & APPRAISAL DIV.