



LEAVELL PROPERTY

25091 So. Central Pt. Rd.
Canby, OR. 97013

BRASS COR (1/4)

T4S-R1E-SECT 12

LOTS 600, 700, 800, 901

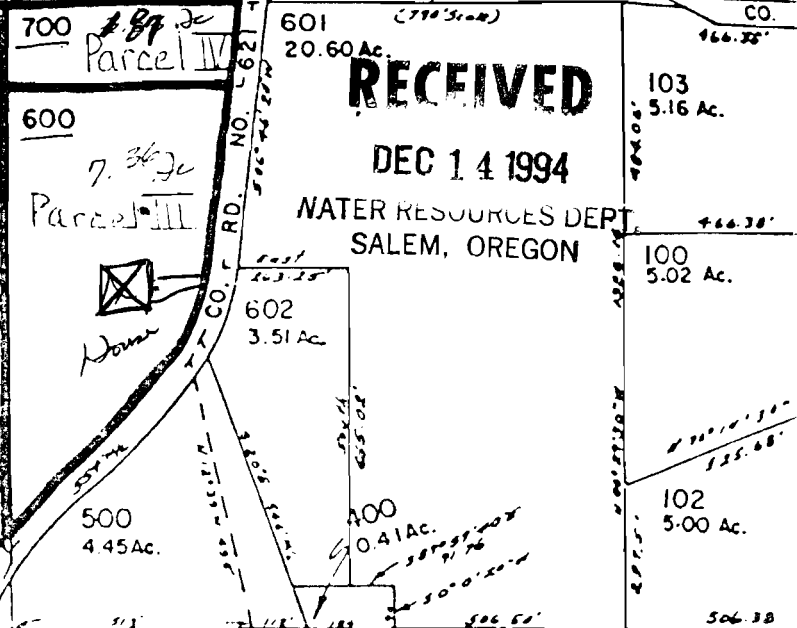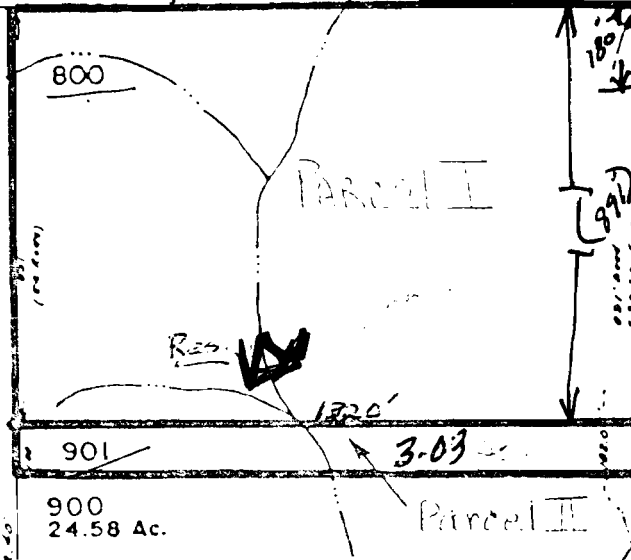

RECEIVED

DEC 14 1994

WATER RESOURCES DEPT.
SALEM, OREGON

Washington Mutual
The friend of the family®

DESCR.

T4S-R1E

SECT 12

LOT 800 (NENLW)

RESERVOIR LOCATION
11/25/94


SAFECO



"This policy is for your aid in
losses covered with reference
to the policy and its conditions.
We do not assume liability for
losses or for any loss occurring
by reason of reliance thereon."

ORDER NO. C-33945

SAFECO LIFE INSURANCE COMPANY
MILWAUKEE, OREGON 97222

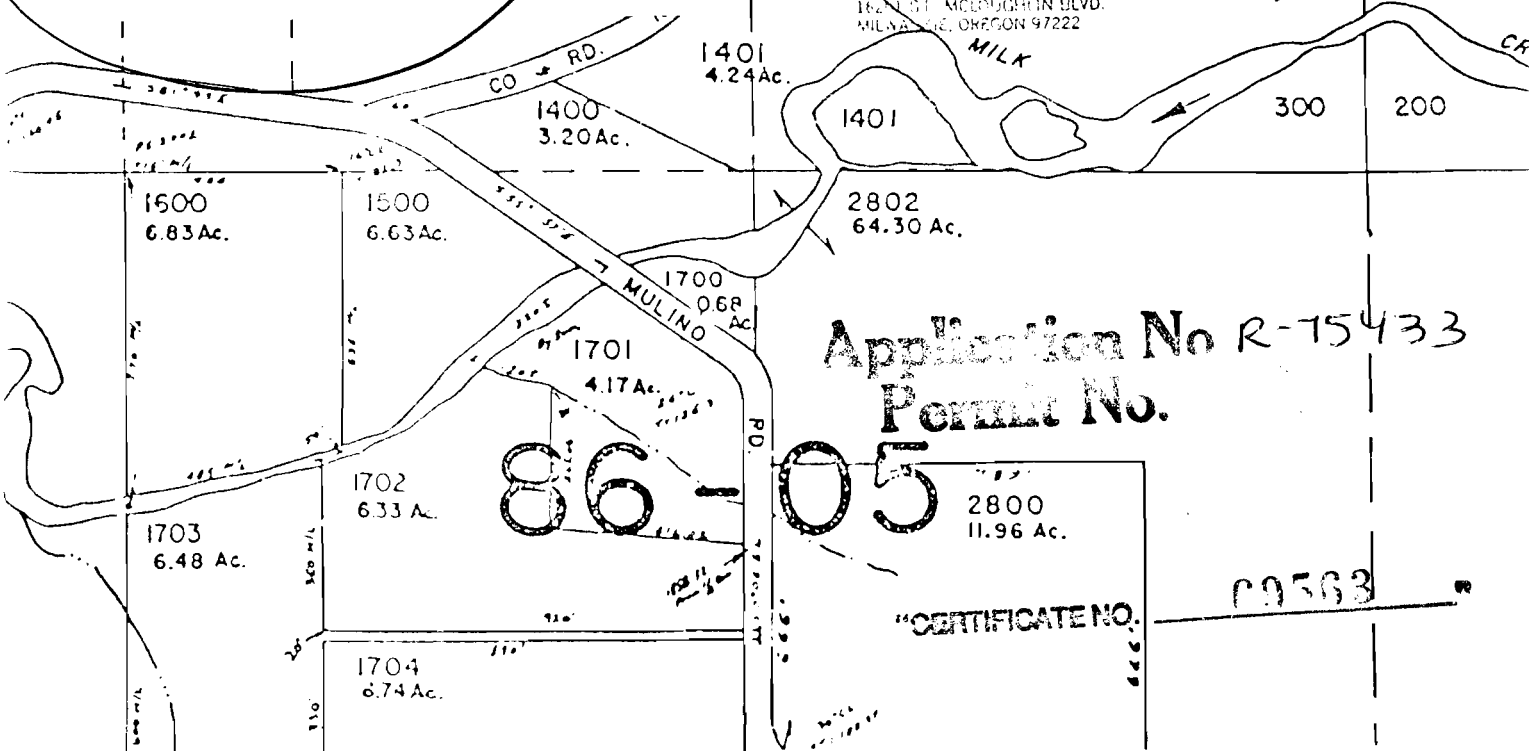

Permit No.

86-05

2800
11.96 Ac.

"CERTIFICATE NO."

