

14967

MS 4514

THIS MAP IS FURNISHED TO ASSIST IN
LOCATING PREMISES, IT IS NOT A
SURVEY, AND NO LIABILITY IS ASSUMED
FOR ANY ERRORS THEREON.
THE ABSTRACT & TITLE CO.

1037.26


(1302.5)

Application No. R-75437

Permit No.

T.1S. R.38E. W.M.

"CERTIFICATE NO. 69566"

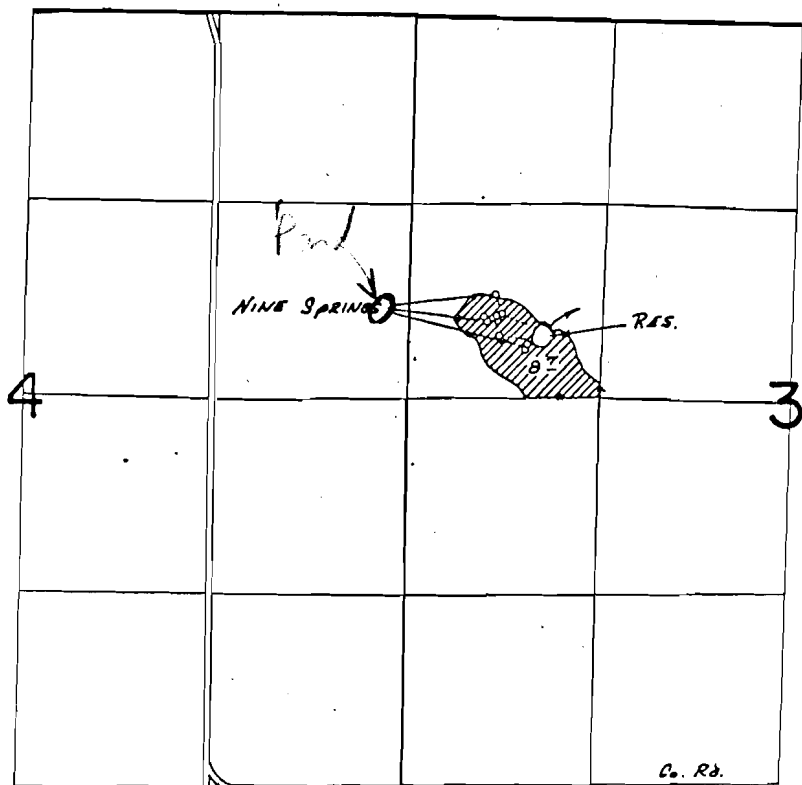

SPRINGS LOC. : 700' N + 610' E ; 560' N + 650' E ; 550' N + 620' E ;
550' N + 540' E ; 520' N + 630' E ; 520' N + 550' E ;
420' N + 640' E ; 360' N + 830' E ; 330' N + 800' E
RES. LOC. : 450' N + 1000' E ALL FROM W/4 COR SEC 9

FINAL PROOF SURVEY UNDER

Application No. ~~R-75437~~ Permit No. ~~R-75437~~
IN NAME OF

FLOYD A. FEIK

Surveyed July 11 1958, by R. G. Mucken