


Application No R-75444
Permit No.

RE: COUNTY: CLACKAMAS

LOCATION: TOWNSHIP 5S RANGE 3E SECTION 2 TAX LOT 900

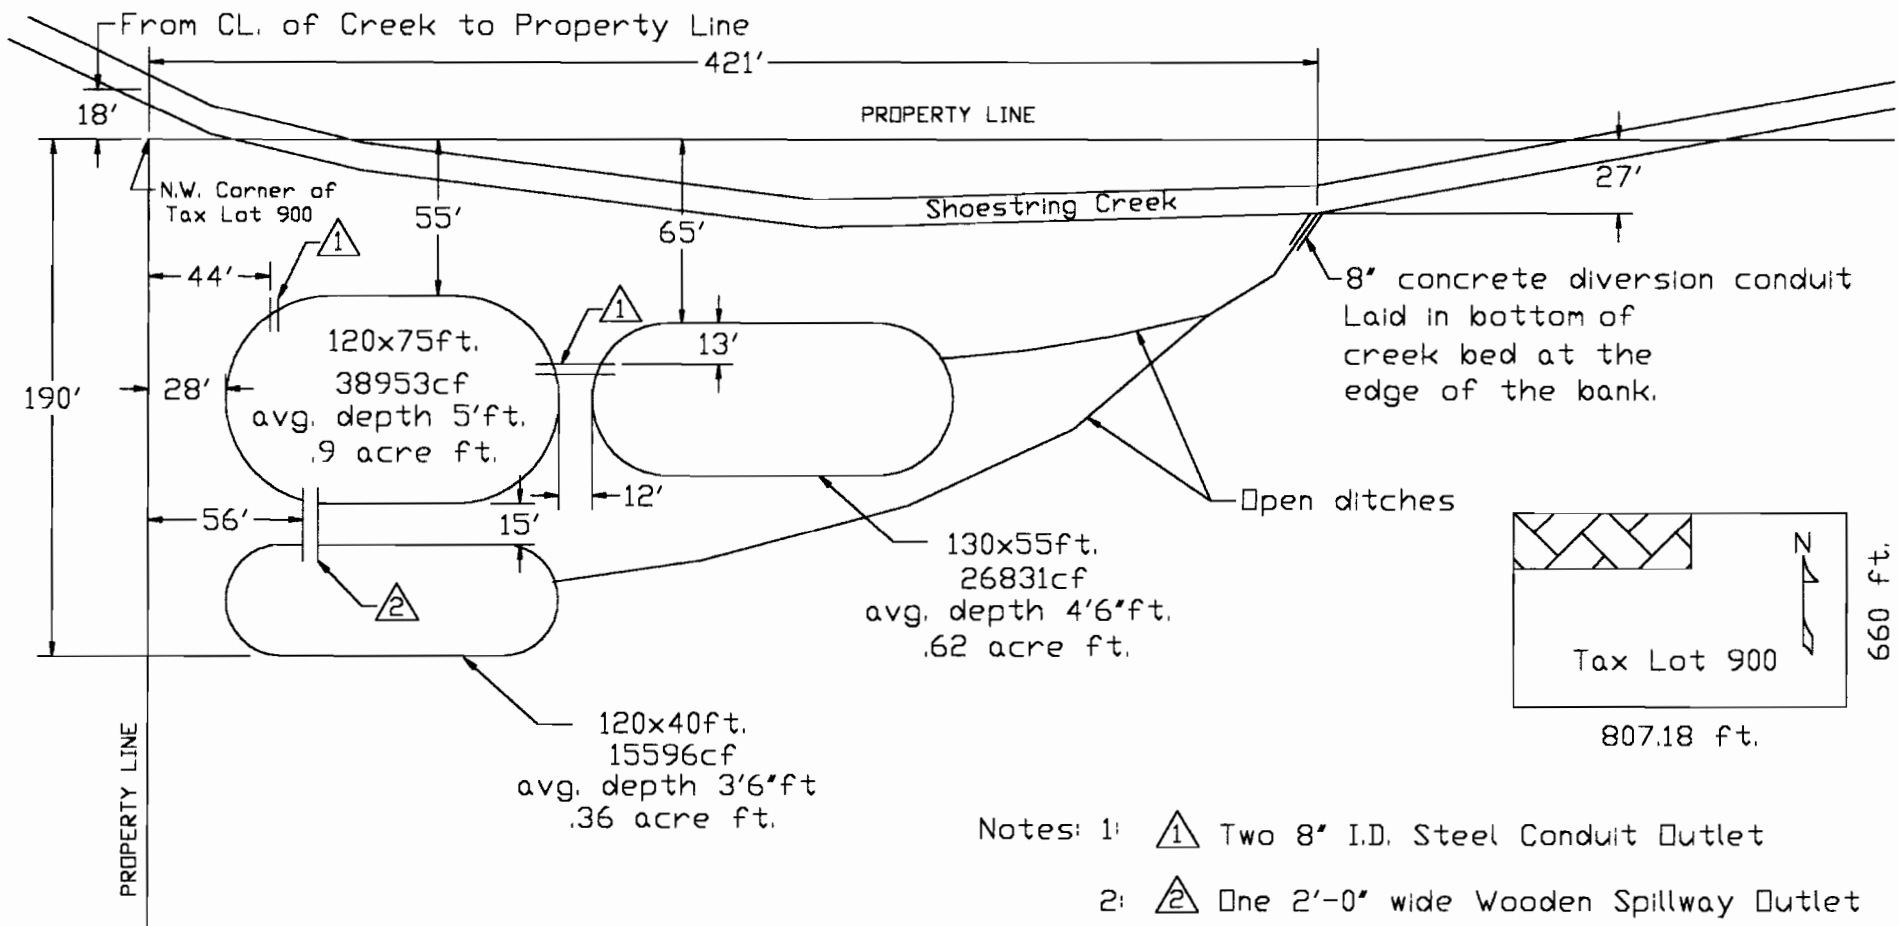

- Notes: 1: Two 8" I.D. Steel Conduit Outlet
2: One 2'-0" wide Wooden Spillway Outlet
3: Water Requirements .0267 cfs