


DAM WISH IS ALSO  
ROAD TO FIELD IN  
SOUTH END OF PLACE

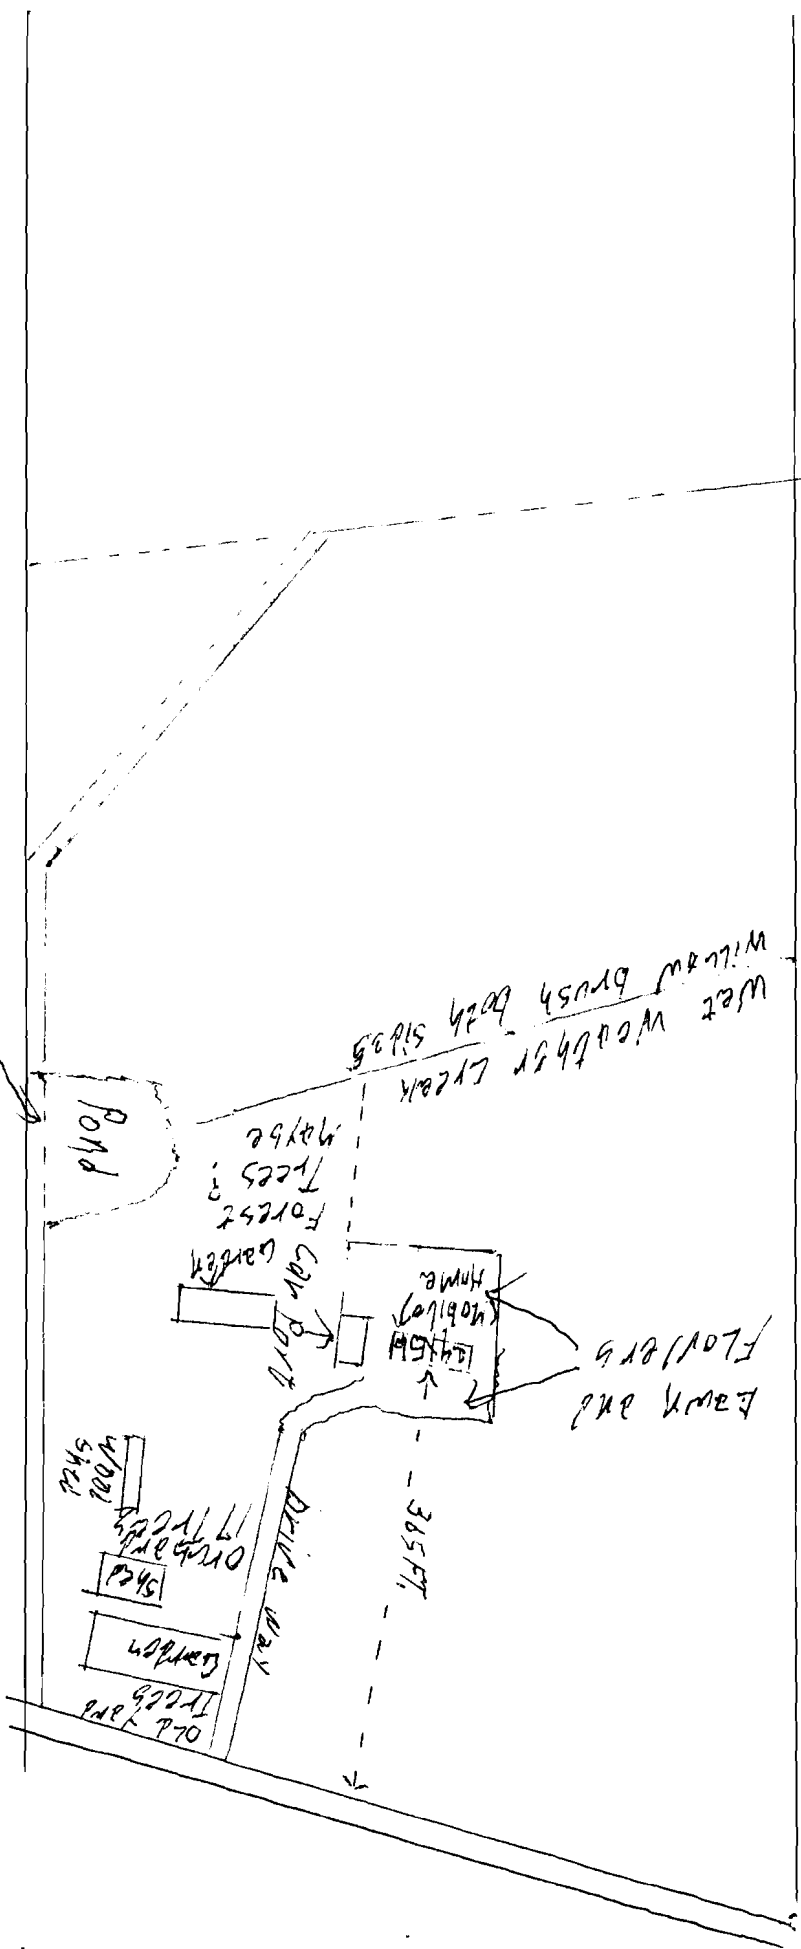

WATER RESOURCES DEPT. SALEM, OREGON

JAN 25 1996

RECEIVED