
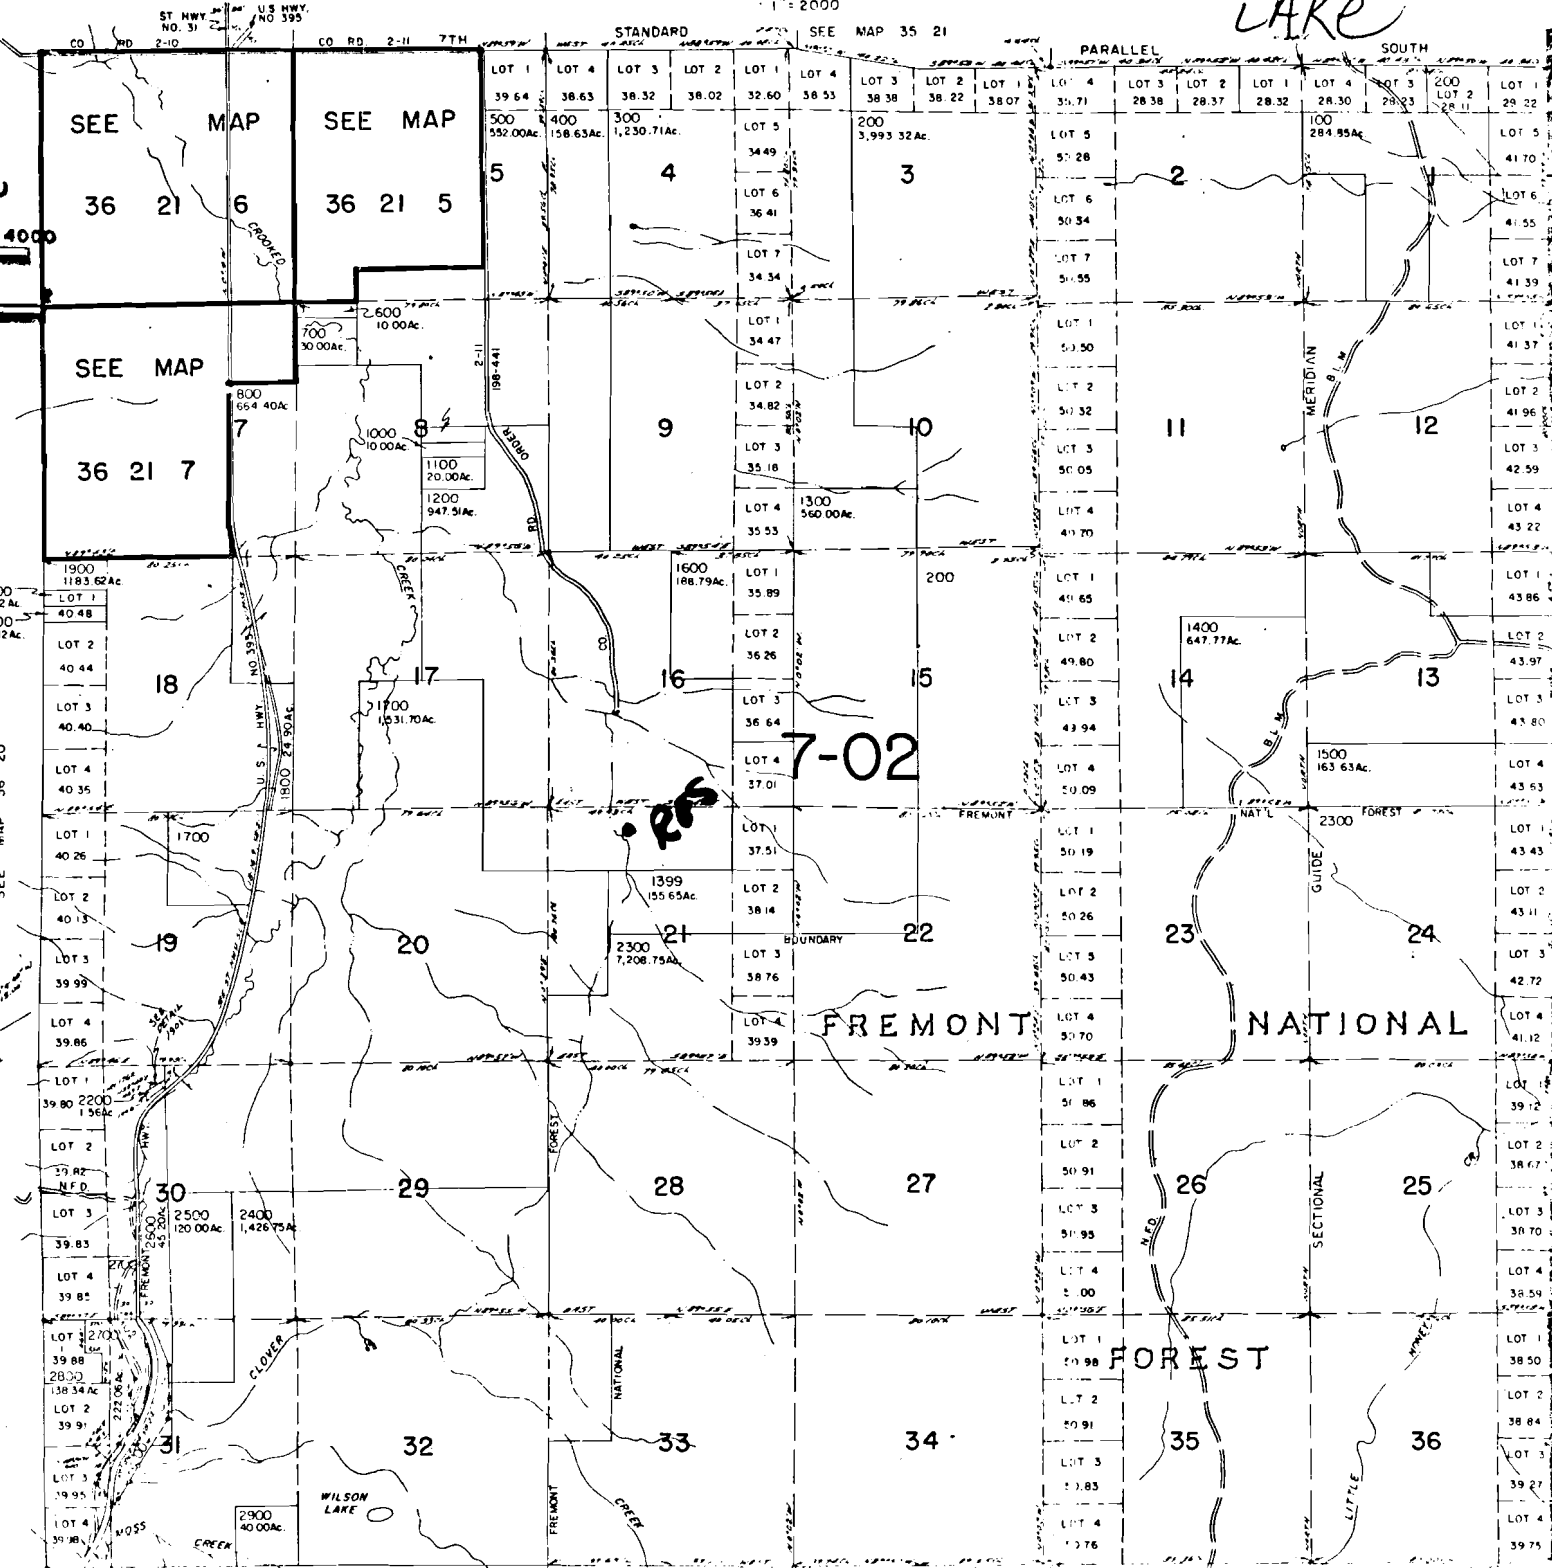


RECEIVED

DEC 14 1994

WATER RESOURCES DEPT.
SALEM, OREGON

SEE MAP 36 20

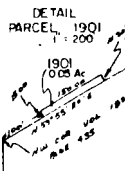

LAKE

36 21

Application No. R-754541
Parcel No.

SEE MAP 36 22

CERTIFICATE NO. 00598

36 21
INDEX

photo taken 7/1990 - Lake Co. ASCS. lh Application No. Z-42
Permit No. 75454

RECEIVED

DEC 14 1994


WATER RESOURCES DEPT.
SALEM, OREGON

CERTIFICATE NO. 69578

CRP#106 NHEL
90-99

CRP#106
90-99

NHEL

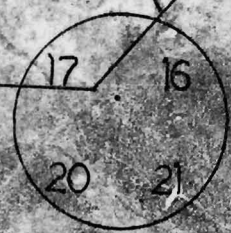

19
23

18
46

17
36

20
15

