


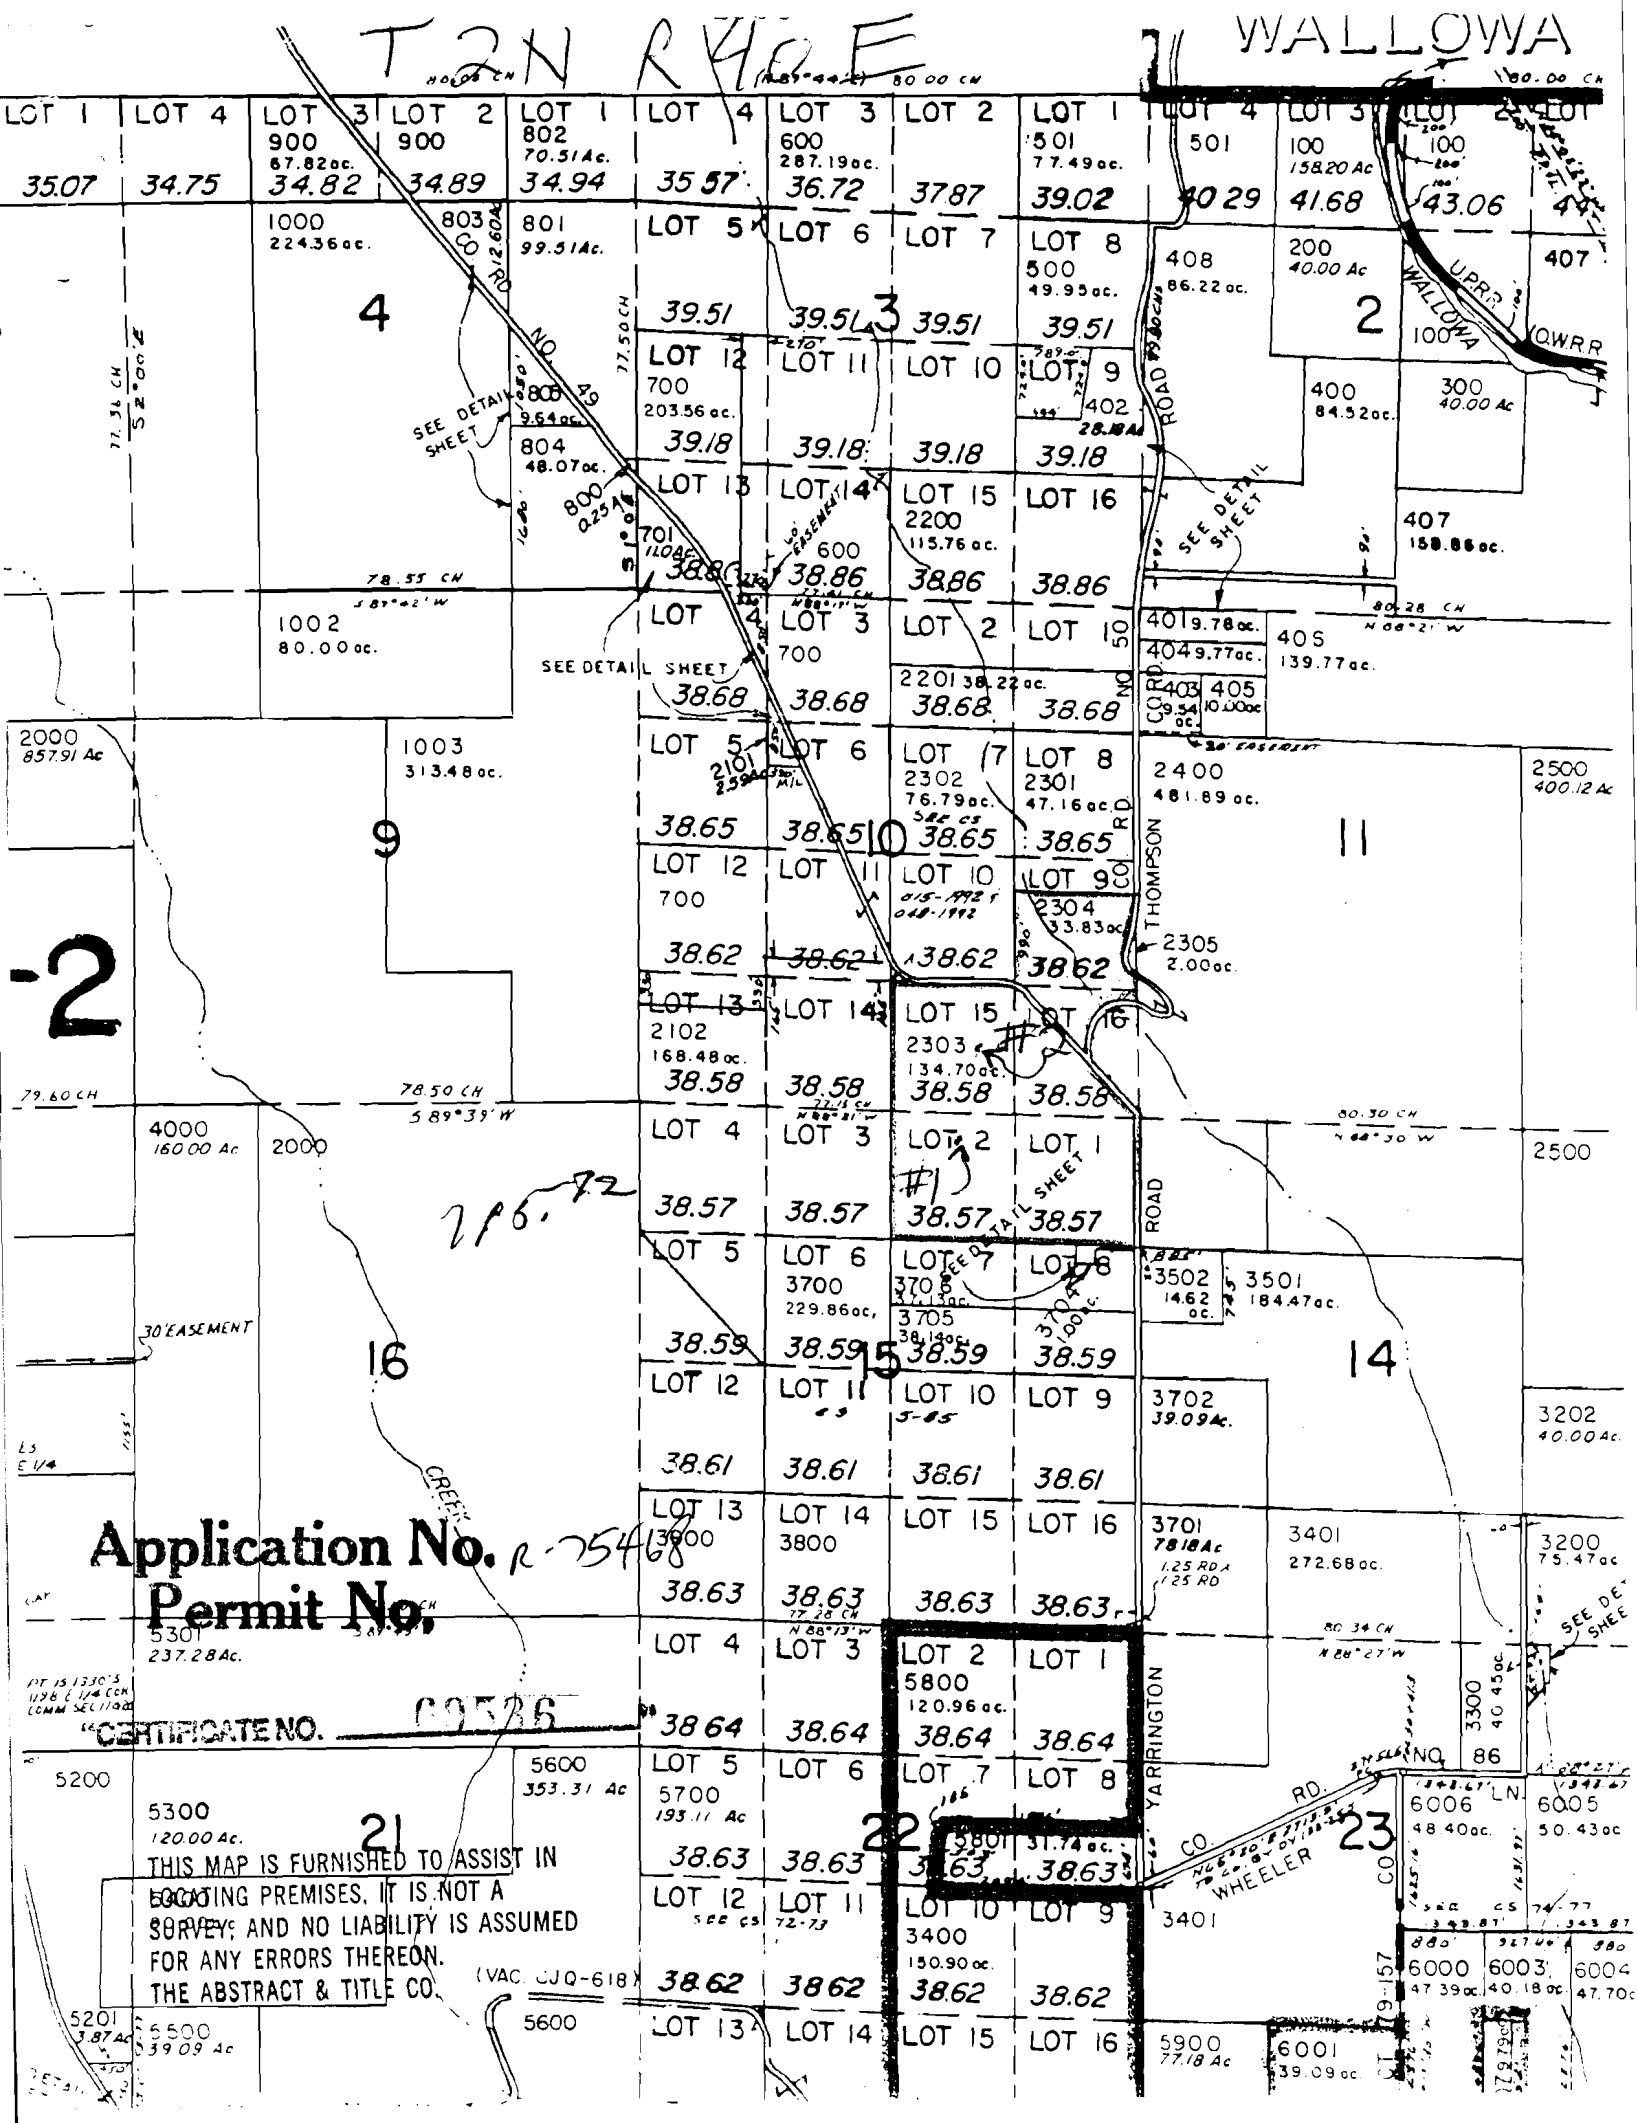

T2N R40E

WALLOWA

Application No. R-75468
Permit No.

CERTIFICATE NO. 69526

THIS MAP IS FURNISHED TO ASSIST IN
LOCATING PREMISES. IT IS NOT A
SURVEY, AND NO LIABILITY IS ASSUMED
FOR ANY ERRORS THEREON.
THE ABSTRACT & TITLE CO.

(VAC. CJO-618)