

width of Dam 102' .
 water Depth at Dam 8'
 width at 200' max 40'
 " " 100' " 20' Depth 4'
 " " 200' " 20' Depth 2'
 " " 200' " 20' Depth 2'


43560 50 FT = 1 Acre

Section 2901 Grease
 Township R5411
 Code 40.2

Section 00300 Peban
 Township R5414
 Code 40.2

2.31 Acre-ft water

Section 3000 Grease
 Township R5411
 Code 40.2

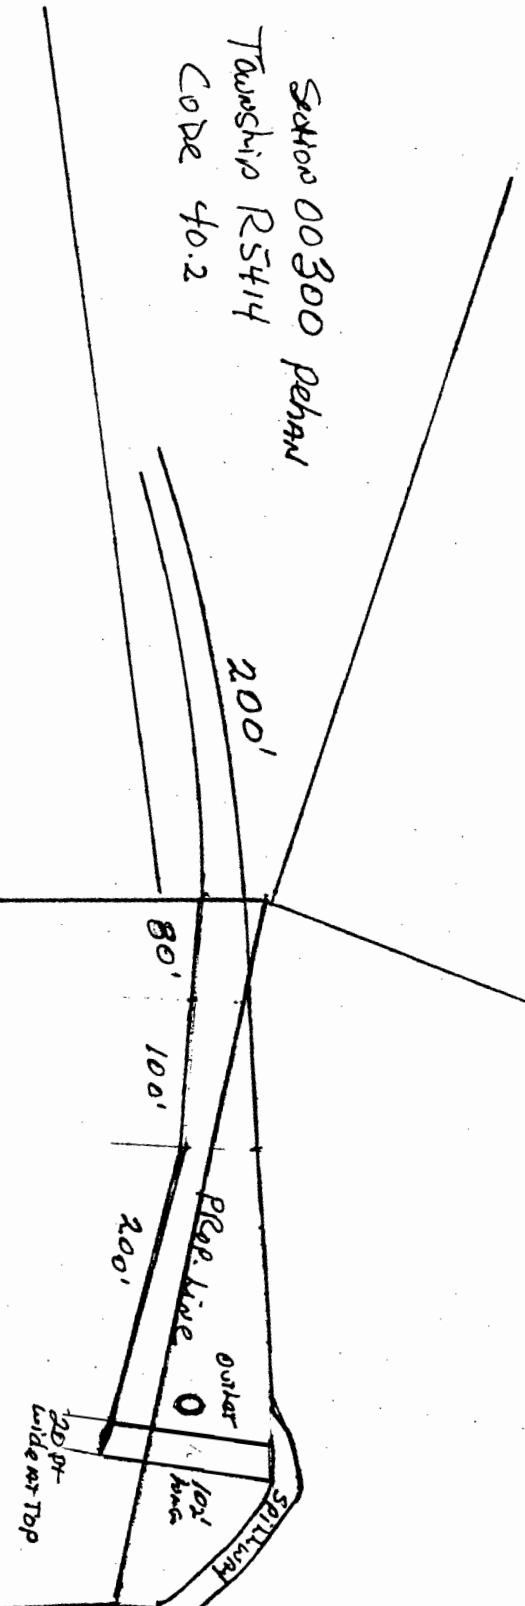

S.E. WOODLAND HTS. RD.

Permit No. 127547
 Section No. 2901
 Township R5411
 Code 40.2

8.4

40.2

40.2

Application No. R-75472
Permit No.
25 "CERTIFICATE NO. 60590"

69590