



THIS MAP IS FURNISHED AS A CONVENIENCE IN LOCATING PROPERTY AND THE COMPANY ASSUMES NO LIABILITY FOR ANY VARIATIONS AS MAY BE DISCLOSED BY ACTUAL SURVEY

First American Title Insurance Company of Oregon

an assumed business name of TITLE INSURANCE COMPANY OF OREGON
1700 S.W. FOURTH AVE., PORTLAND, OR 97201-5512
(503) 222-3651

WATER RESOURCES DEPT.
SALEM, OREGON


RECEIVED

4 2E 22

JAN 22 1996

SEE

WATER RESOURCES DEPT.
SALEM, OREGON

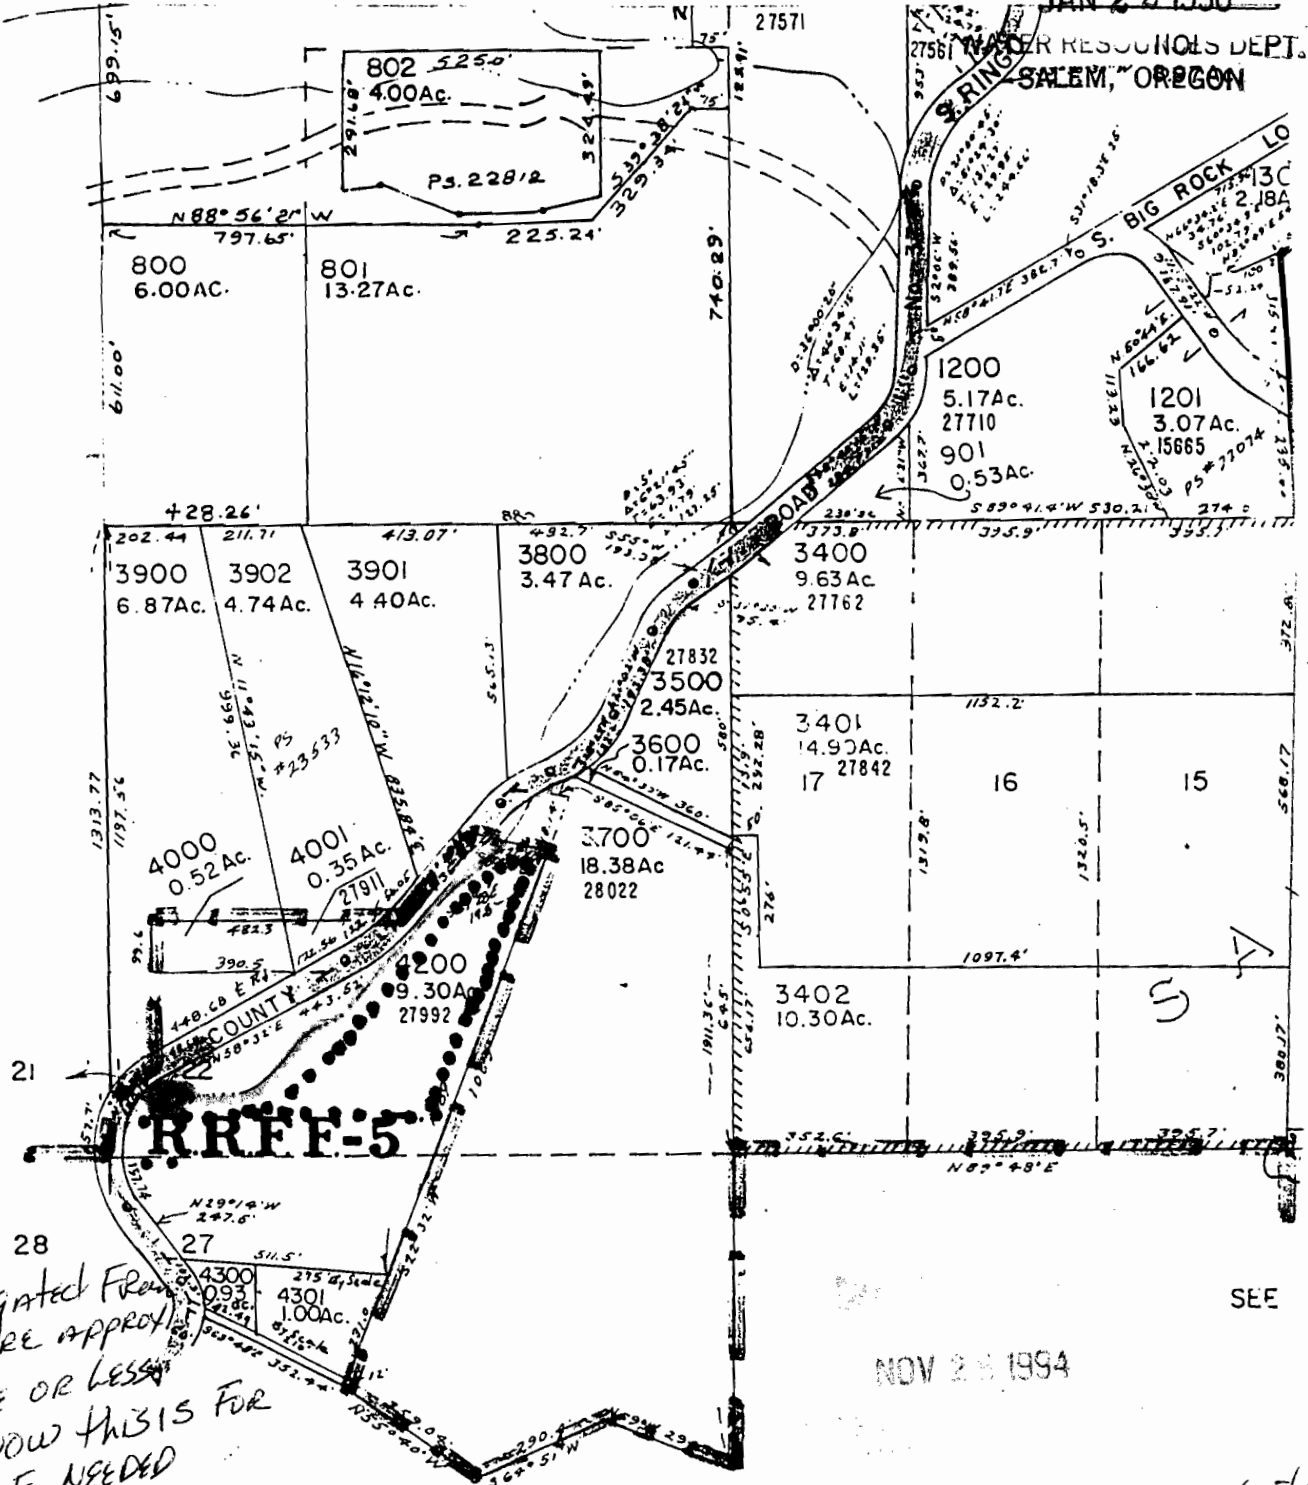

ACRES IRRIGATED FROM SAID POND ARE APPROX 8 ACRES MORE OR LESS NOT IN USE NOW THIS IS FOR FUTURE USE IF NEEDED THANKS STEVE
 P.S. THERE IS NO PUMP OR IRRIGATION NOW

Property lines
 water & Pond

NOV 28 1994

SEE

Application No. **2-75474**
 Permit No. _____
 "CERTIFICATE NO. **69593**"