

SECTION 19 T25S.R.4 W. W.M.
DOUGLAS COUNTY

25 4 19

THIS MAP WAS PREPARED FOR
ASSESSMENT PURPOSE ONLY.

1"=400'

Application C-75479
"CERTIFICATE NO. 69597"

SEE MAP 25 4 18

130-05

CANCELLED NO'S
301
302
200


130-00

SEE MAP 25 4 20

635,000

DEC 15 1904

25 4 19

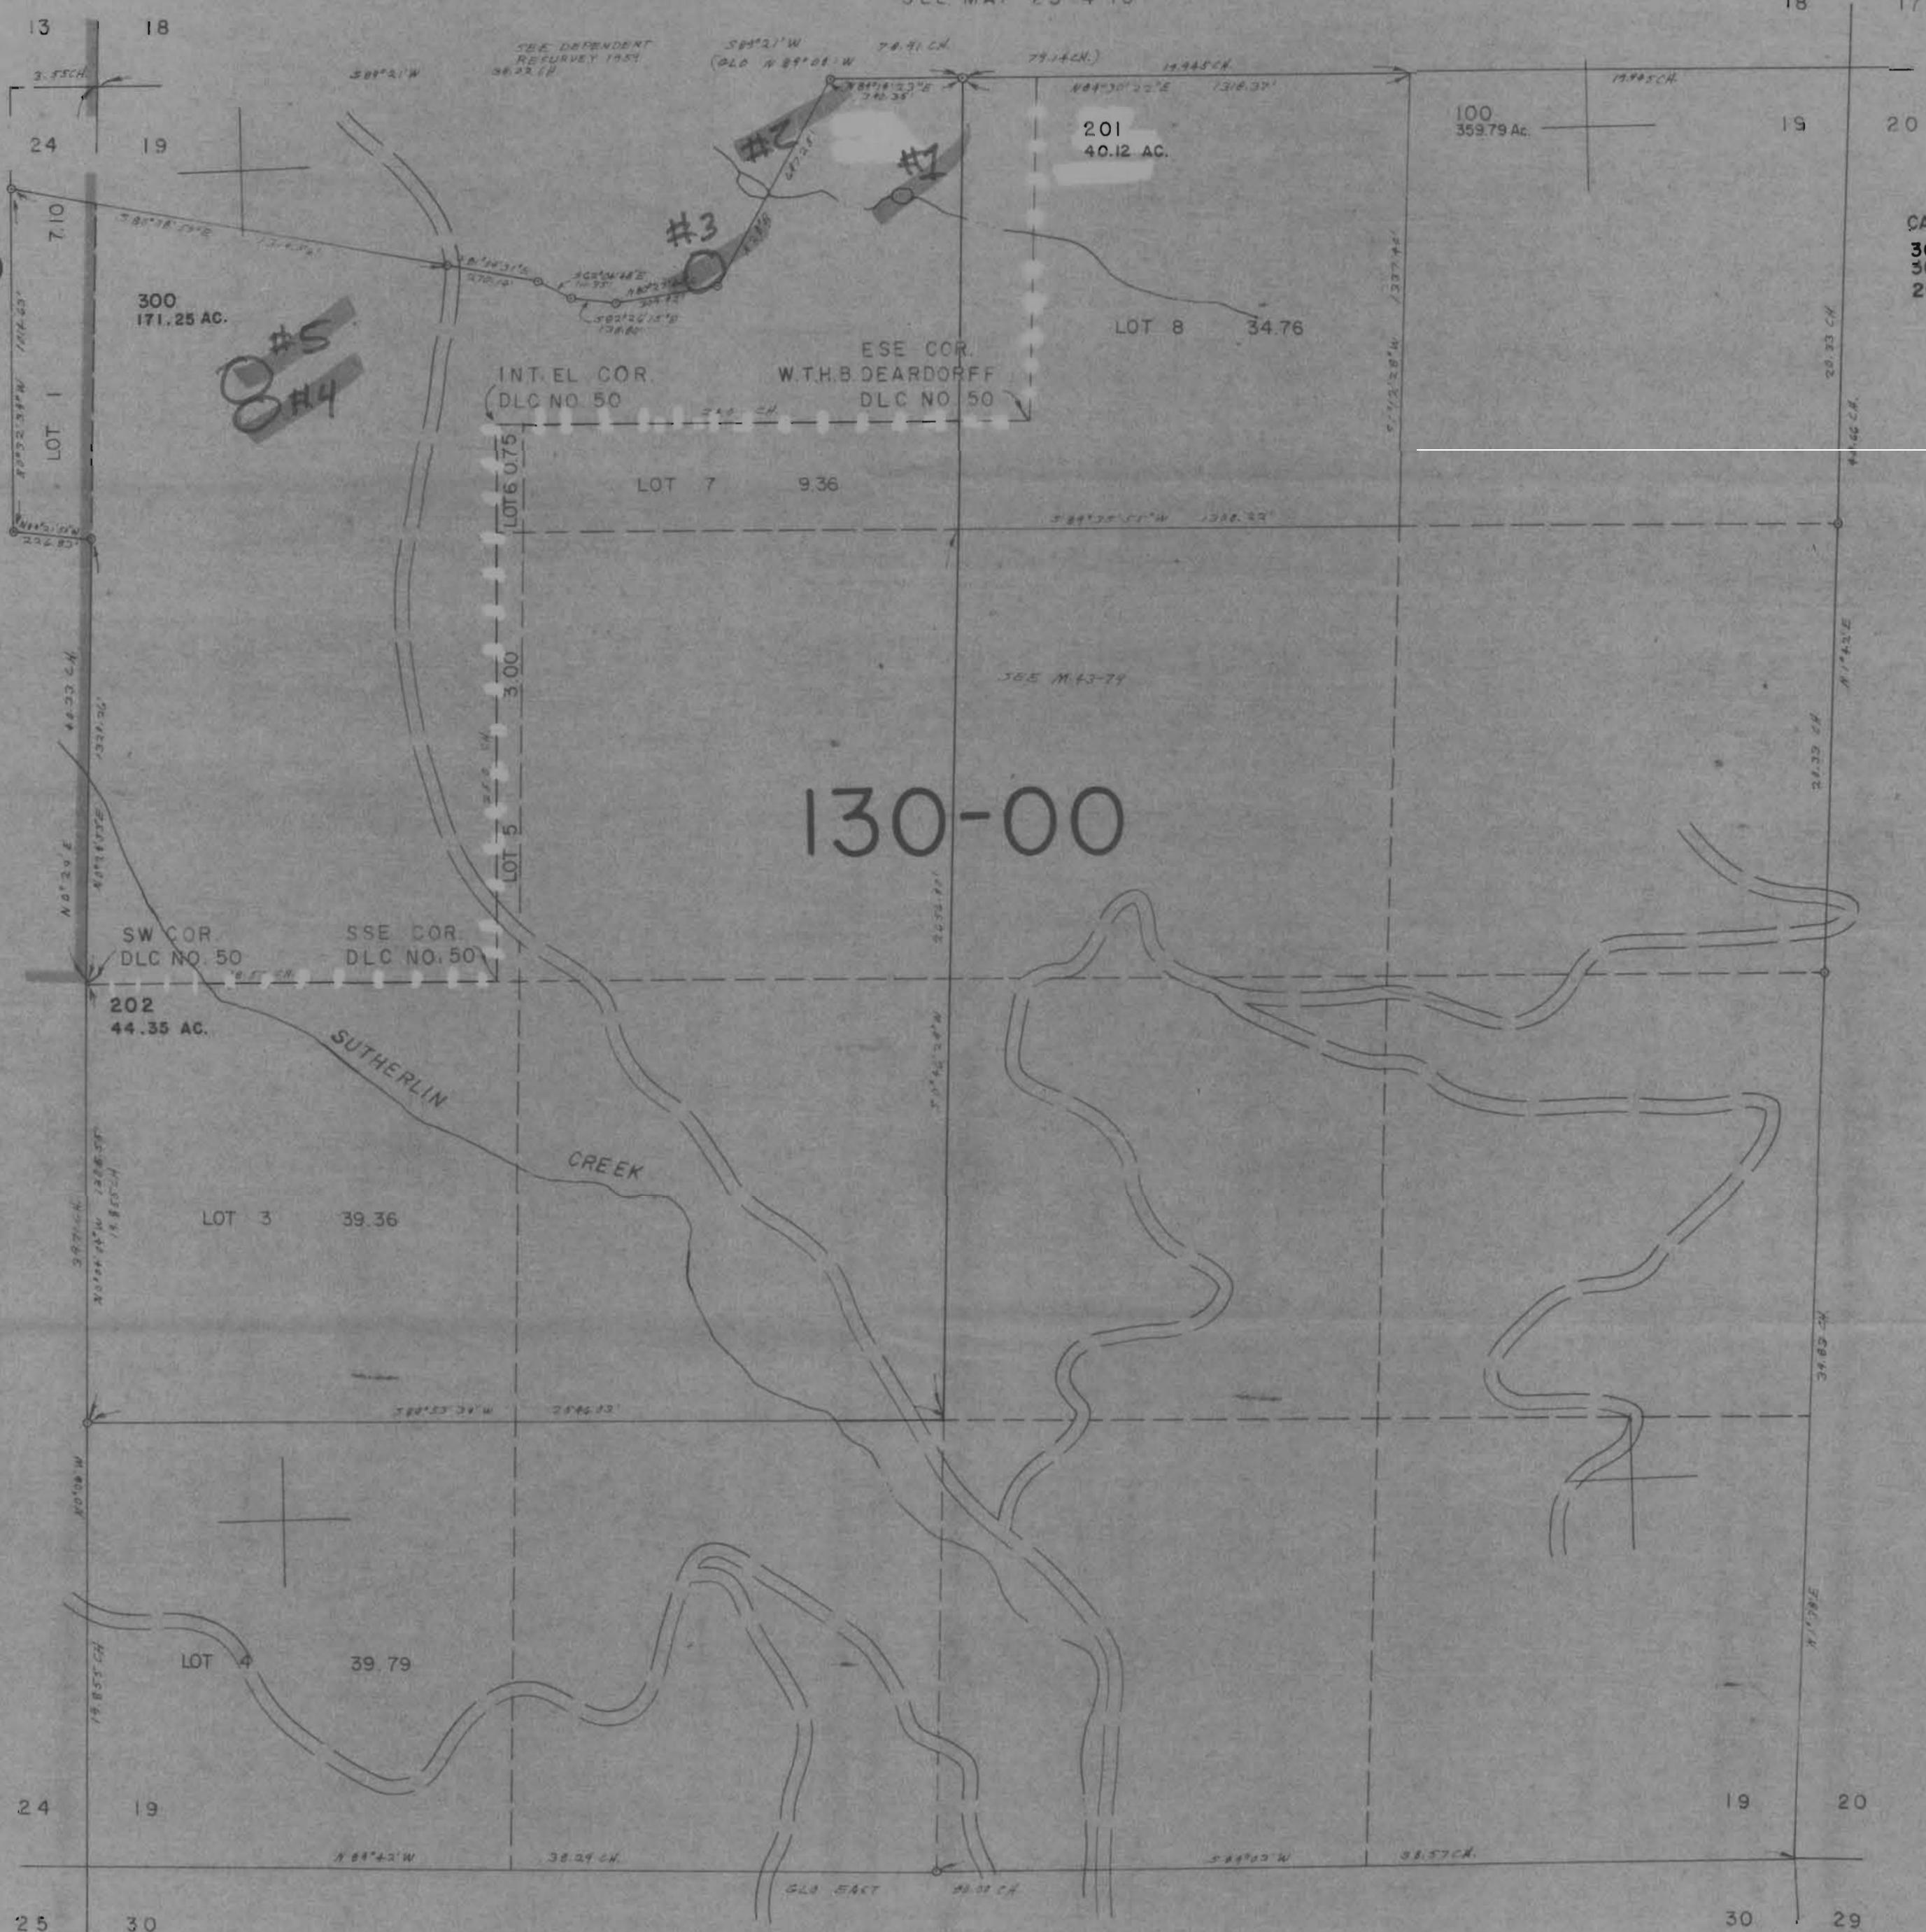

SEE MAP 25 4 30

1,280,000

