


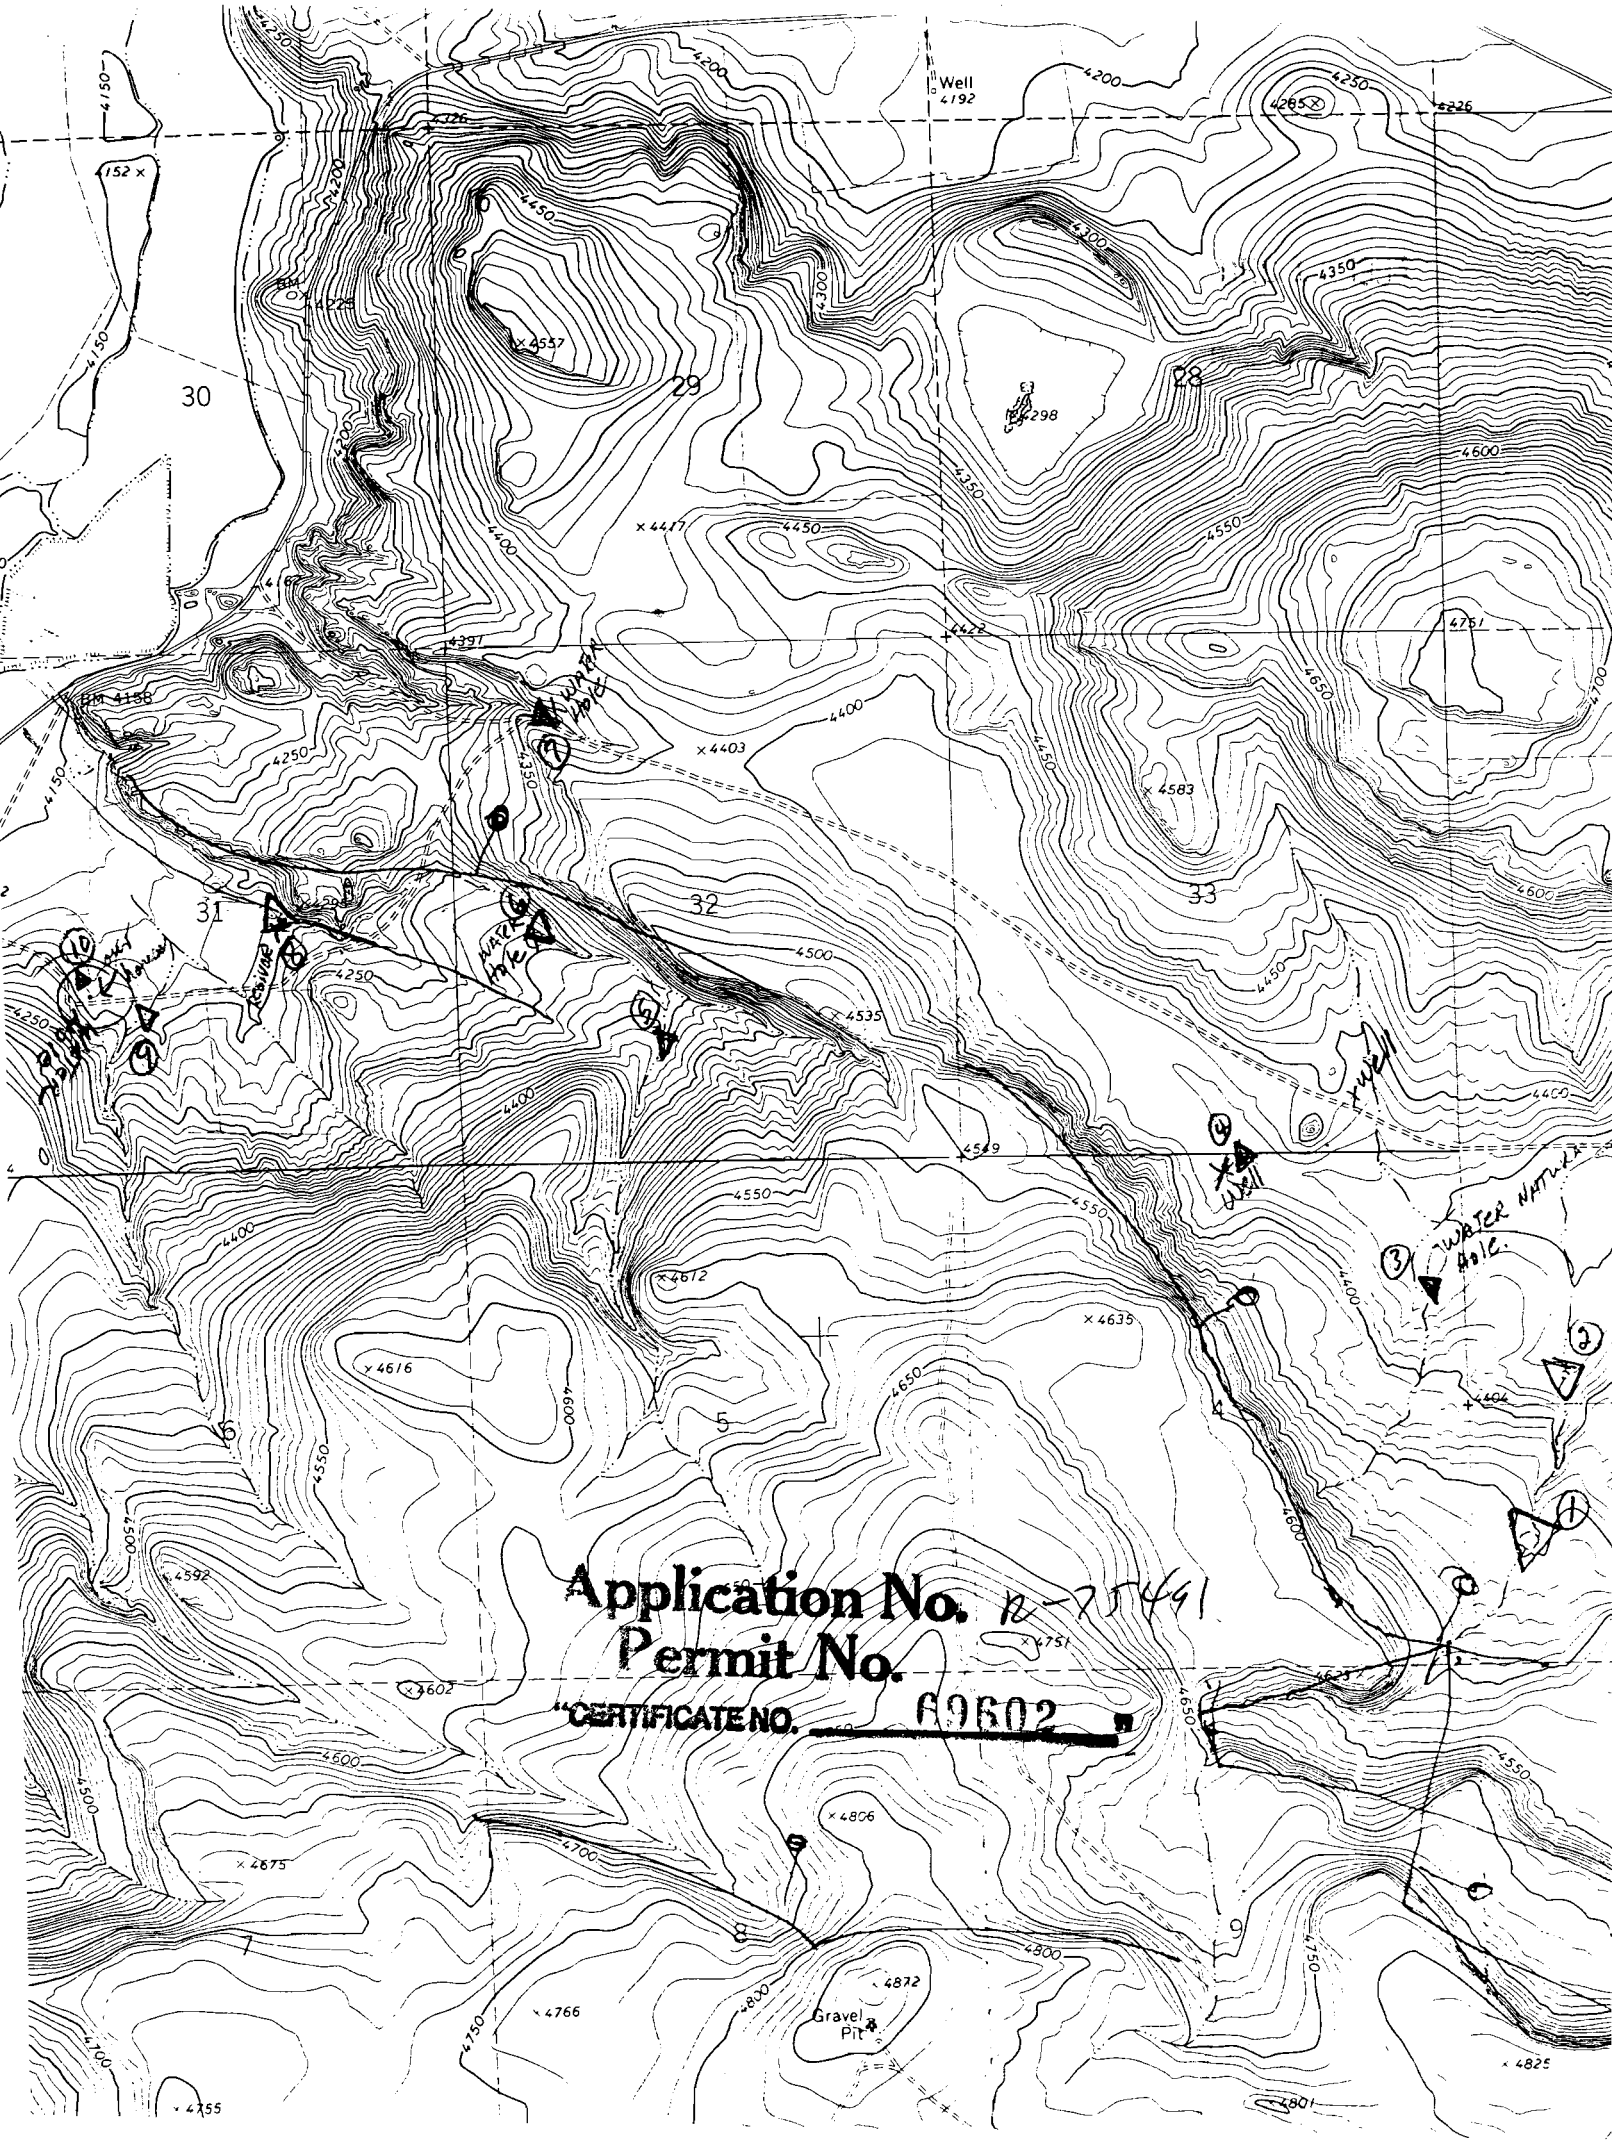

Application No. 12-75491
Permit No.

"CERTIFICATE NO. 69602"