



CERTIFICATE NO. **F9604**

Application No. **175493**
Permit No.

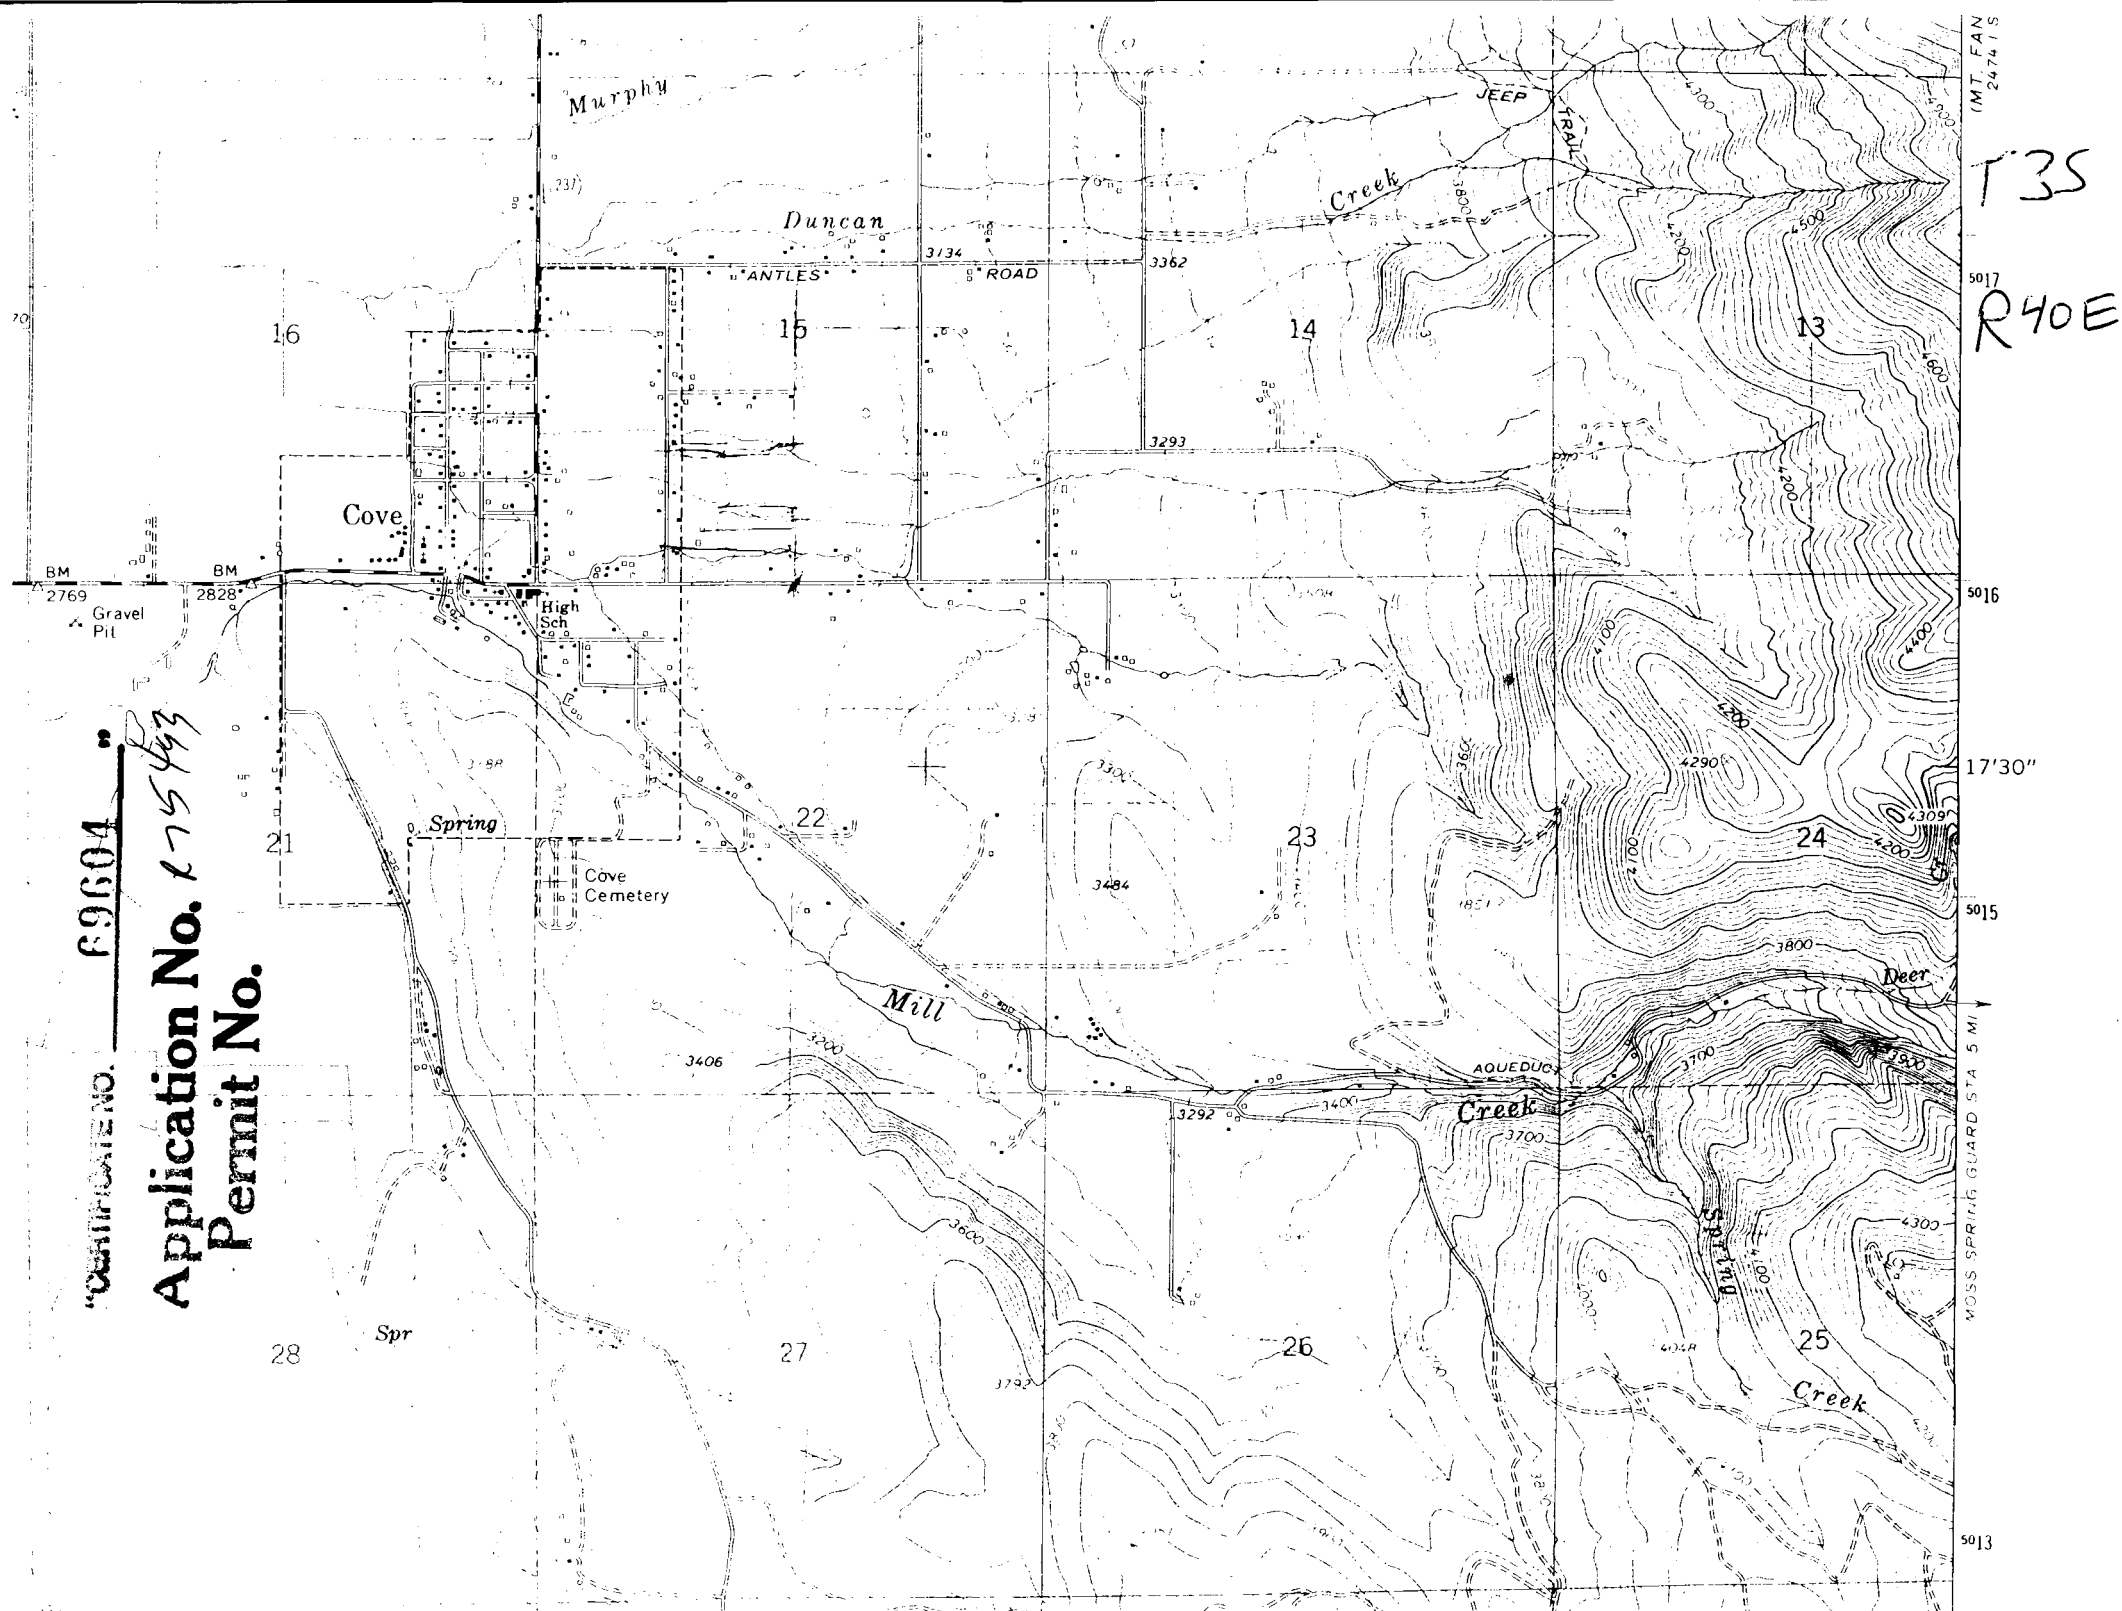

T35
R40E

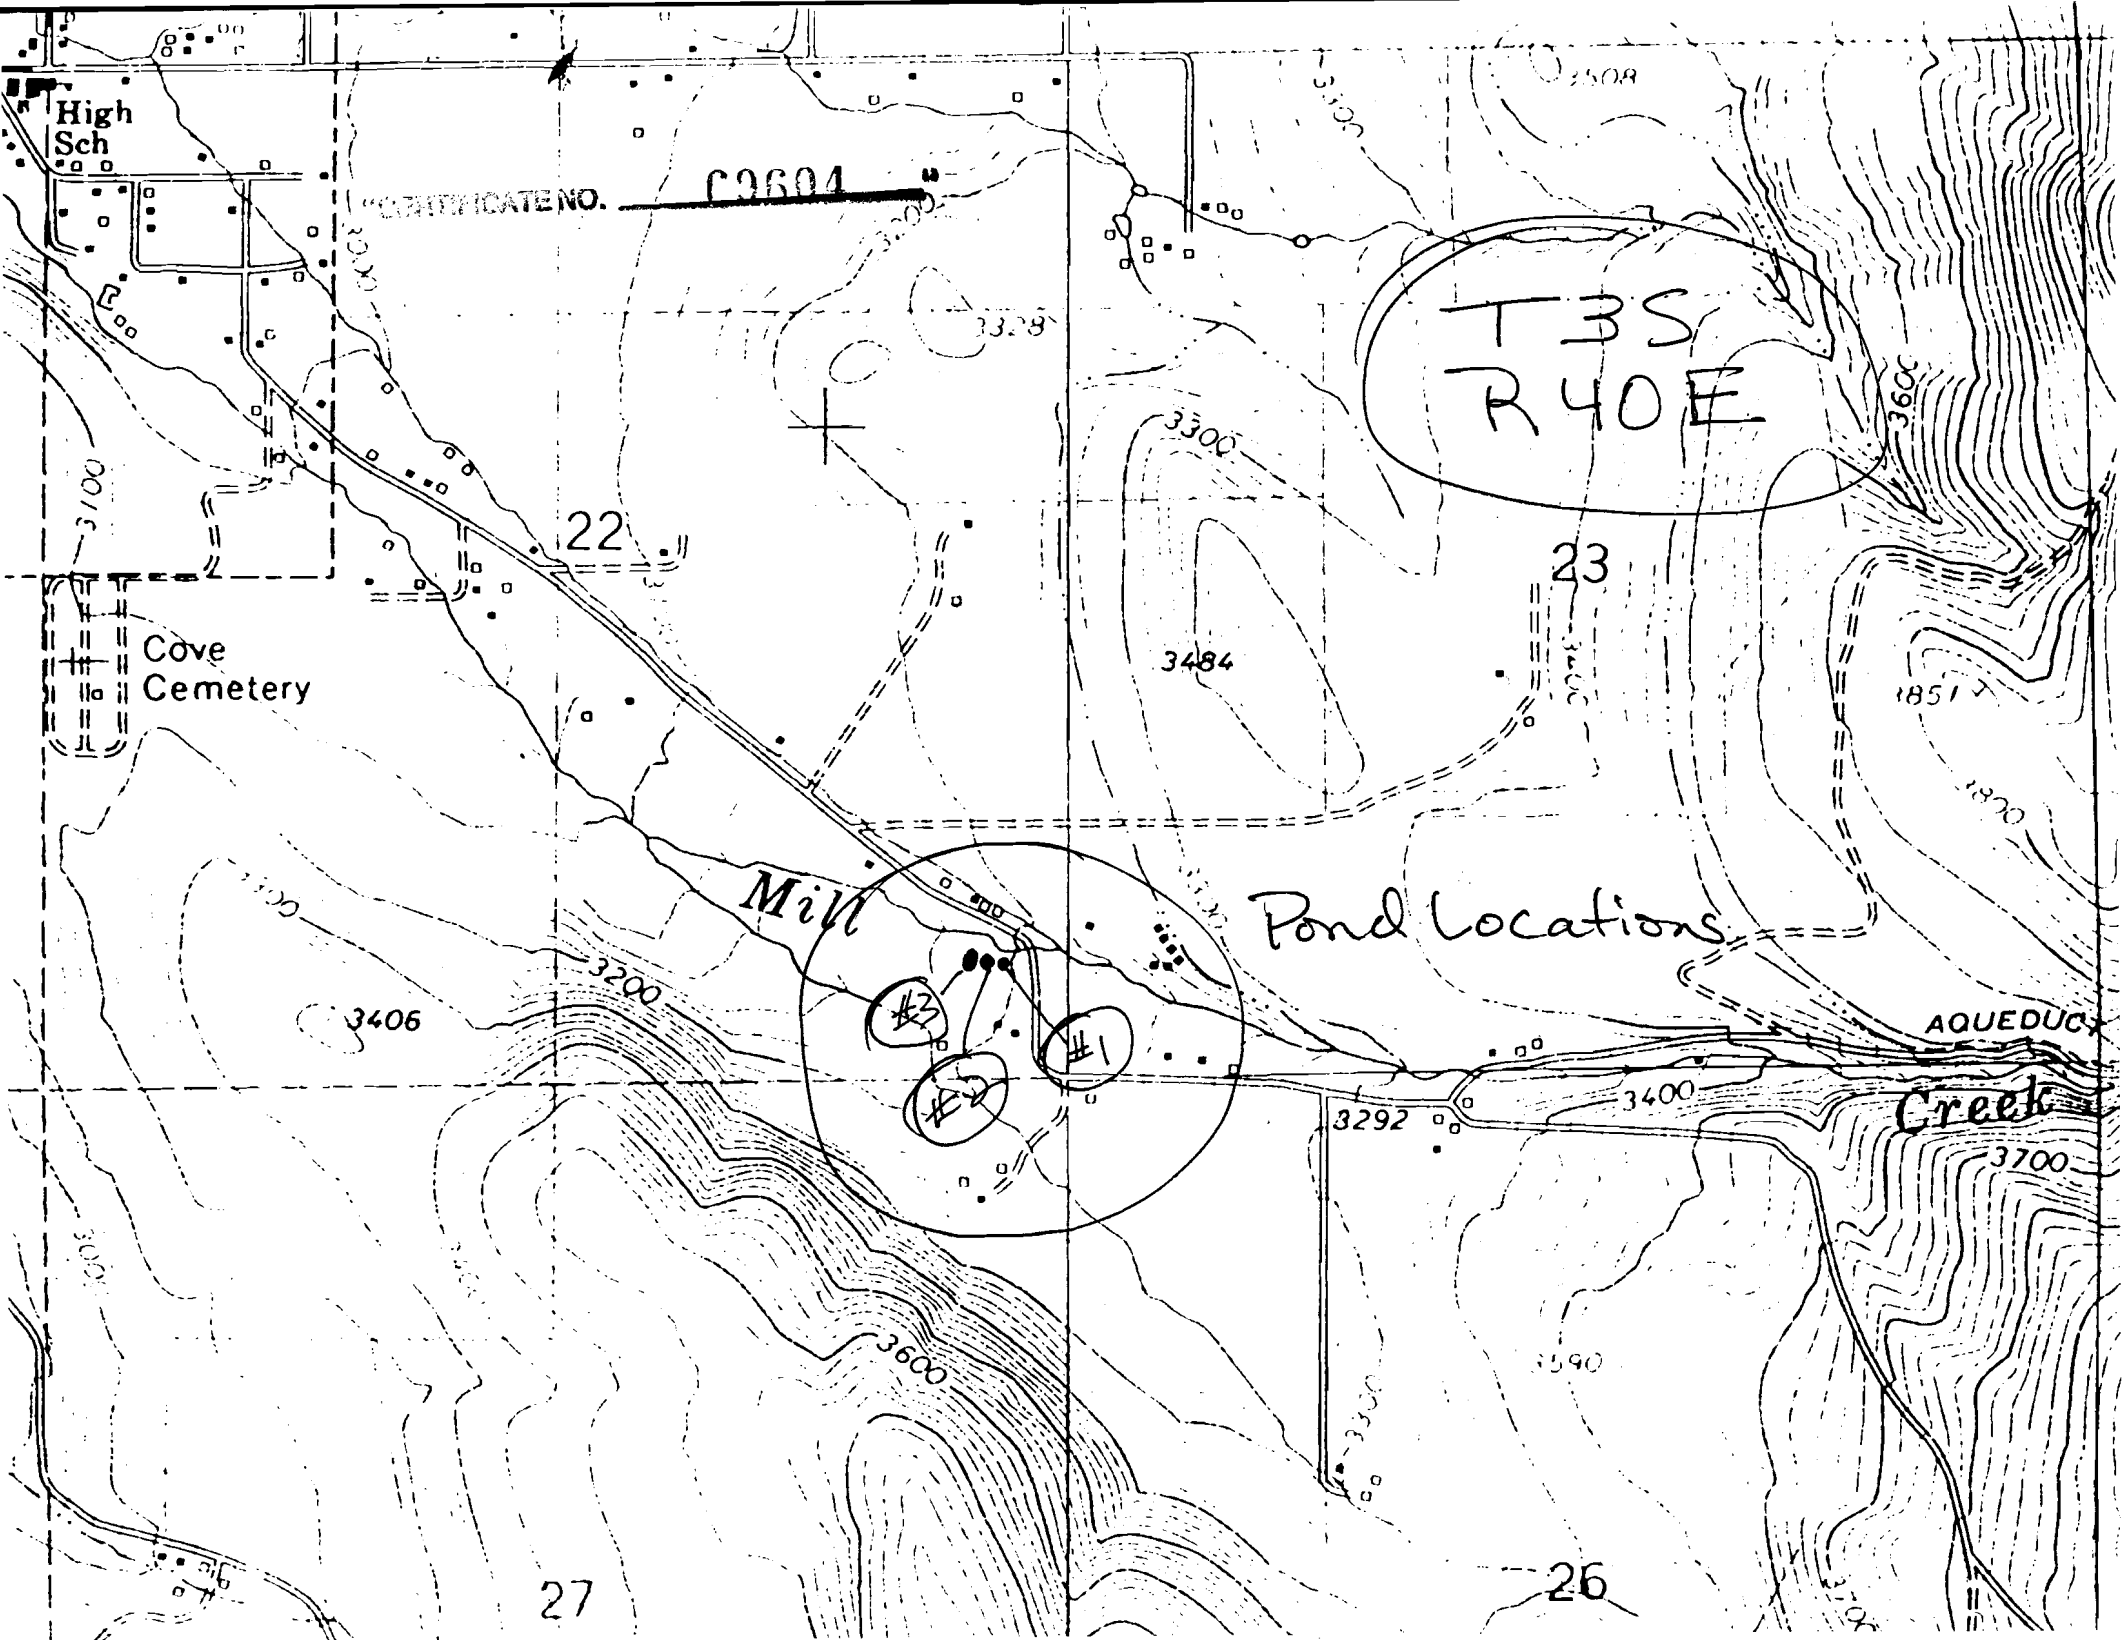

High Sch

CERTIFICATE NO.

C9604

T3S
R40E

22

23

Cove Cemetery

3484

1851

Mill

Pond Locations

3406

AQUEDUC

Creek

3292

3400

3700

#3

#2

#1

27

26