USGS Beaverton, OR QUAD
1961
Photorevised 1984

(12)

UNITED STATES
DEPARTMENT OF THE INTERIOR
GEOLOGICAL SURVEY

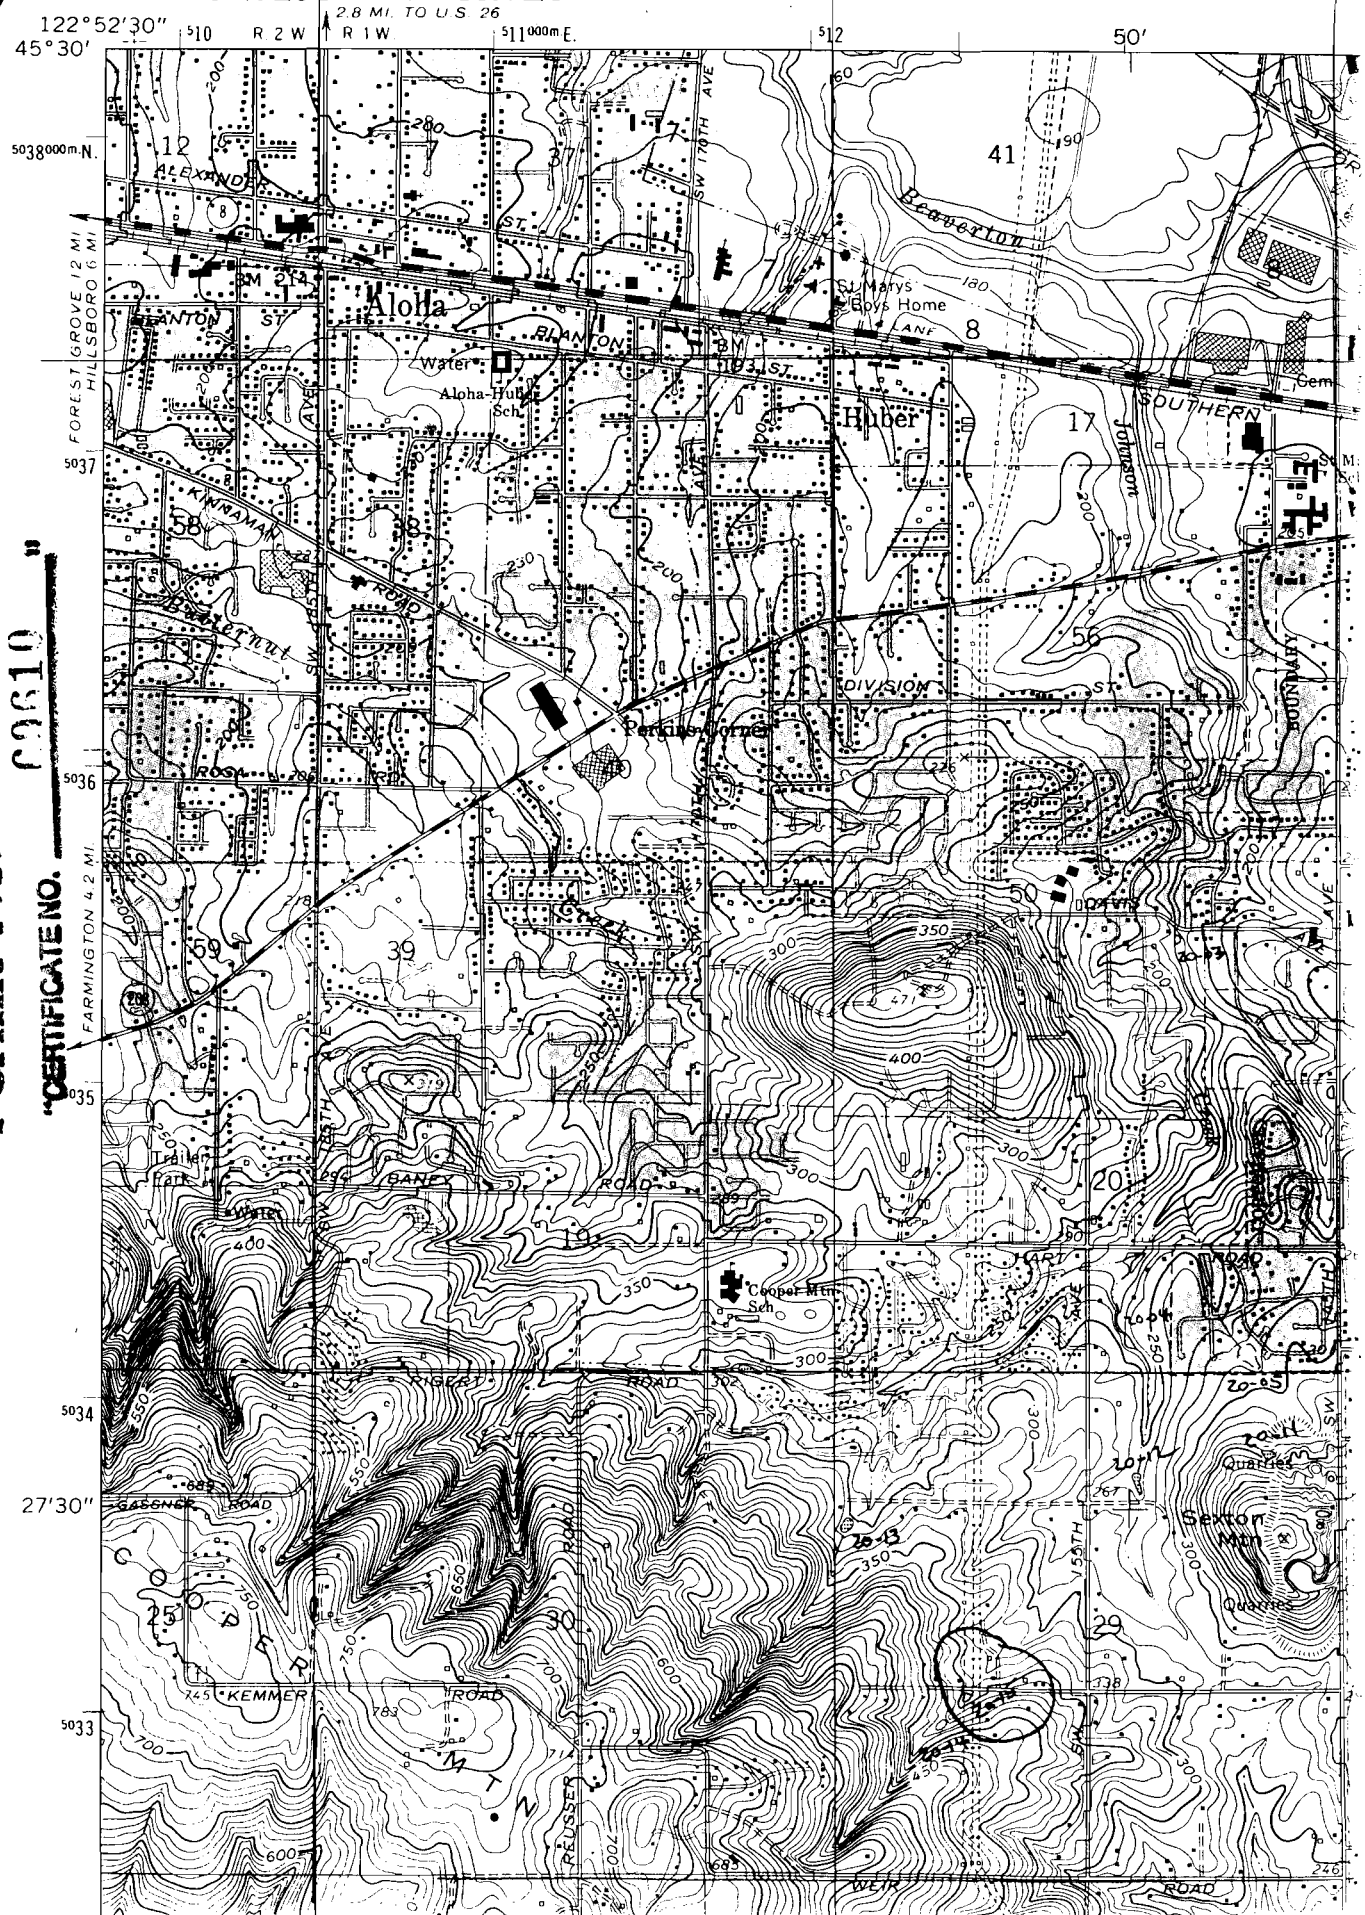


Application No. R-75499
Permit No. 69610
"CERTIFICATE NO. "