


TOWNSHIP 5 SOUTH, RANGE 3 WEST, W.M.

RECEIVED

DEC 19 1994

WATER RESOURCES DEPT.
SALEM, OREGON

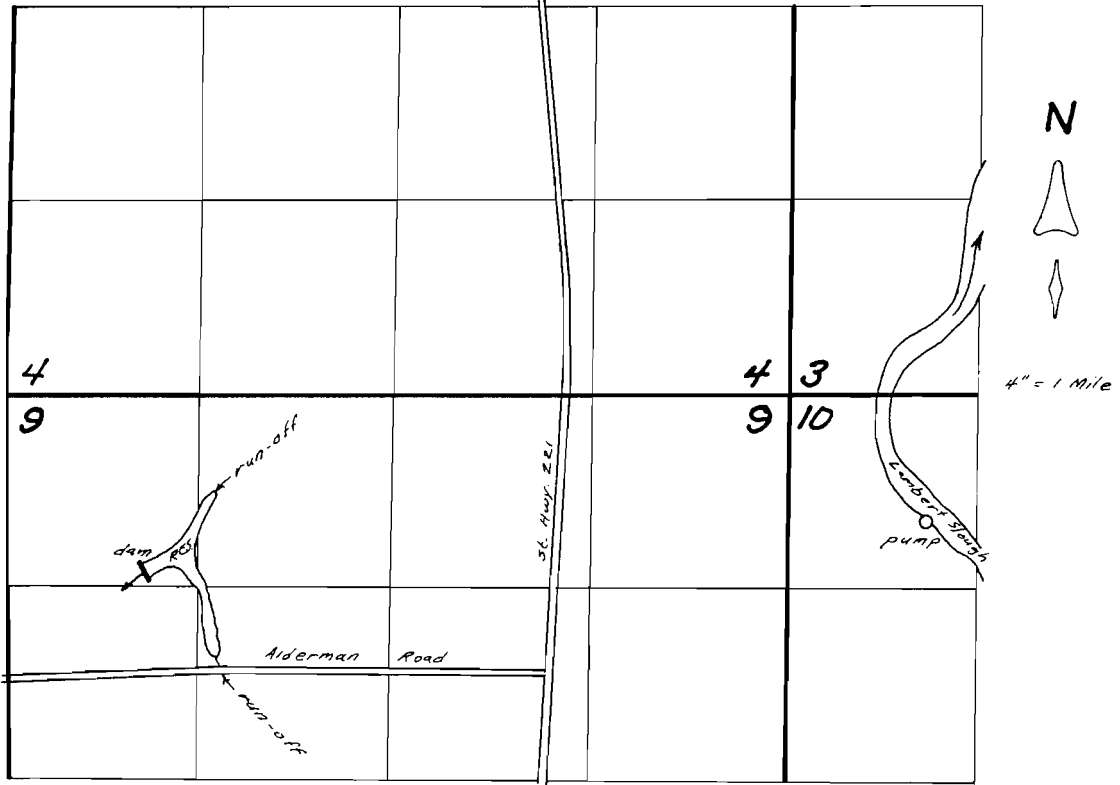

APPL. No. 1275504
PER. No. _____


HB 2153
APPLICATION MAP
FOR
CARLTON PLANTS

RECEIVED

DEC 19 1994

T.5S.R.3W.W.M.

WATER RESOURCES DIV
SALEM, OREGON

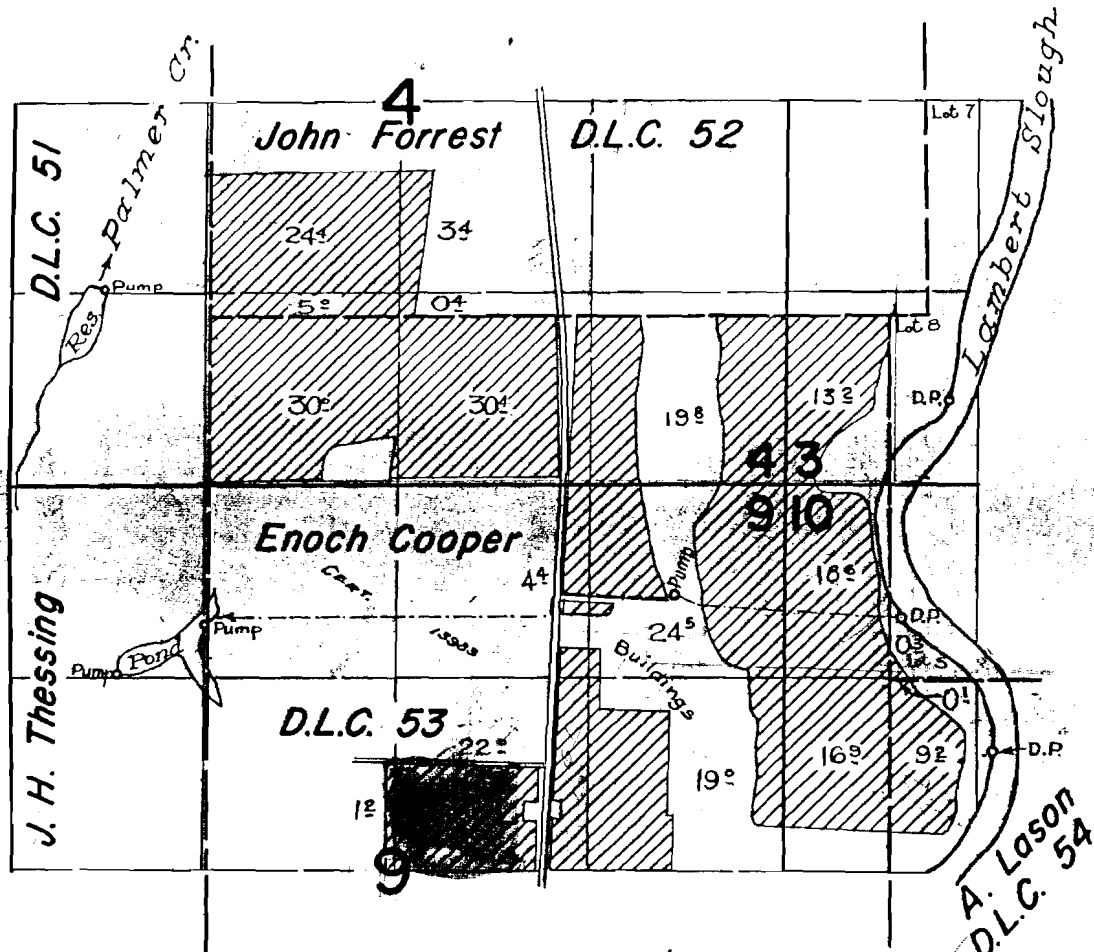

Case No. R-7550

Plot No.

FINAL PROOF SURVEY
UNDER

Application No. **37183** Permit No. **27687**
IN NAME OF

U. S. ALDERMAN

Surveyed August 30 1962, by *[Signature]*