
RECEIVED

T.5S.R.3W.W.M.

DEC 1 9 1994

WATER RESOURCES DEPT SALEM DREGON

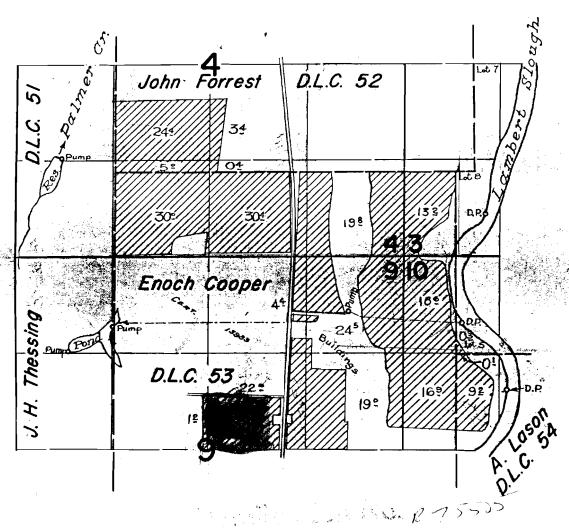

FINAL PROOF SURVEY

Application No. 37183 Permit No. 27687 IN NAME OF

U.S. ALDERMAN

Surveyed August 30 1962, by Lapelaox