


SEE MAP 9 E 33

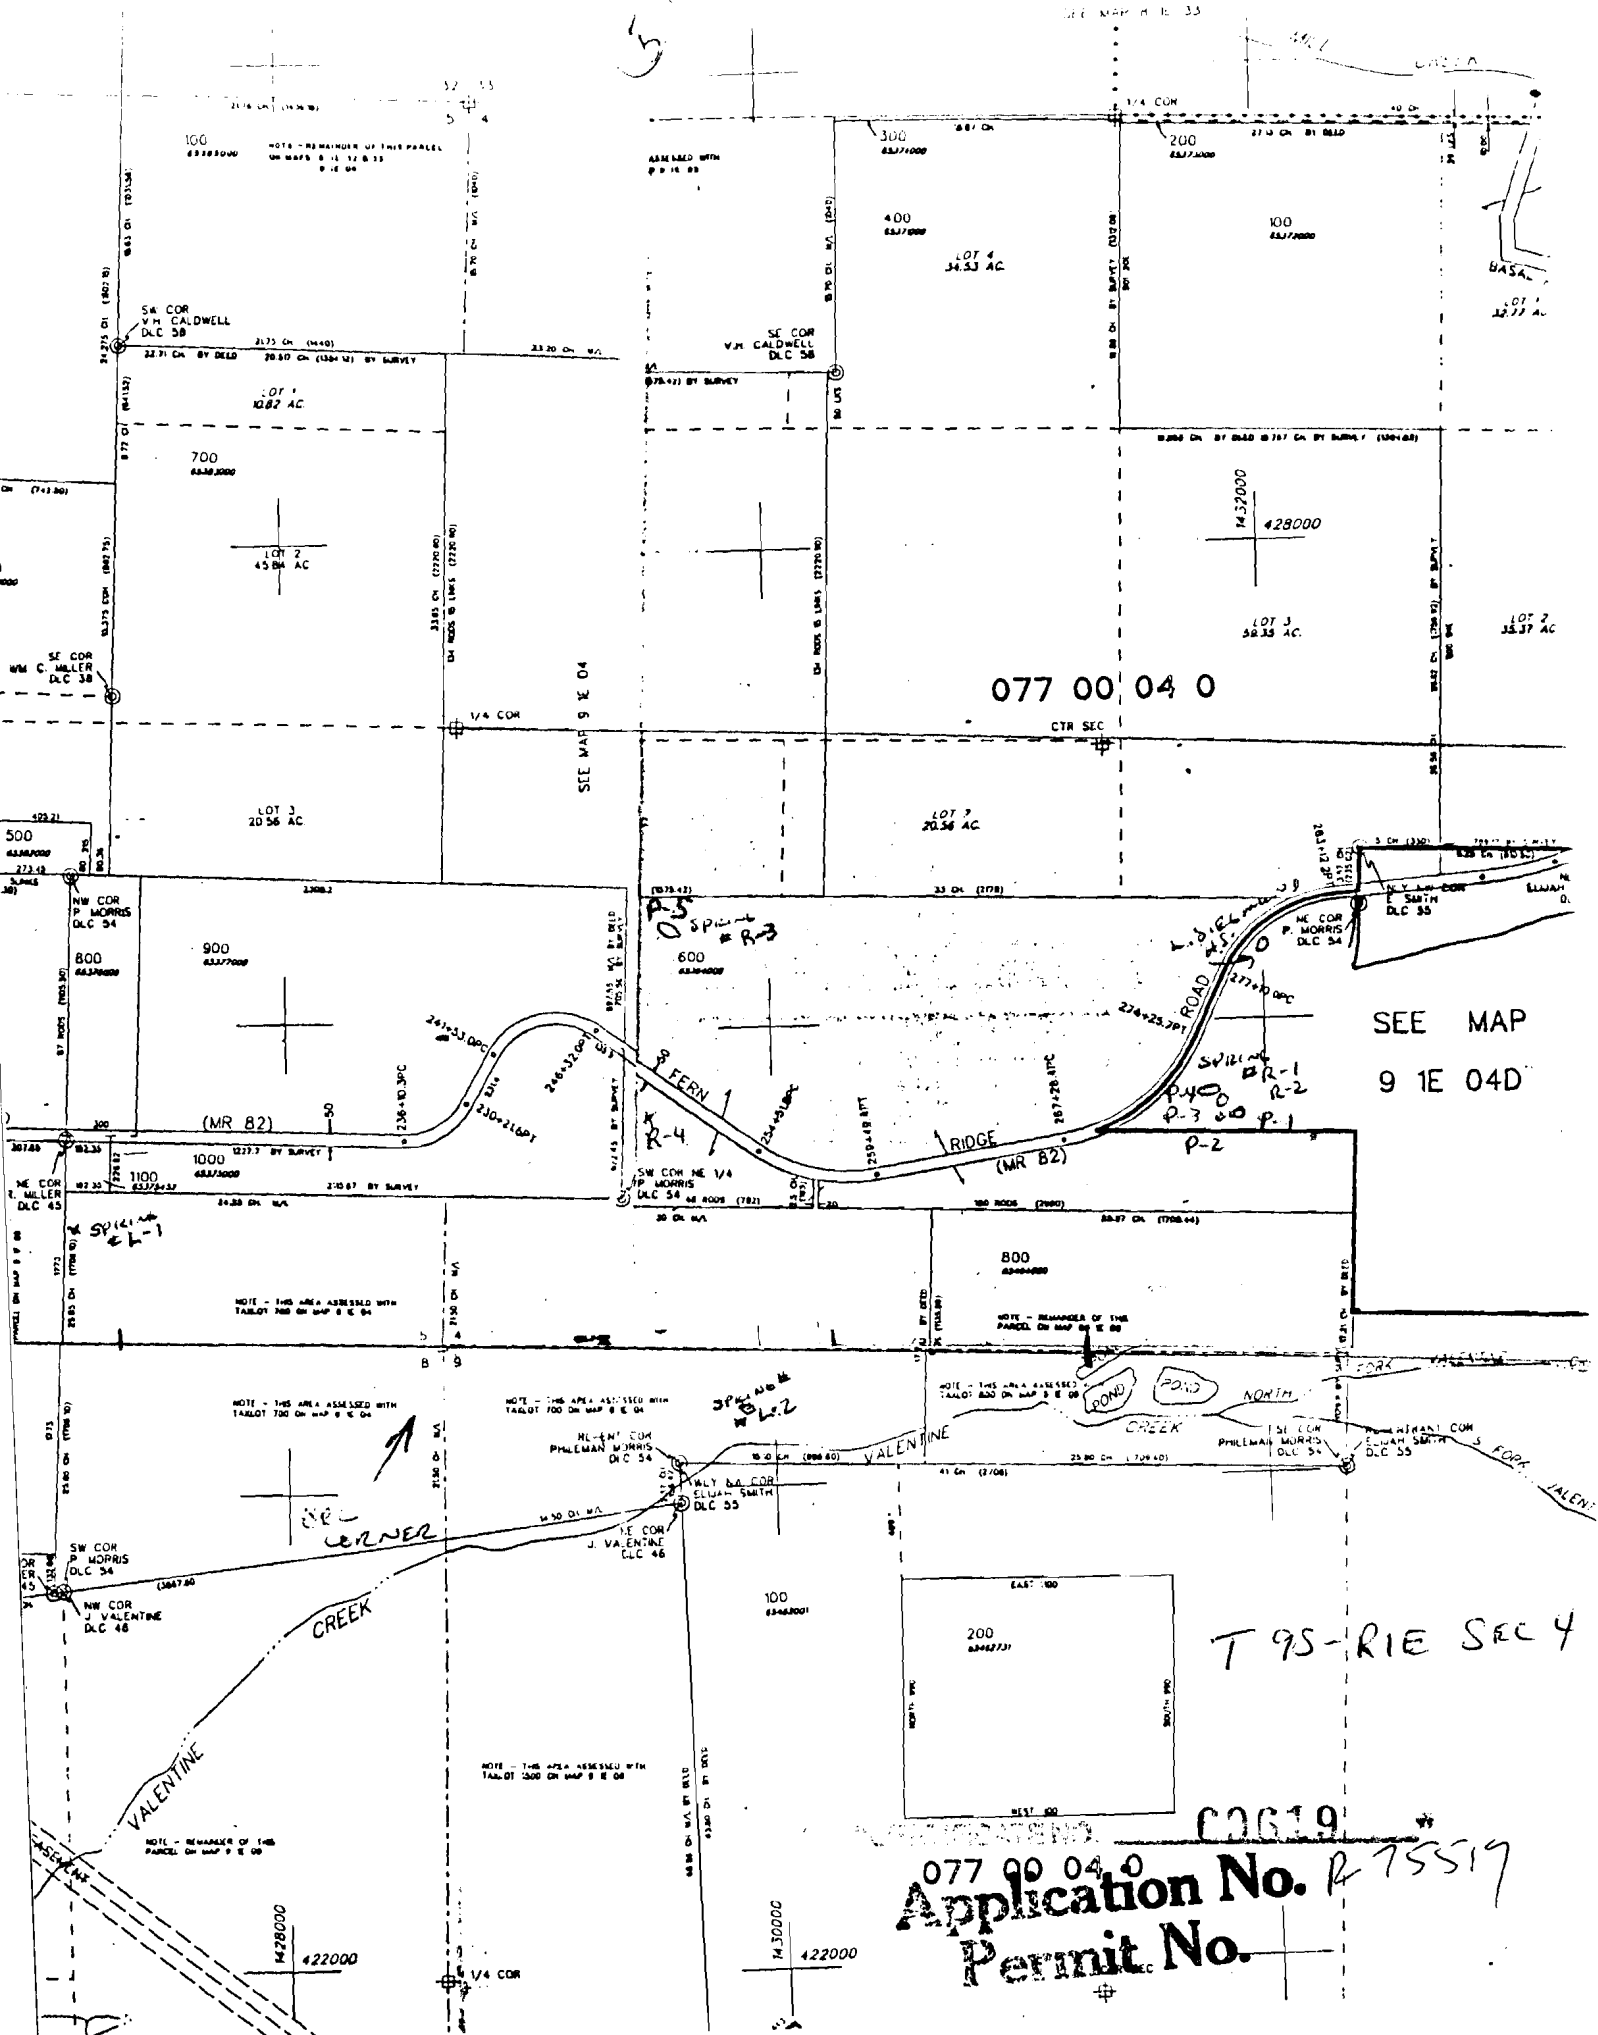

077 00 04 0

CTR SEC

SEE MAP 9 1E 04D

T 95-RIE SEC 4

Application No. R 75519
Permit No.

00619

1430000
422000

1420000
422000

5

100
6377000

NOTE - REMAINDER OF THIS PARCEL
ON MAPS 9 E 12 & 13
9 E 04

ASSESSED WITH
P 16 93

300
6377000

200
6377000

400
6377000

100
6377000

LOT 4
34.53 AC

LOT 1
10.82 AC

700
6377000

LOT 2
45.04 AC

1432000

428000

LOT 3
38.33 AC

LOT 2
35.37 AC

LOT 3
20.56 AC

LOT 3
20.56 AC

900
6377000

600
6377000

1000
6377000

800
6377000

NOTE - THIS AREA ASSESSED WITH
TABLOT 700 ON MAP 9 E 04

NOTE - THIS AREA ASSESSED WITH
TABLOT 700 ON MAP 9 E 04

NOTE - THIS AREA ASSESSED WITH
TABLOT 800 ON MAP 9 E 04

NOTE - REMAINDER OF THIS
PARCEL ON MAP 9 E 04

NOTE - THIS AREA ASSESSED WITH
TABLOT 1000 ON MAP 9 E 04




