


R-75525

"CERTIFICATE NO. 00021"

T. 7 S. R. 1 W. W. M.

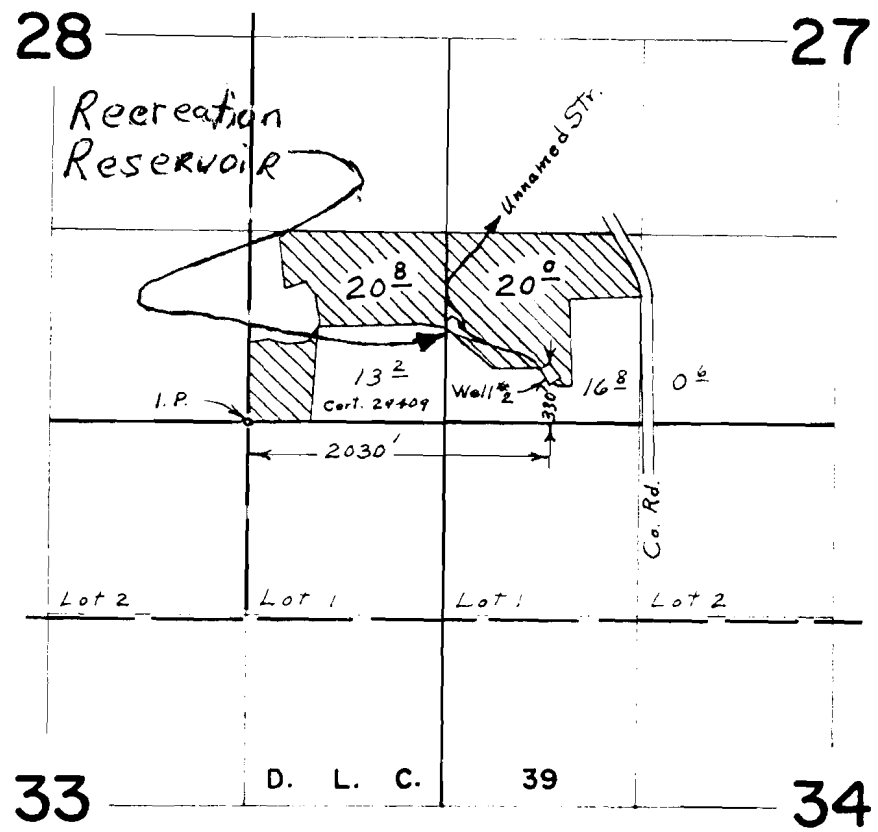

Application No. R 75525
Permit No.

FINAL PROOF SURVEY UNDER

Application No. G-2833 Permit No. G-2634
IN NAME OF

KEITH G. JOHNSON

Surveyed July 3, 1968, by L. E. Gauld