




App# R 75577
CERTIFICATE NO. 69636

UNITED STATES
DEPARTMENT OF THE INTERIOR
GEOLOGICAL SURVEY

HART MOUNTAIN NATIONAL ANTELOPE REFUGE

HB 2153 POND LOCATIONS

Application No R-75577
Permit No.
SWEDE KNOLL QUADRANGLE
OREGON-LAKE CO.
7.5 MINUTE SERIES (TOPOGRAPHIC)

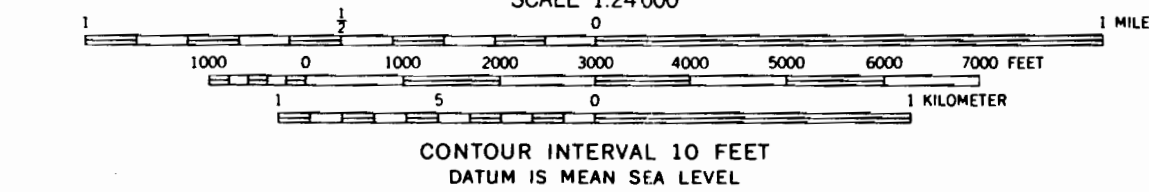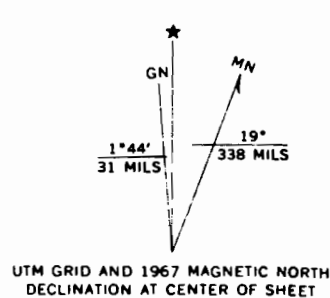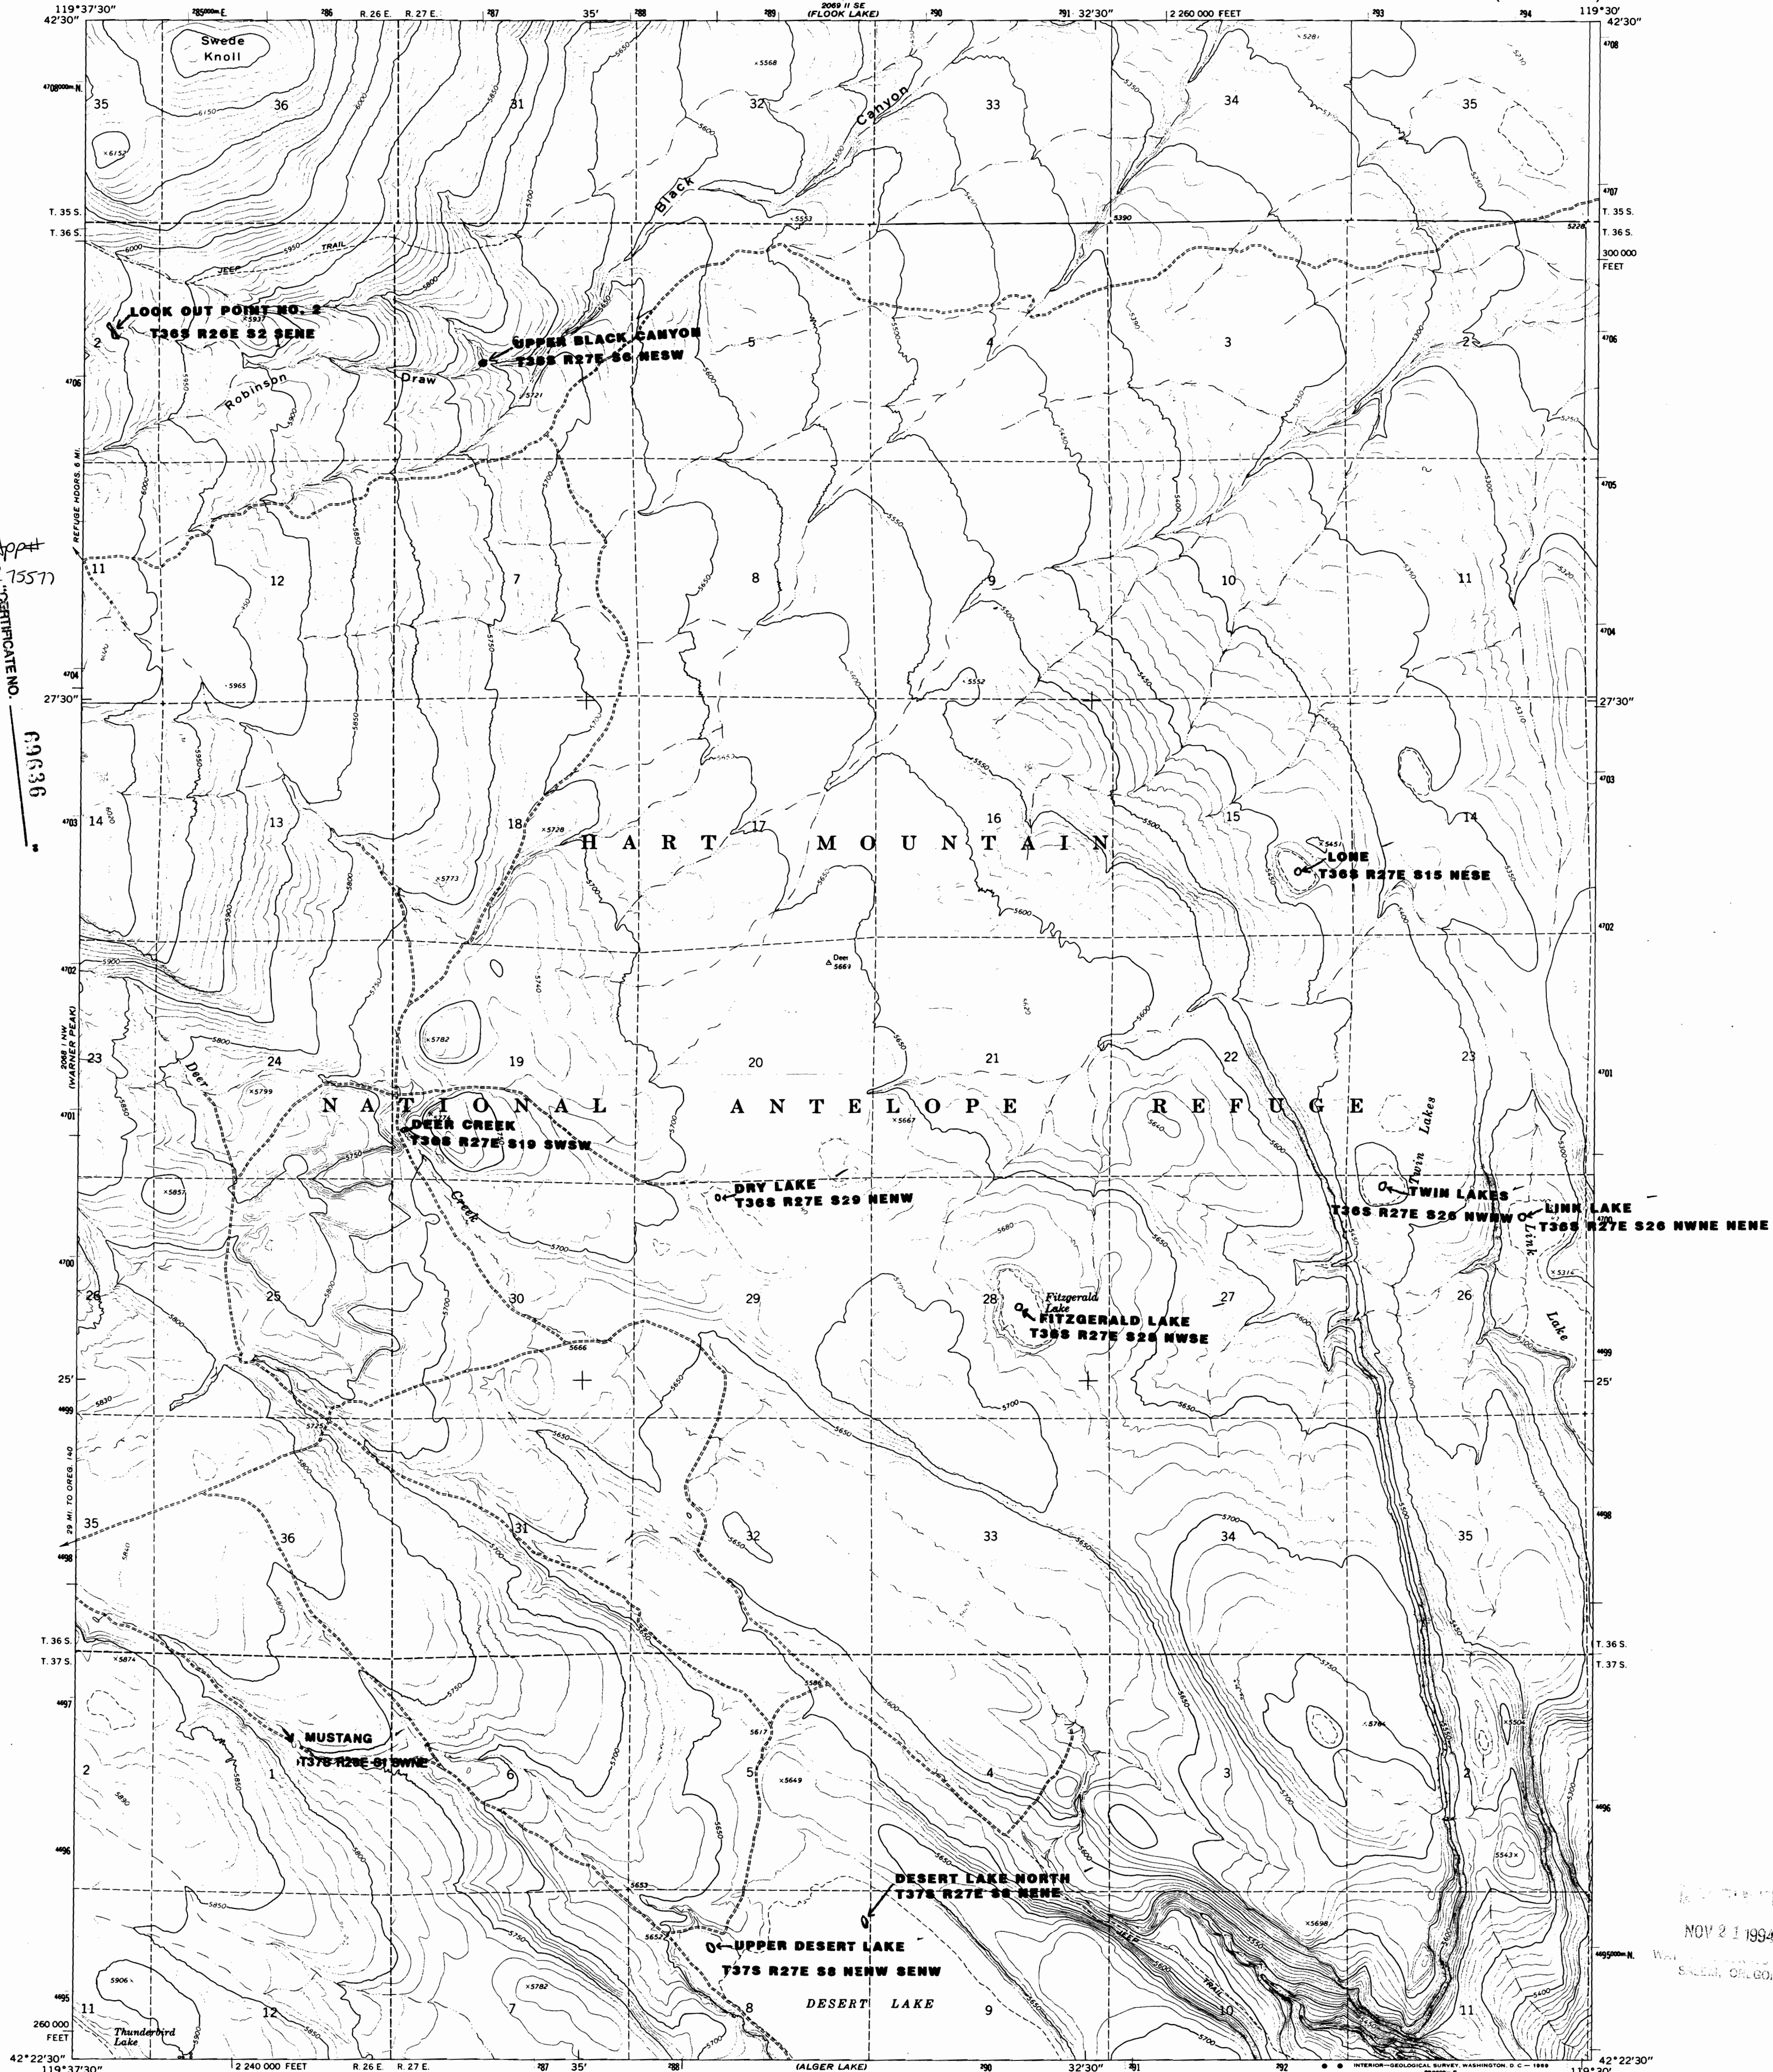

ROAD CLASSIFICATION
Unimproved dirt -----

SWEDE KNOLL, OREG.
N4222.5-W11930.7.5

1967