


UNITED STATES
DEPARTMENT OF THE INTERIOR
GEOLOGICAL SURVEY

HART MOUNTAIN NATIONAL ANTELOPE REFUGE



HB 2153 POND LOCATIONS

BLUEJOINT LAKE EAST QUADRANGLE
OREGON
7.5 MINUTE SERIES (TOPOGRAPHIC)

Application No. R-75582
Permit No. 69638
CERTIFICATE NO. 69638

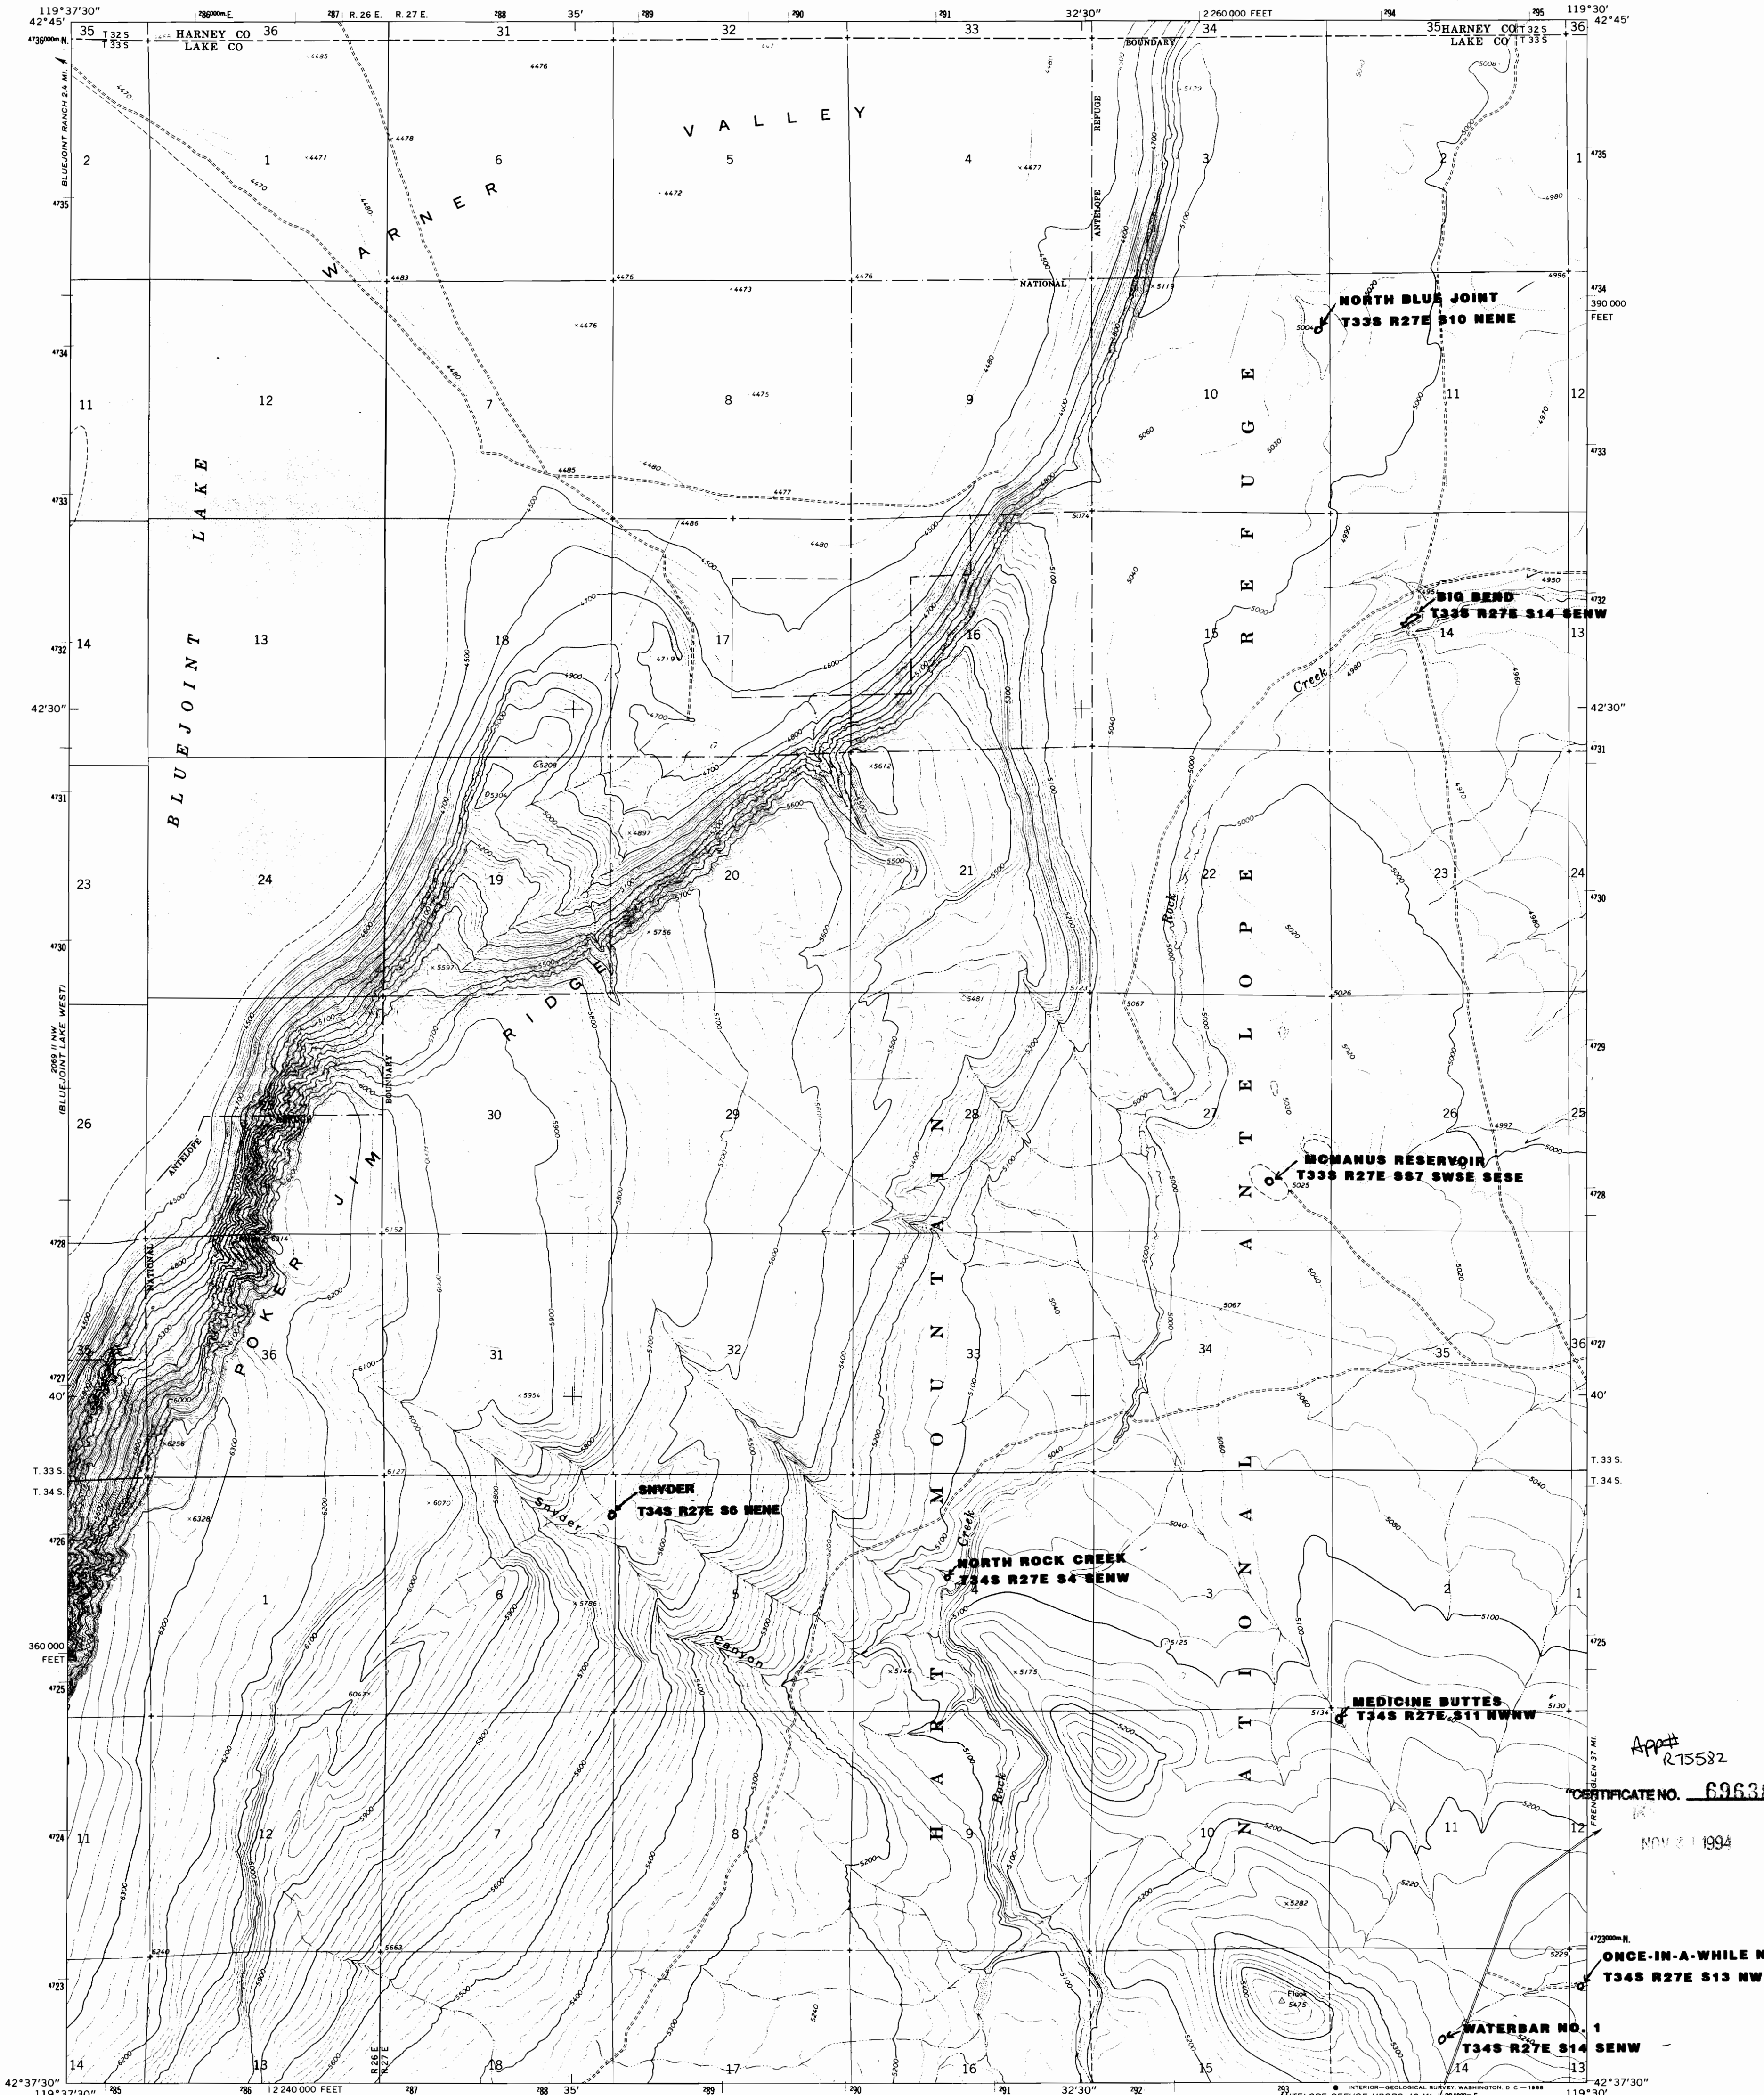

Mapped, edited, and published by the Geological Survey
Control by USGS and USC&GS
Topography by photogrammetric methods from aerial
photographs taken 1964. Field checked 1966
Polyconic projection. 1927 North American datum
10,000-foot grid based on Oregon coordinate system,
south zone
1000-meter Universal Transverse Mercator grid ticks,
zone 11, shown in blue
Fine red dashed lines indicate selected fence lines

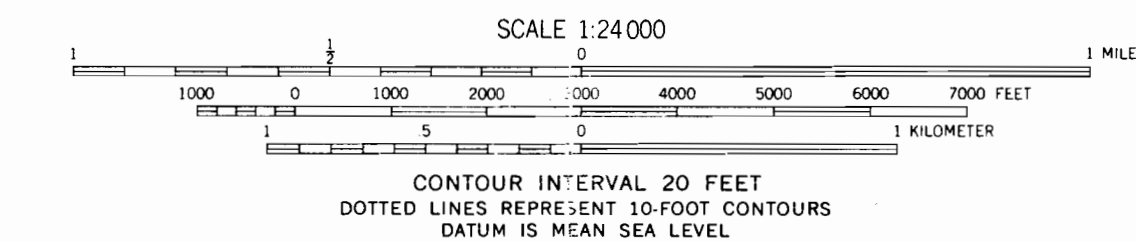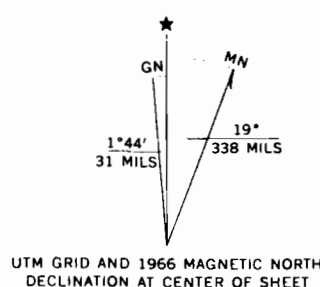

ROAD CLASSIFICATION
Light-duty Unimproved dirt

BLUEJOINT LAKE EAST, OREG.
N4237.5-W11930.7.5

1966

AMS 2000 11 NF-SERIES V802

App# R-75582
CERTIFICATE NO. 69638
NOV 21 1994
ONCE-IN-A-WHILE N
T34S R27E S13 NWI