


Office

UNITED STATES  
DEPARTMENT OF THE INTERIOR  
GEOLOGICAL SURVEY

FROG HOLLOW QUADRANGLE  
OREGON-WHEELER CO.  
7.5 MINUTE SERIES (TOPOGRAPHIC)

RECEIVED

DEC 27 1994  
WATER RESOURCES DEPT  
SALEM, OREGON

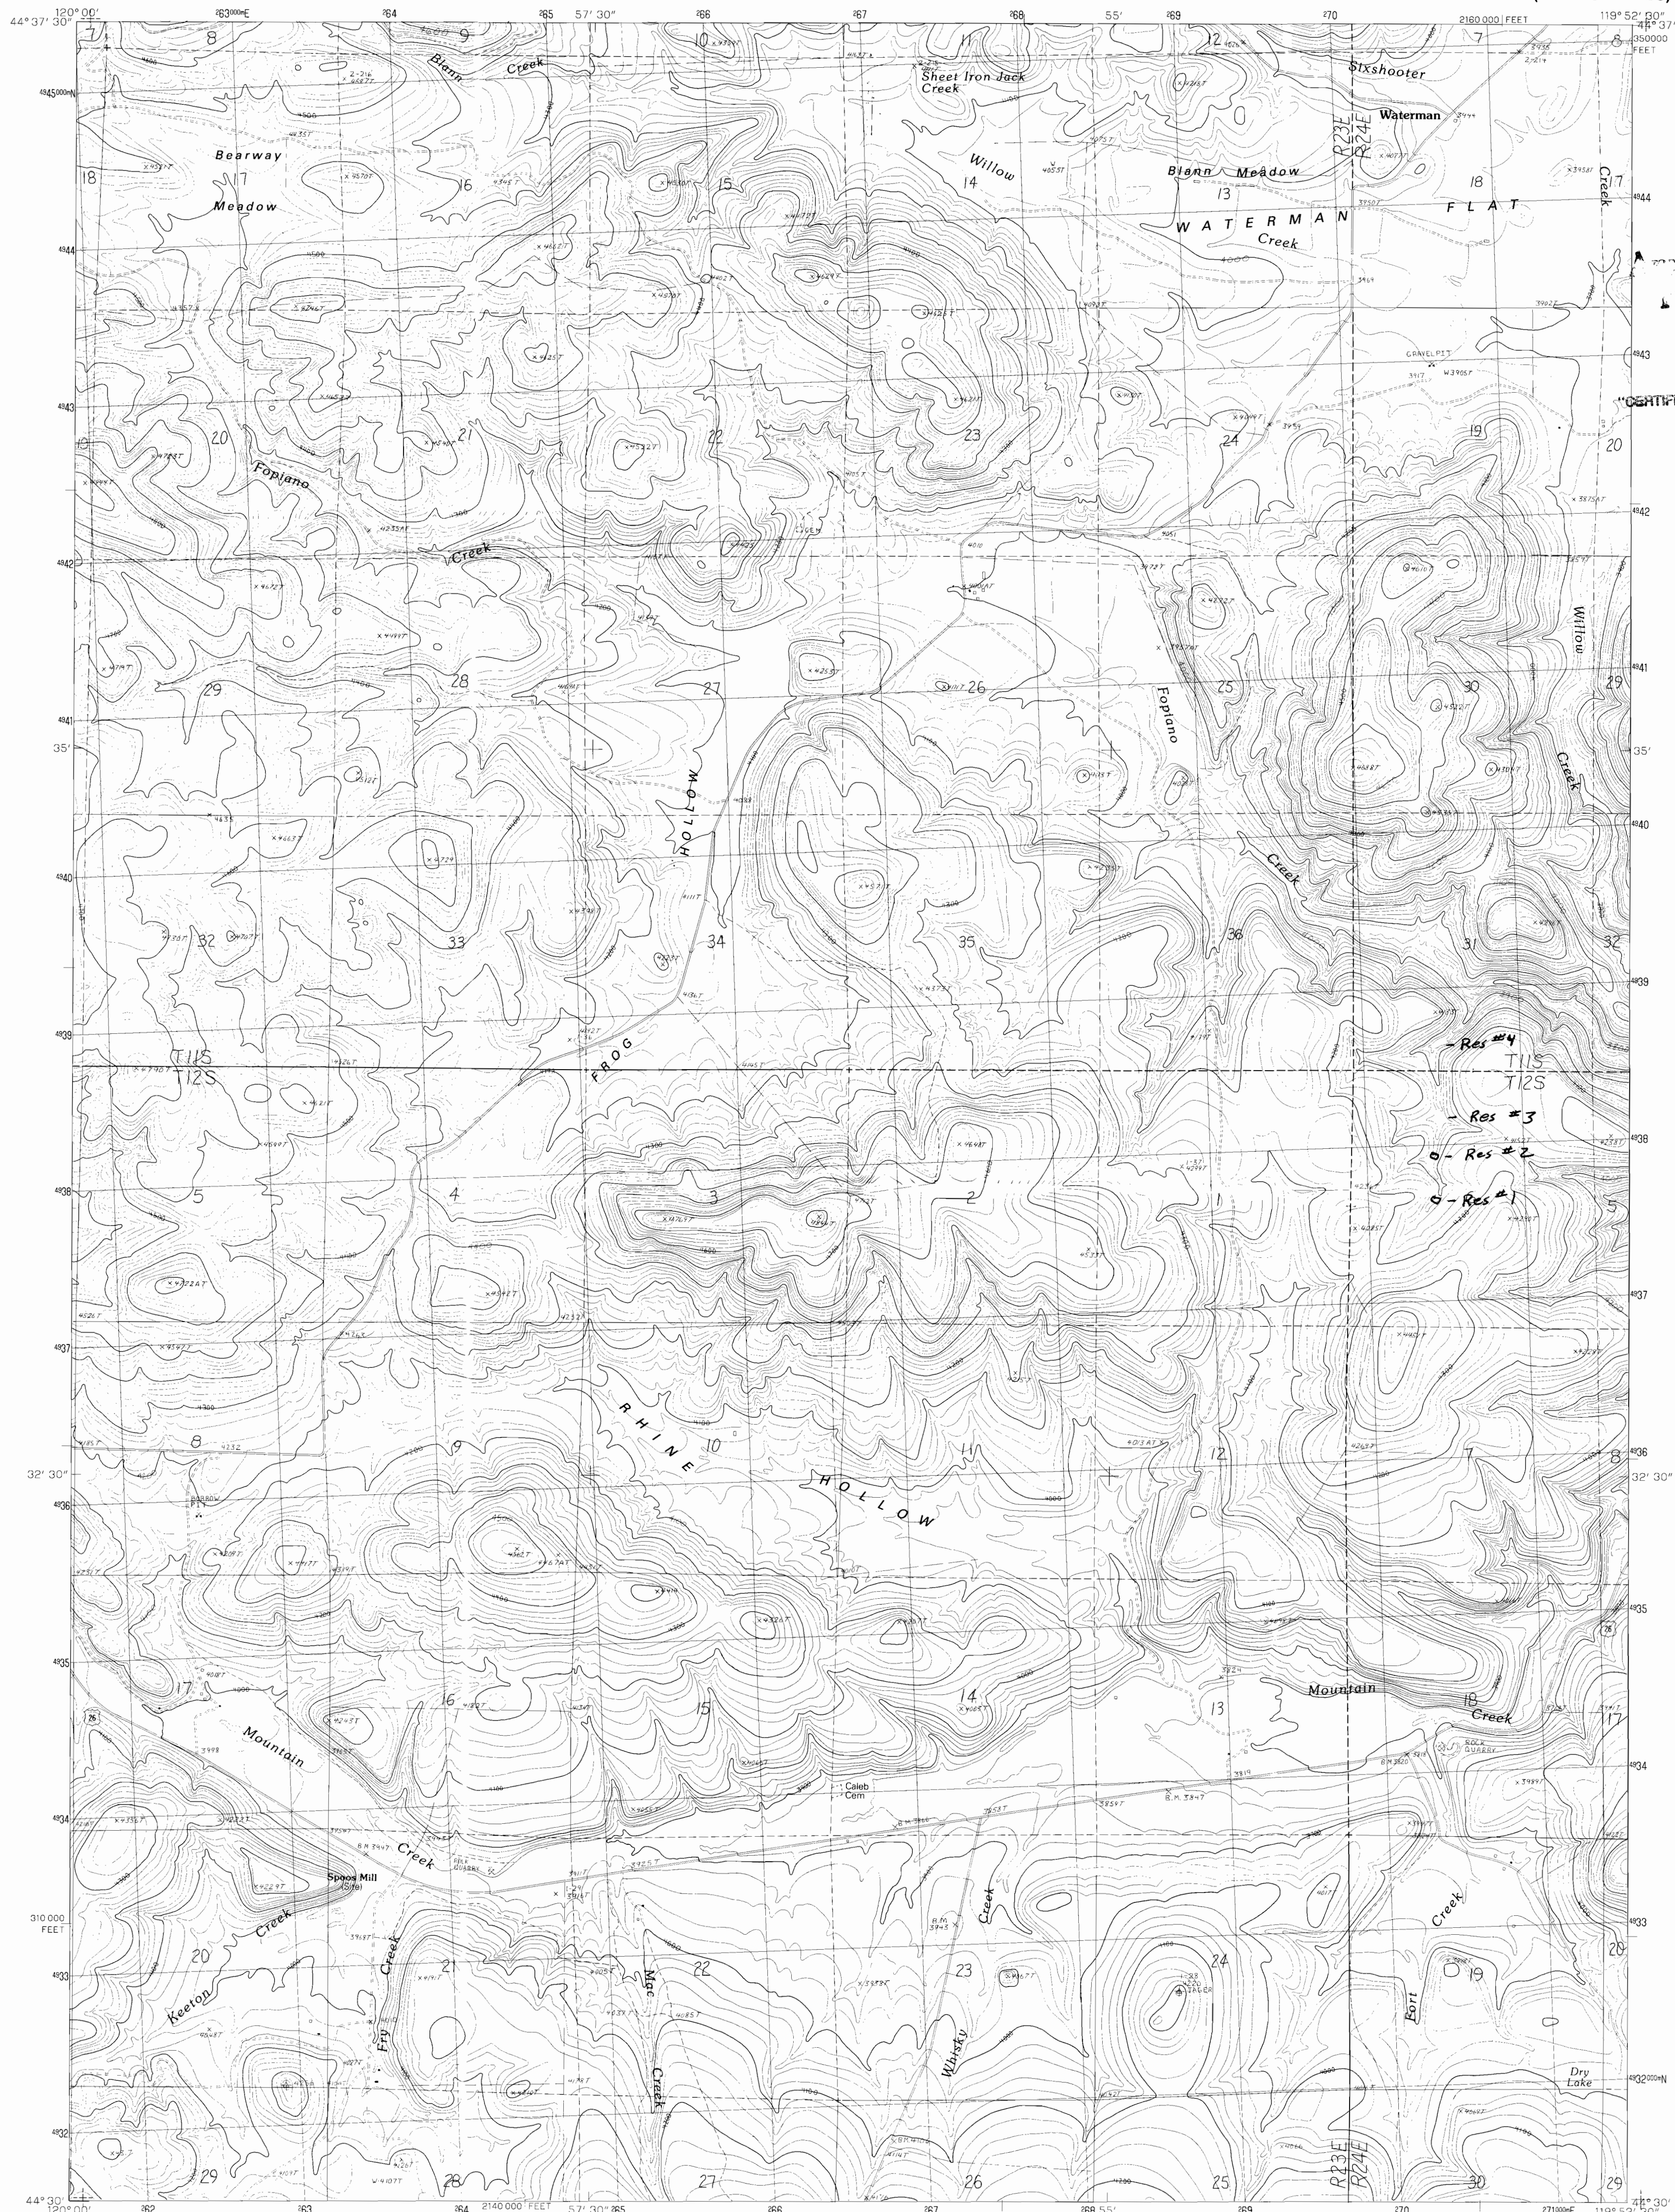


Section No. 15  
Sheet No.

CERTIFICATE NO. 09640

PRODUCED BY THE UNITED STATES GEOLOGICAL SURVEY  
CONTROL BY: USGS AND NOS/NOAA  
COMPILED FROM AERIAL PHOTOGRAPHS TAKEN: 1984  
FIELD CHECKED: 1987. MAP EDITED: 1990  
PROJECTION: LAMBERT CONFORMAL CONIC  
GRID: 1000-METER UNIVERSAL TRANSVERSE MERCATOR, ZONE 11  
10,000-FOOT STATE GRID TICS: OREGON, NORTH ZONE  
UTM GRID DECLINATION: 2° 04' WEST  
1990 MAGNETIC NORTH DECLINATION: 18° 00' EAST  
VERTICAL DATUM: NATIONAL GEODETIC VERTICAL DATUM OF 1929  
HORIZONTAL DATUM: 1927 NORTH AMERICAN DATUM  
To place on the predicted North American Datum of 1983,  
move the projection lines as shown by dashed corner ticks  
(19 meters north and 87 meters east)  
There may be private inholdings within the boundaries of any  
Federal or State reservations shown on this map

PROVISIONAL MAP  
Produced from original  
manuscript drawings. Infor-  
mation shown as of date of  
field check.

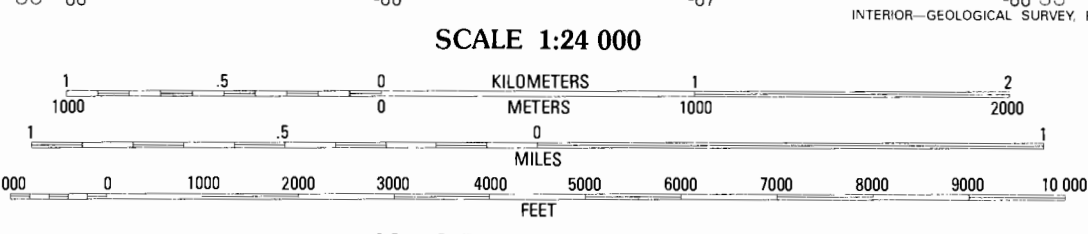

THIS MAP COMPLIES WITH NATIONAL MAP ACCURACY STANDARDS  
FOR SALE BY U.S. GEOLOGICAL SURVEY  
DENVER, COLORADO 80225, OR RESTON, VIRGINIA 22092

|   |   |                   |               |
|---|---|-------------------|---------------|
| 1 | 2 | 3                 | 1 Toney Butte |
| 4 | 5 | 2 Richmond        |               |
| 6 | 7 | 3 Johnson Heights |               |
|   |   | 4 Keyes Mountain  |               |
|   |   | 5 Tubb Spring     |               |
|   |   | 6 Peterson Point  |               |
|   |   | 7 Derr Meadows    |               |
|   |   | 8 Antone          |               |

ADJOINING 7.5 QUADRANGLE NAMES

ROAD LEGEND  
Improved Road  
Unimproved Road  
Trail  
Interstate Route U. S. Route State Route

FROG HOLLOW, OREGON  
PROVISIONAL EDITION 1990  
44119-E8-TF-024

# 2

