


3883

T. 28 S. R. 14 W. W. M.

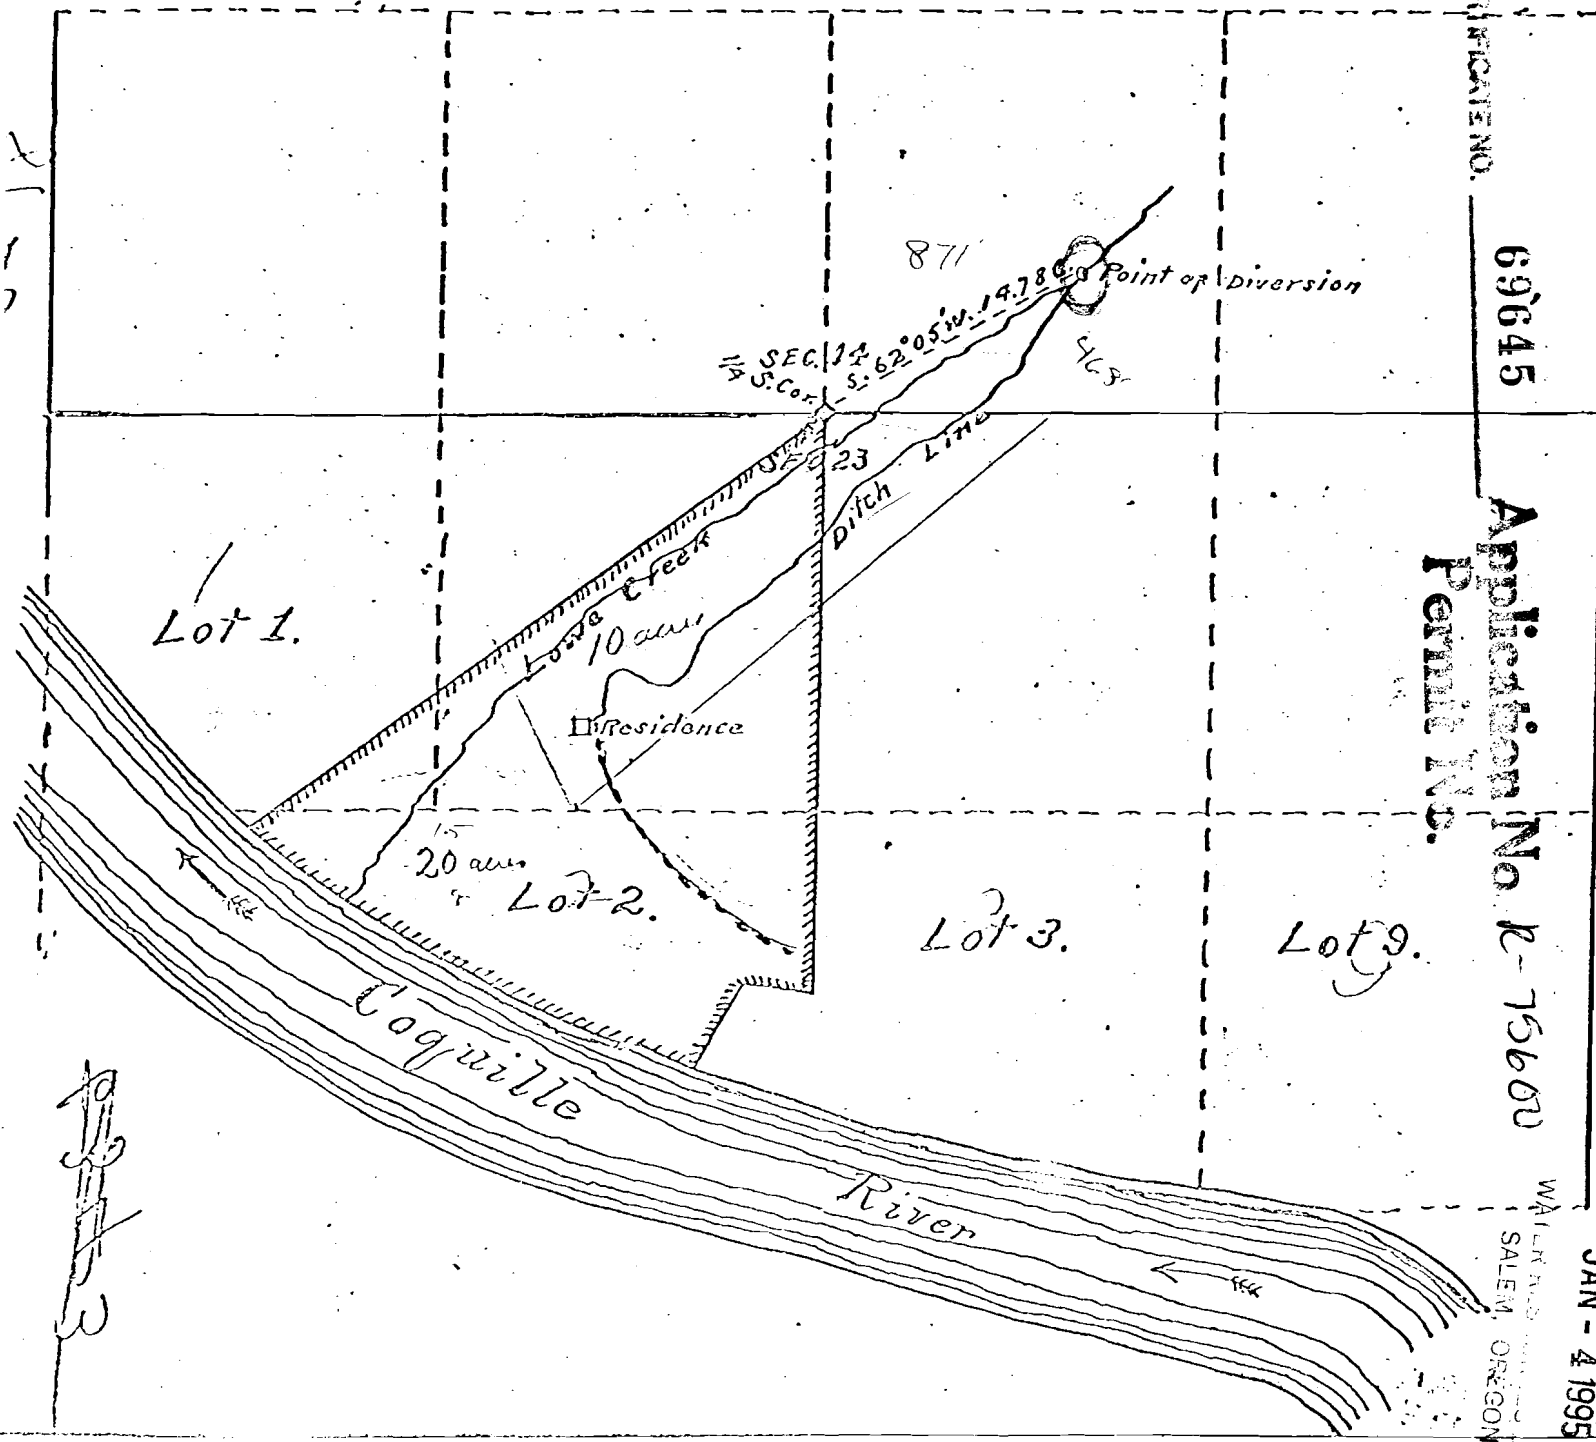

CERTIFICATE NO.

69645

Application No. R-75600
Permit No.

- SKE
- Accompanying App
 - to divert water pr
 - from the S.W. 1/4 of
 - to the N.W. 1/4 of

Application No.
Permit No. 3

T. 28 S., R. 14 W., Sec. 23
Scale = 1" = 10 ch.

Application No. 6343
Permit No.

Application No. 8126
Permit No. 5248

Scale 1 Inch

OFFICE OF STATE ENGINEER

RECEIVED

NOV 20 1913

SALEM, OREGON


JAN - 4 1995

SALEM, OREGON

5248

TIMBER CRUISE REPORT MAP

SW1/4 of the SE1/4 Section 14 T28S - R14W W.M.
Coos County, Oregon

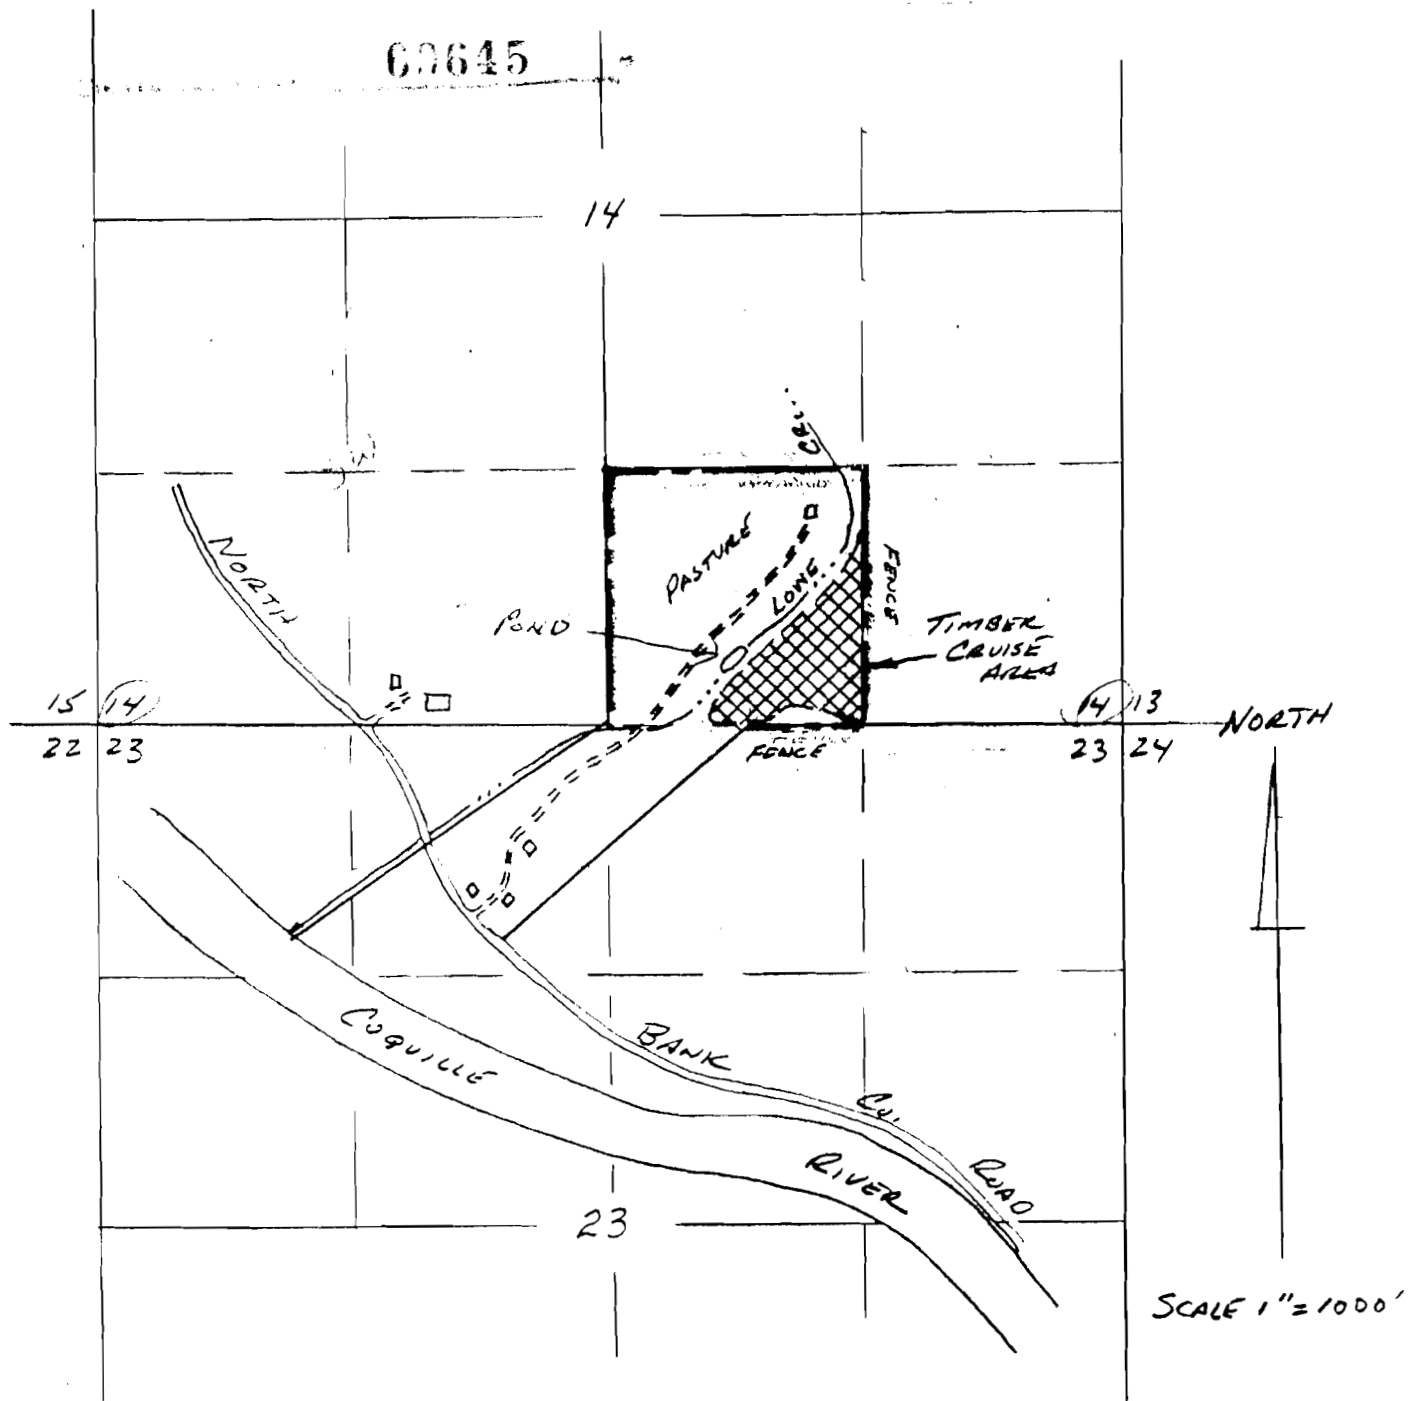

R-15000