

BY:

12-15-94 12:29PM

UMPQUA TITLE-

503 863 3100: # 1/

94 12:30PM

UMPQUA TITLE-


503 863 3100: # 2/ 2

444-28



Post-It™ brand fax transmittal memo (757) 4 of pages 2

To: <u>Mr. & Mrs. Henderson</u>	From: <u>UMPQUA</u>
Co: <u>661 W. 1st St.</u>	Co: <u>UMPQUA</u>
Dept: <u>Box 372</u>	Phone: <u>503-863-7210</u>
Fax: <u>503-863-7210</u>	Fax: <u>503-863-7210</u>

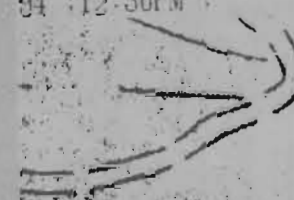


RECEIVED

DEC 29 1994

WATER RESOURCES DEP
SALEM, OREGON

19

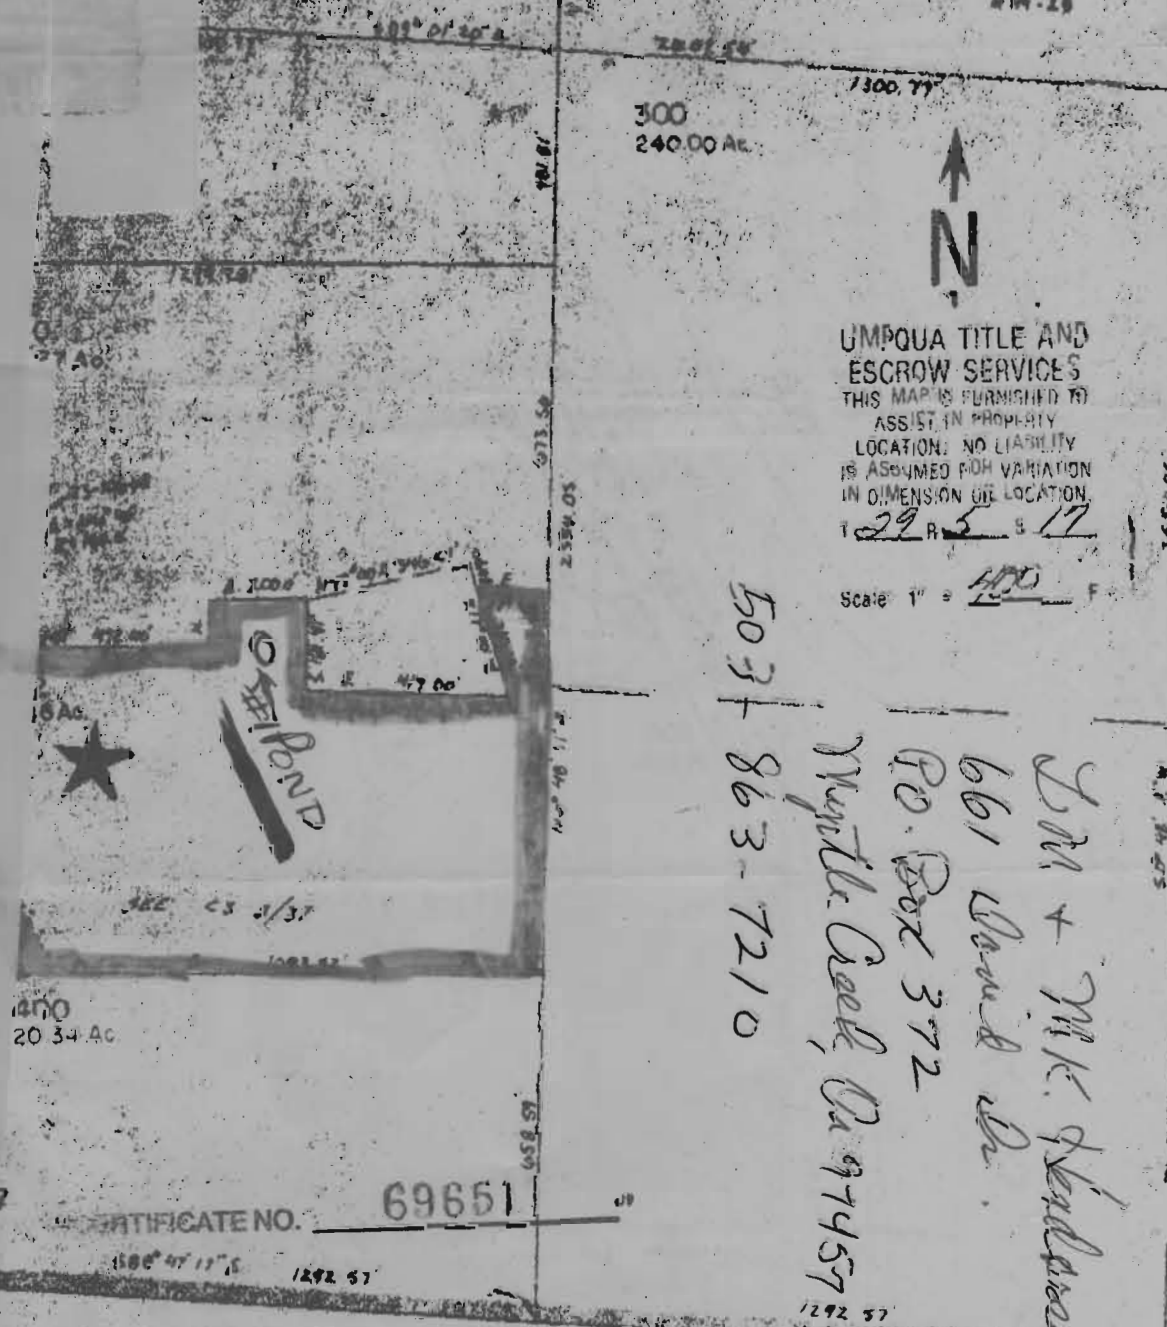

CERTIFICATE NO. 69651

Application No. R-75606
Permit No.

503-863-7210
Mr. & Mrs. Henderson
Box 372
