

R-75613


CERTIFICATE NO. 00056

U'REN
14001 WILLAMINA CK RD
WILLAMINA, OR
97396
(503) 876-3086

SEE SEC 5 7 02

SEE SEC 5 6 06

2 1
11 12

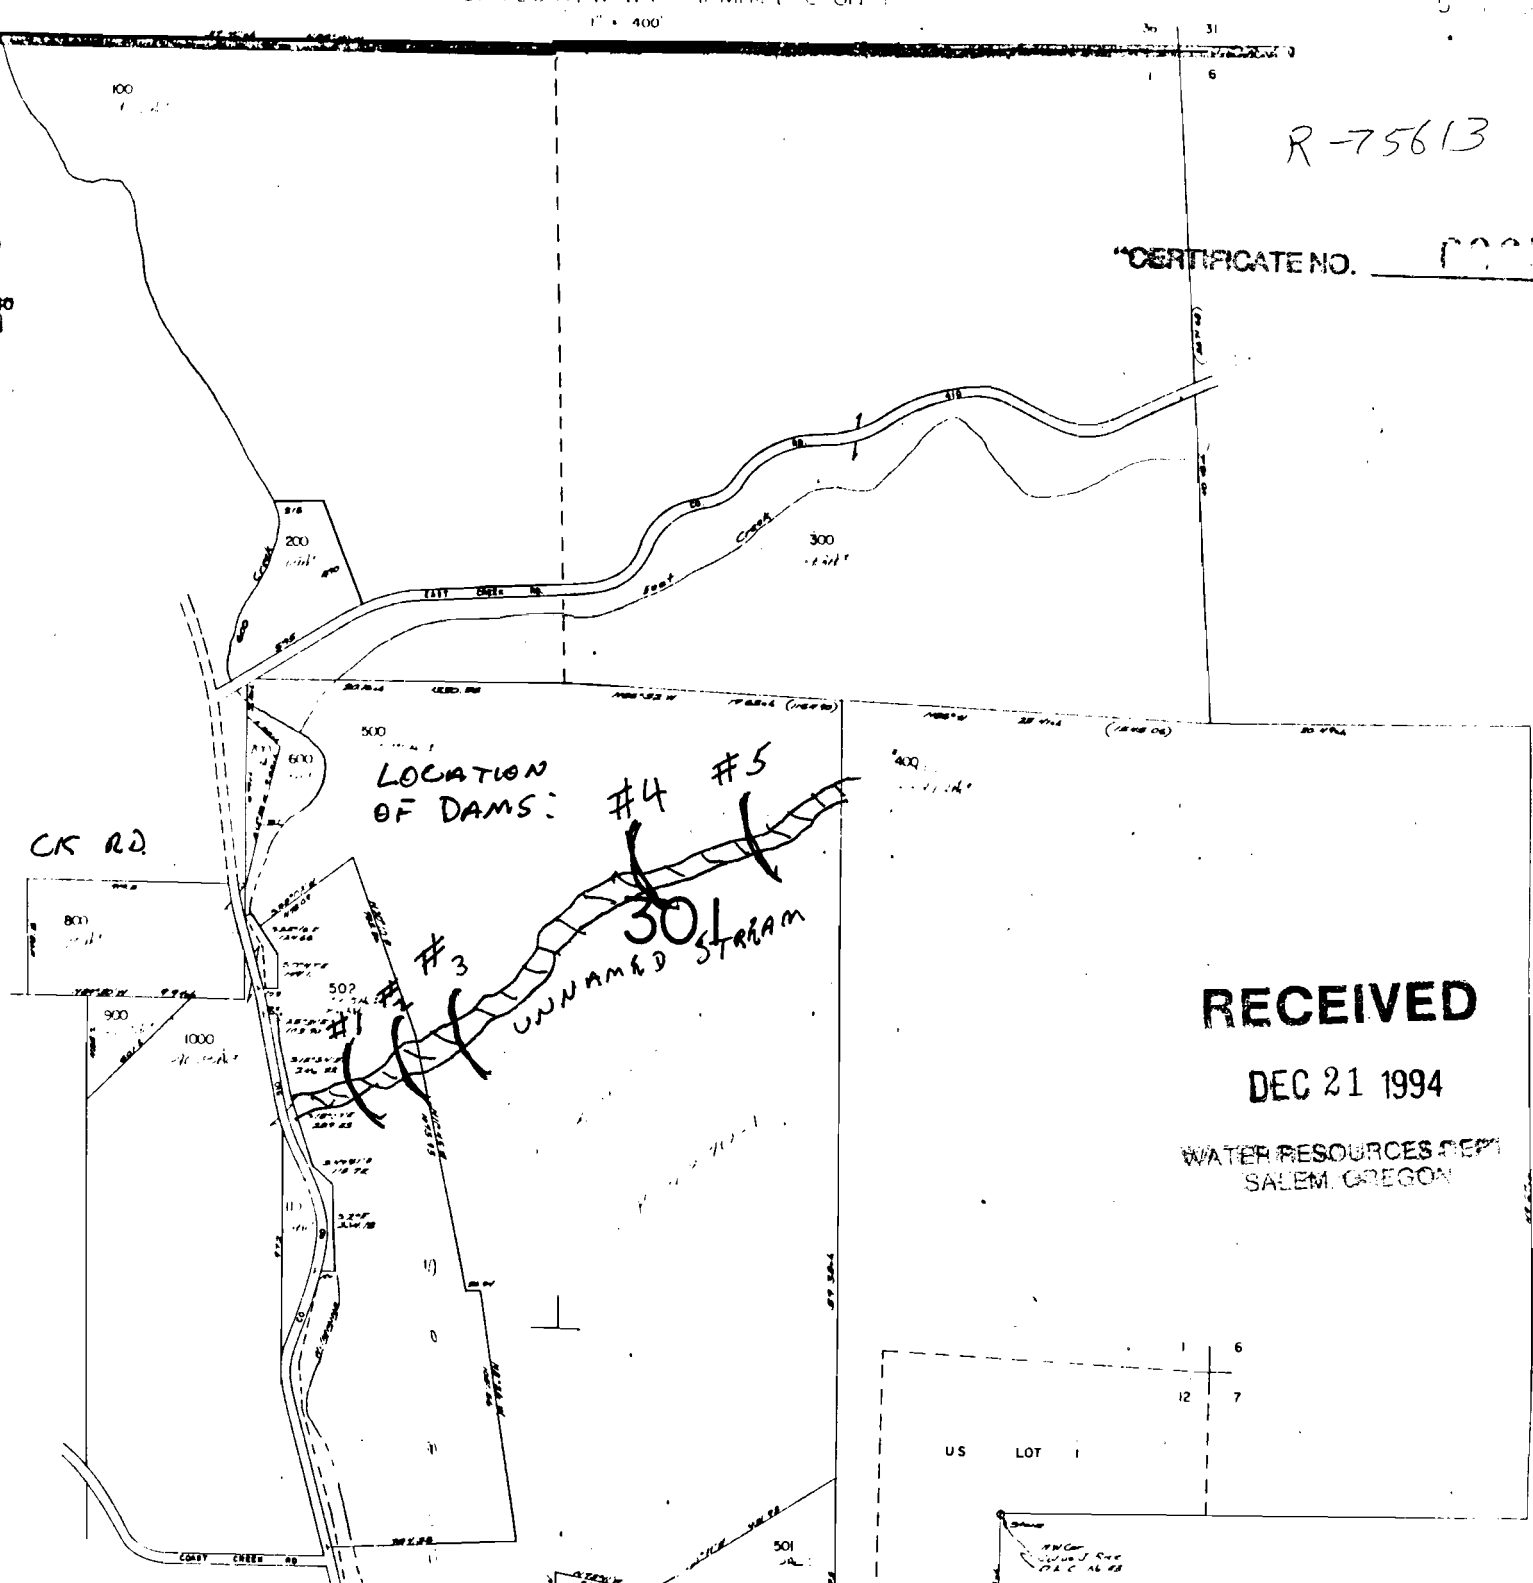

LOCATION OF DAMS: #4 #5
#3
#1
UNNAMED STREAM

RECEIVED
DEC 21 1994
WATER RESOURCES DEPT
SALEM, OREGON

1 6
12 7
US LOT 1