


RECEIVED

DEC 27 1994

SOURCES DEP  
REGON

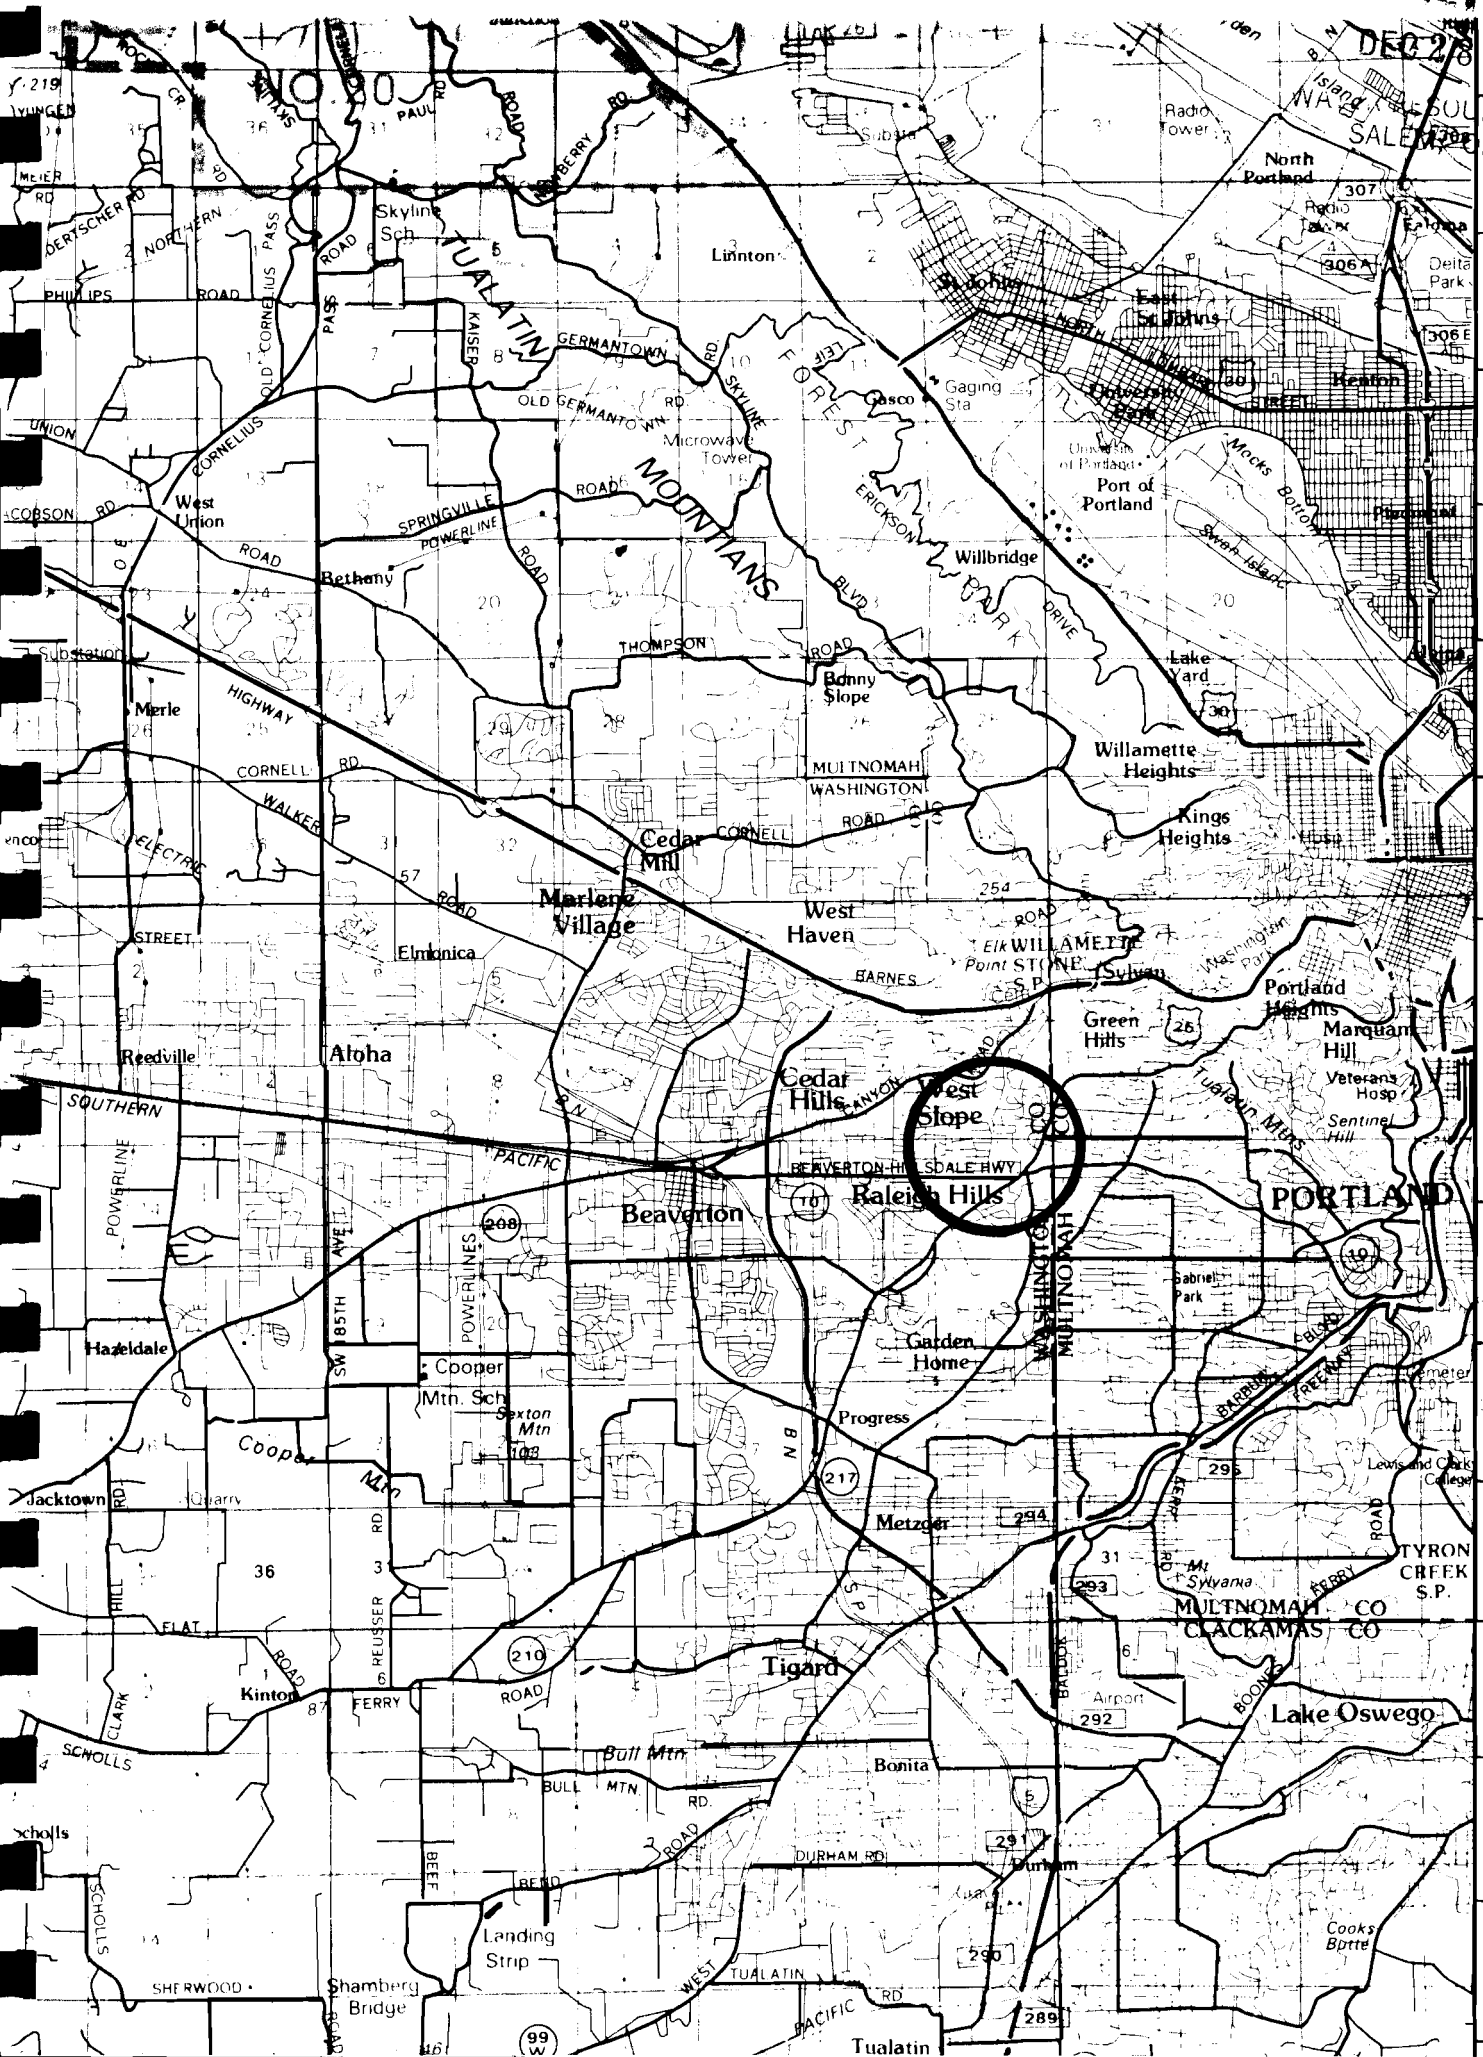

T. 1 N.  
CERTIFICATE NO.

69660

45  
30'

T. 1 S.

75014

T. 2 S.

72

1952-1953

# GEOLOGICAL

F0060

122° 45'

CERTIFICATE NO. 520000m. E.

SYL

45° 30'

038000m. N.



scale: 1:6,000

LLSBORO 13 MI.  
AVERTON 2.7 MI.

