

DEC 19 1994

DEC 04 1994


Application No. Permit No.



THIS SKETCH IS FOR LOCATION PURPOSES ONLY AND NO LIABILITY IS ASSUMED FOR ANY VARIATIONS DETERMINED BY SURVEY JOSEPHINE COUNTY TITLE

1" = 400'

IP 35 6 33

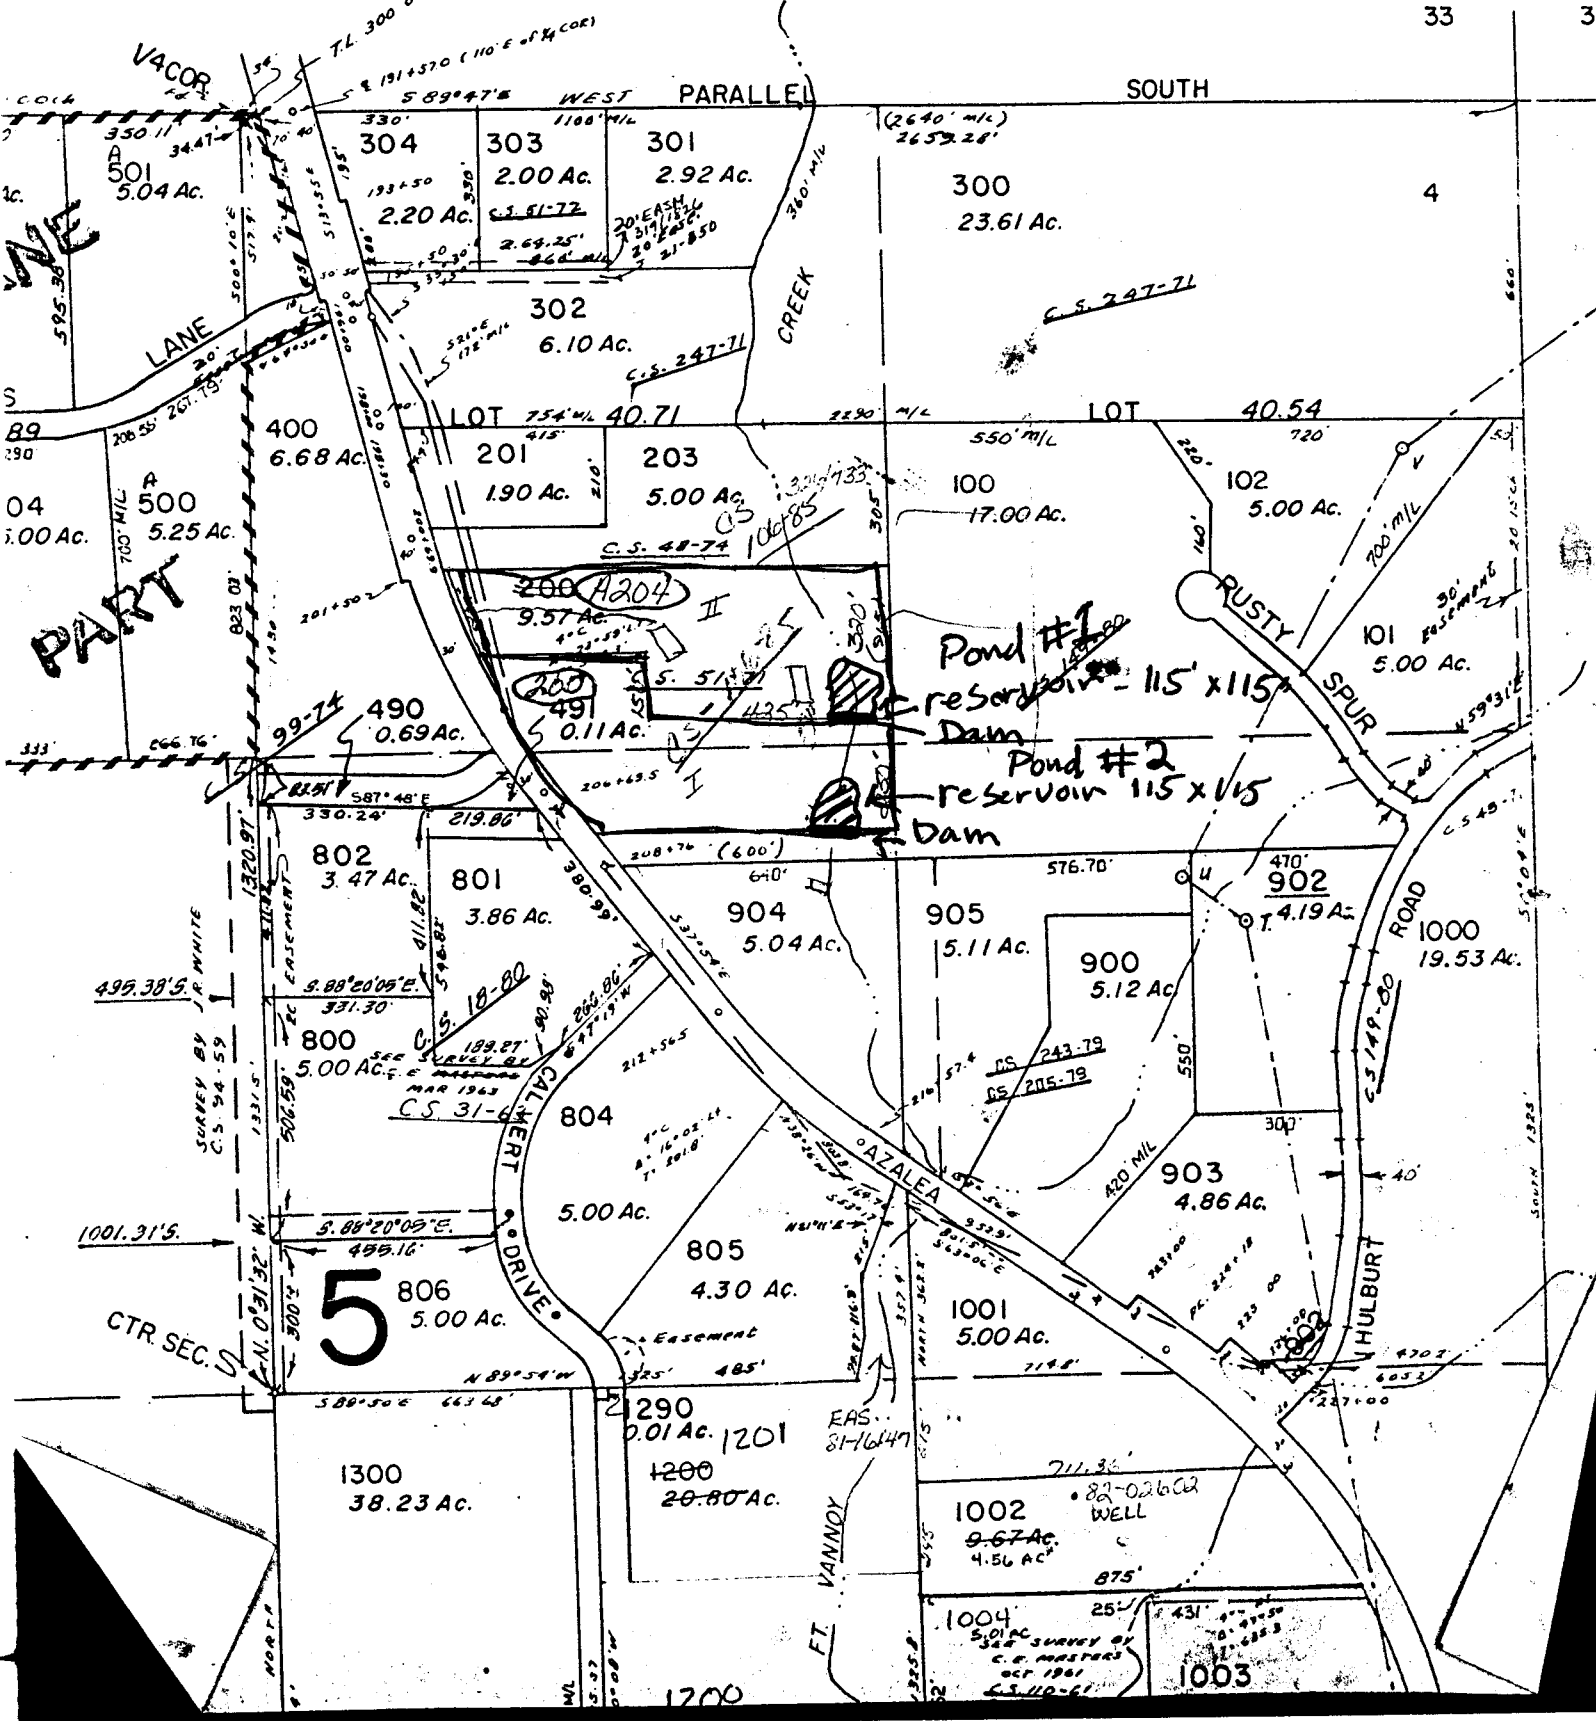

ME PART

R7562

33 3