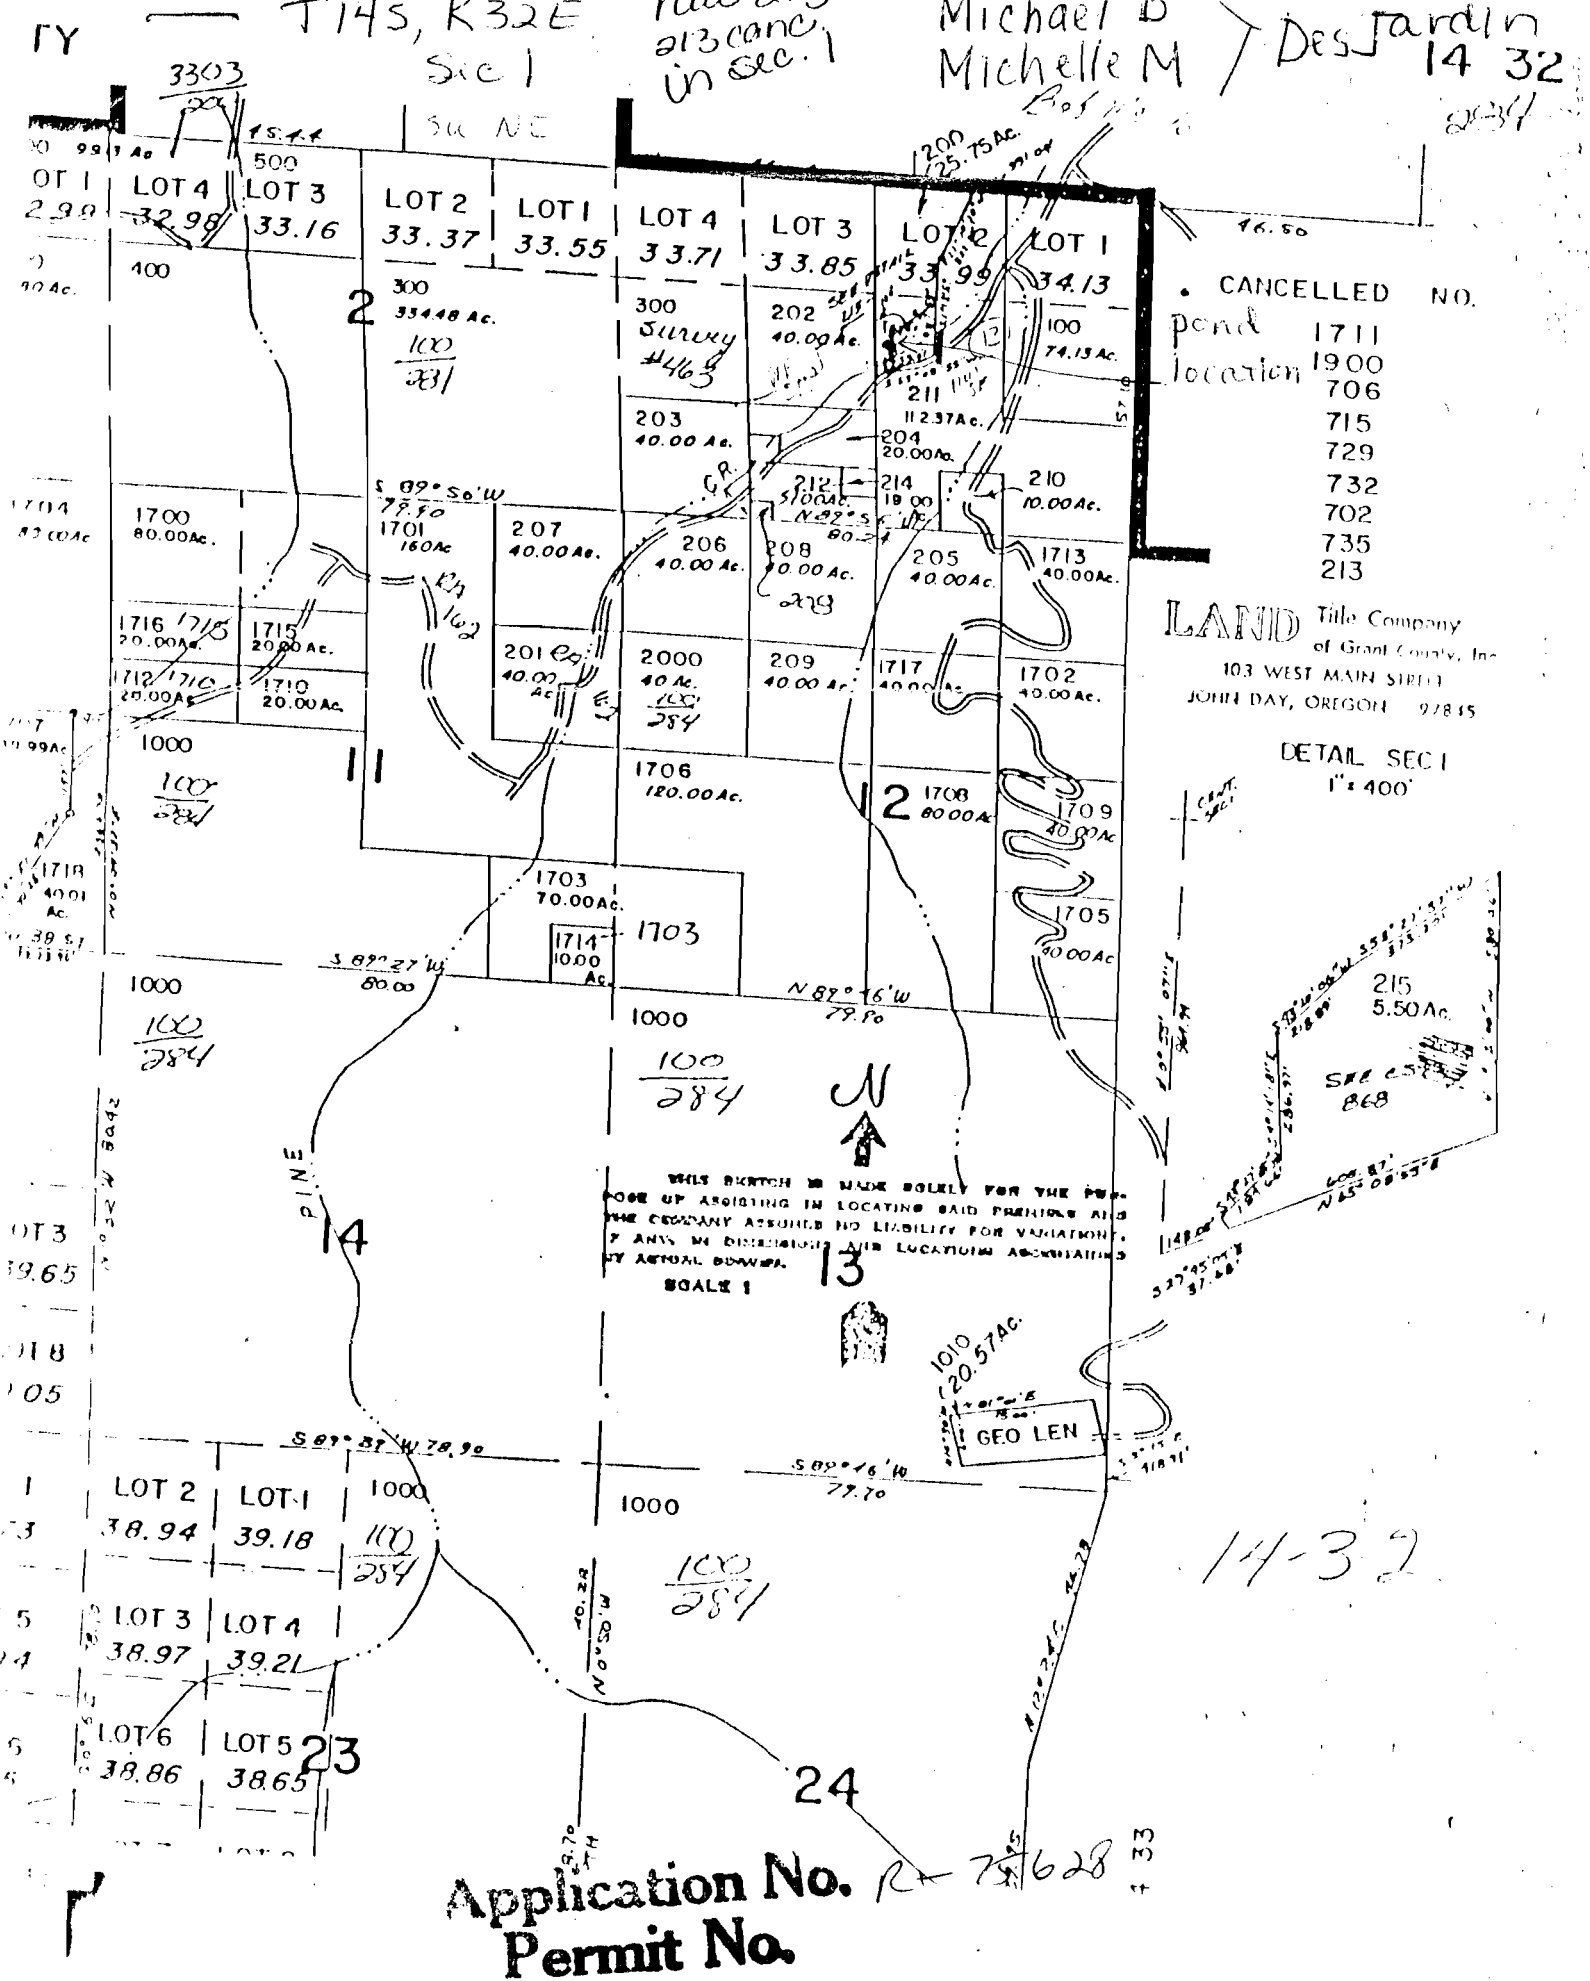

Application No. R-75628
Permit No.